

LAYOUT 3/13 + 3/21/2013 INSP 4 _____

INSP 2 _____ INSP 5 _____

INSP 3 _____ INSP 6 _____

ISSUE DATE: _____

PERMIT

P 544553

APPROVAL DATE: 3/22/2013

A 544553

ON-SITE SEWAGE DISPOSAL SYSTEM HOWARD COUNTY HEALTH DEPARTMENT BUREAU OF ENVIRONMENTAL HEALTH

IS PERMITTED TO INSTALL ☒ ALTER ☒

ADDRESS: _____ PHONE NUMBER: _____

SUBDIVISION: _____ LOT NUMBER: _____

ADDRESS: 11439 Rowley Road PROPERTY OWNER: _____

SEPTIC TANK CAPACITY (GALLONS): _____ OUTLET BAFFLE FILTER REQUIRED ☐

PUMP CHAMBER CAPACITY (GALLONS): _____ COMPARTMENTED TANK REQUIRED ☐

NUMBER OF BEDROOMS: 4

SQUARE FEET PER BEDROOM: _____

LINEAR FEET OF TRENCH REQUIRED: _____

TRENCHES:	Trench to be _____ feet wide. Inlet _____ feet below original grade. Bottom maximum depth _____ feet below original grade. Effective area begins at _____ feet below original grade. _____ feet of stone below distribution pipe.
LOCATION:	
NOTES:	

PLANS APPROVED: B. Baker DATE: 3/13/2013

NOTE: PERMIT VOID AFTER 2 YEARS

NOTE: CONTRACTOR RESPONSIBLE FOR SCHEDULING A PRE-CONSTRUCTION INSPECTION FOR ALL INSTALLATIONS


NOTE: WATERTIGHT SEPTIC TANKS REQUIRED

NOTE: ALL PARTS OF SEPTIC SYSTEM SHALL BE 100 FEET FROM ANY WATER WELL

NOTE: MANHOLE RISERS REQUIRED ON ALL SEPTIC TANKS AND PUMP CHAMBERS UNLESS SPECIFICALLY AUTHORIZED

NEITHER THE HOWARD COUNTY COUNCIL NOR THE HEALTH DEPARTMENT IS
RESPONSIBLE FOR THE SUCCESSFUL OPERATION OF ANY SYSTEM
PERMITTEE RESPONSIBLE FOR OBTAINING FINAL APPROVAL ON THIS PERMIT
CALL 410-313-2640 FOR INSPECTION OF SEPTIC SYSTEM

NOT TO SCALE

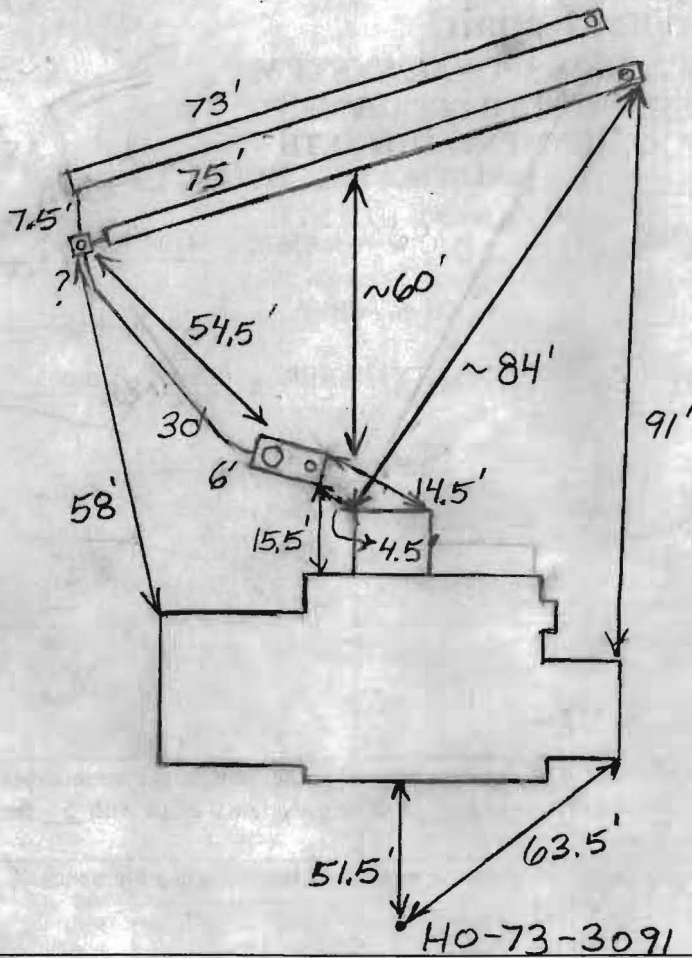

TRENCH/DRAINFIELD DATA
 WIDTH 2' INLET 4' BOTTOM 9'

NUMBER OF TRENCHES 2
 TOTAL LENGTH 148'
 ABSORPTION AREA 740
 DISTRIBUTION BOX LEVEL Levelers
 DISTRIBUTION BOX BAFFLE Yes
 DISTRIBUTION BOX PORT Yes

SEPTIC TANK DATA
 SEPTIC TANK I LEVEL Yes
 MANUFACTURER ?
 CAPACITY ? GAL
 SEAM LOC Midseam
 TANK LID DEPTH 1.5'-2'
 BAFFLES Yes
 BAFFLE FILTER No
 MANHOLE LOC Rear
 6" PORT LOC Front
 WATERTIGHT TEST No
 SLOTTED No
 DATE ON LID Dry

PUMP/SEPTIC TANK LEVEL N/A
 MANUFACTURER
 CAPACITY GAL
 SEAM LOC
 TANK LID DEPTH
 BAFFLES
 BAFFLE FILTER
 MANHOLE LOC
 6" PORT LOC
 WATERTIGHT TEST
 SLOTTED
 DATE ON LID

PRE-CONSTRUCTION:

3/13/2013 Install two 75' trenches on contour above test hole (A). Keep 100' from neighbor's well. (BB)
 3/21/2013 Trenches laid. (BB)

INSTALLATION:

3/22/2013 System finished. O.K. to backfill. (BB)

FINAL INSPECTOR

B. Baker


DATE OF APPROVAL

3/22/2013



MADE IN U.S.A.

10 X 10 PER INCH

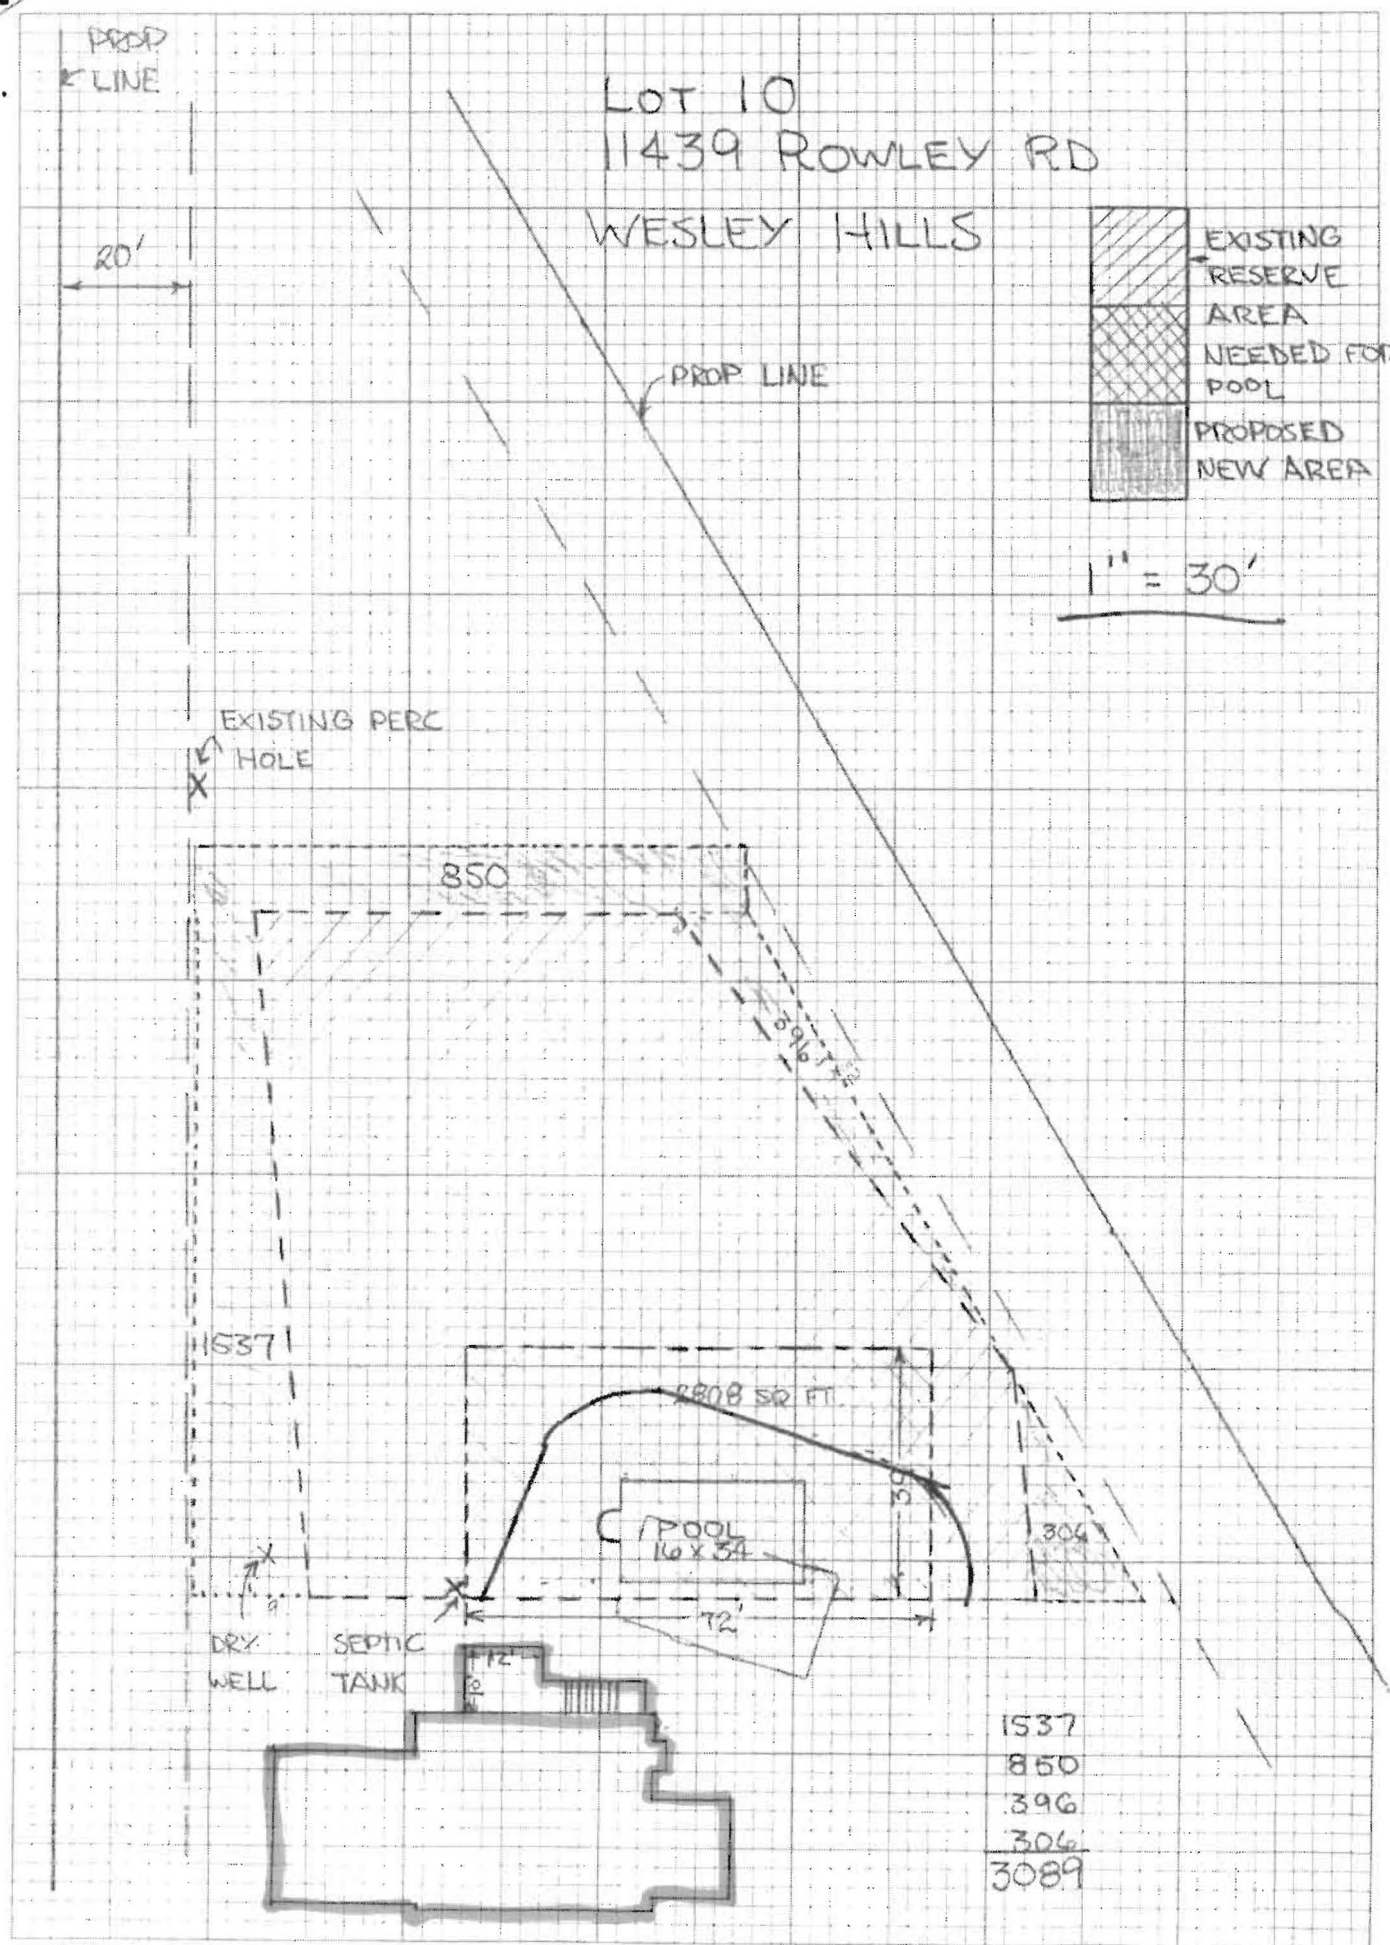

LOT 10
11439 ROWLEY RD
WESLEY HILLS

- EXISTING RESERVE AREA
- AREA NEEDED FOR POOL
- PROPOSED NEW AREA

1" = 30'

EXISTING PERC HOLE

850

1537

2808 SQ FT

POOL
16 x 34

DRY WELL

SEPTIC TANK

12'

1537
850
396
306
3089

