

LAYOUT Repair INSP 4 \_\_\_\_\_  
INSP 2 \_\_\_\_\_ INSP 5 \_\_\_\_\_  
INSP 3 \_\_\_\_\_ INSP 6 \_\_\_\_\_

ISSUE DATE: 12/12/06

APPROVAL DATE: 12/20/06

## PERMIT

P 525680

A \_\_\_\_\_

**ON-SITE SEWAGE DISPOSAL SYSTEM  
HOWARD COUNTY HEALTH DEPARTMENT  
BUREAU OF ENVIRONMENTAL HEALTH**

J M Contracting IS PERMITTED TO INSTALL ☐ ALTER ☒

ADDRESS: \_\_\_\_\_ PHONE NUMBER: 443-277-7526

SUBDIVISION: White Oak Estates LOT NUMBER: 24

ADDRESS: 13078 Saint Patricks Court PROPERTY OWNER: Michael Straus

SEPTIC TANK CAPACITY (GALLONS): \_\_\_\_\_ OUTLET BAFFLE FILTER REQUIRED ☐

PUMP CHAMBER CAPACITY (GALLONS): \_\_\_\_\_ COMPARTMENTED TANK REQUIRED ☐

NUMBER OF BEDROOMS: 4

SQUARE FEET PER BEDROOM: 300

LINEAR FEET OF TRENCH REQUIRED: \_\_\_\_\_

TRENCHES:	Trench to be 3.0 feet wide. Inlet 5.0 feet below original grade. Bottom maximum depth 6.0 feet below original grade. Effective area begins at 6.0 feet below original grade. 2.0 feet of stone below distribution pipe.
LOCATION:	Run trenches on contour behind house. Try to conserve area while working around large trees.
NOTES:	Pump out and fill in existing drywell.

PLANS APPROVED: Brian Baker DATE: 12/12/2006

NOTE: PERMIT VOID AFTER 2 YEARS

NOTE: CONTRACTOR RESPONSIBLE FOR SCHEDULING A PRE-CONSTRUCTION INSPECTION FOR ALL INSTALLATIONS


NOTE: WATERTIGHT SEPTIC TANKS REQUIRED

NOTE: ALL PARTS OF SEPTIC SYSTEM SHALL BE 100 FEET FROM ANY WATER WELL

NOTE: MANHOLE RISERS REQUIRED ON ALL SEPTIC TANKS AND PUMP CHAMBERS UNLESS SPECIFICALLY AUTHORIZED

**NEITHER THE HOWARD COUNTY COUNCIL NOR THE HEALTH DEPARTMENT IS  
RESPONSIBLE FOR THE SUCCESSFUL OPERATION OF ANY SYSTEM  
PERMITTEE RESPONSIBLE FOR OBTAINING FINAL APPROVAL ON THIS PERMIT  
CALL 410-313-2640 FOR INSPECTION OF SEPTIC SYSTEM**

NOT TO SCALE

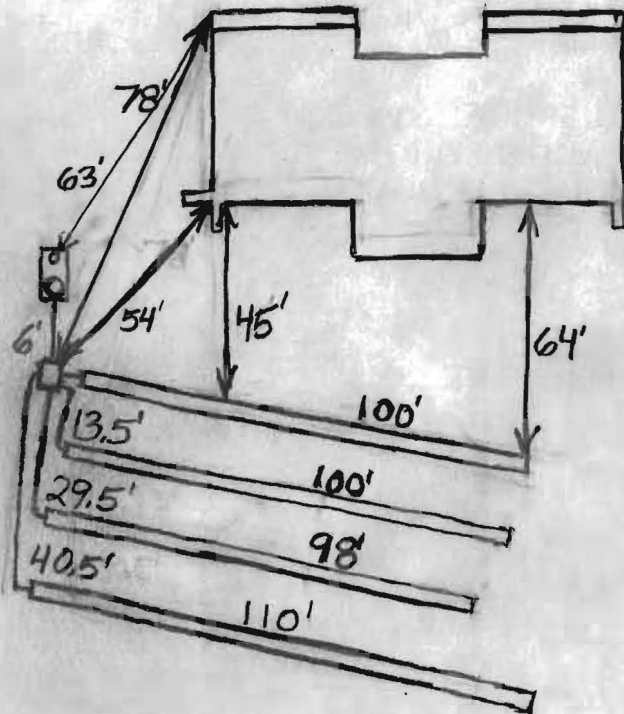

TRENCH/DRAINFIELD DATA		
WIDTH	INLET	BOTTOM
3'	5'	6'
NUMBER OF TRENCHES <u>4</u>		
TOTAL LENGTH <u>408'</u>		
ABSORPTION AREA <u>1224</u>		
DISTRIBUTION BOX LEVEL <u>Levelers</u>		
DISTRIBUTION BOX BAFFLE <u>Yes</u>		
DISTRIBUTION BOX PORT <u>No</u>		

SEPTIC TANK DATA	
SEPTIC TANK 1 LEVEL _____	
CAPACITY _____	GAL
SEAM LOC _____	
TANK LID DEPTH <u>25'-3'</u>	
BAFFLES <u>Yes</u>	
BAFFLE FILTER <u>No</u>	
MANHOLE LOC <u>Rear</u>	
6" PORT LOC <u>Front</u>	
WATERTIGHT TEST <u>No</u>	
SEPTIC TANK 2 LEVEL <u>N/A</u>	
CAPACITY _____ GAL	
SEAM LOC _____	
TANK LID DEPTH _____	
BAFFLES _____	
BAFFLE FILTER _____	
MANHOLE LOC _____	
6" PORT LOC _____	
WATERTIGHT TEST _____	

PRE-CONSTRUCTION

INSTALLATION 12/19/06 Three trenches done. Fourth trench almost done. (BB) 12/20/06 System finished. O. K. to backfill. (BB)

FINAL INSPECTOR B. Baker DATE OF APPROVAL 12/20/06