

LAYOUT 3/24/2011 INSP 4 _____
INSP 2 3/14/2011 INSP 5 _____
INSP 3 _____ INSP 6 _____

ISSUE DATE: 3/15/11

PERMIT

P _____

APPROVAL DATE: 3/25/2011

A _____

Tax ID # 05-371929

**ON-SITE SEWAGE DISPOSAL SYSTEM
TANK REPLACEMENT
HOWARD COUNTY HEALTH DEPARTMENT
BUREAU OF ENVIRONMENTAL HEALTH**

J.M. Contracting LLC.

IS PERMITTED TO

INSTALL ☒ ALTER ☐

ADDRESS: 425 Obrecht Road PHONE NUMBER: 443-277-7526

SUBDIVISION: Kings Manor LOT NUMBER: 2

ADDRESS: 12032 Scaggsville Road PROPERTY OWNER: John and Martha Blaisdell

SEPTIC TANK CAPACITY (GALLONS): 2000 OUTLET BAFFLE FILTER REQUIRED ☐

PUMP CHAMBER CAPACITY (GALLONS): _____ COMPARTMENTED TANK REQUIRED ☒

NUMBER OF BEDROOMS: _____ APPLICATION RATE: _____

SQUARE FOOTAGE OF HOUSE: _____ Trenches 2' Wide

LINEAR FEET OF TRENCH REQUIRED: 116' Inlet 5', Bottom 10'
Trenches 8' Apart
Two Trenches ~58'

Pump Out and Fill in Drywell

NOTES:	Do not order the septic tank until after layout inspection and Sanitarian approval. Layout inspection required prior to tank installation. Original septic tank must be properly abandoned before new tank installation. A written variance request is required for tanks deeper than 3 feet. A traffic bearing lid is required for tanks deeper than 4 feet.
--------	--

PLANS APPROVED: _____ DATE: _____

NOTE: PERMIT VOID AFTER 2 YEARS


NOTE: CONTRACTOR RESPONSIBLE FOR SCHEDULING A PRE-CONSTRUCTION INSPECTION FOR ALL INSTALLATIONS

NOTE: WATERTIGHT SEPTIC TANKS REQUIRED

NOTE: ALL PARTS OF SEPTIC SYSTEM SHALL BE 100 FEET FROM ANY WATER WELL

NOTE: MANHOLE RISERS REQUIRED ON ALL SEPTIC TANKS AND PUMP CHAMBERS

**NEITHER THE HOWARD COUNTY COUNCIL OR THE HEALTH DEPARTMENT IS
RESPONSIBLE FOR THE SUCCESSFUL OPERATION OF ANY SYSTEM
PERMITTEE RESPONSIBLE FOR OBTAINING FINAL APPROVAL ON THIS PERMIT
CALL 410-313-1771 FOR INSPECTION OF SEPTIC SYSTEM**

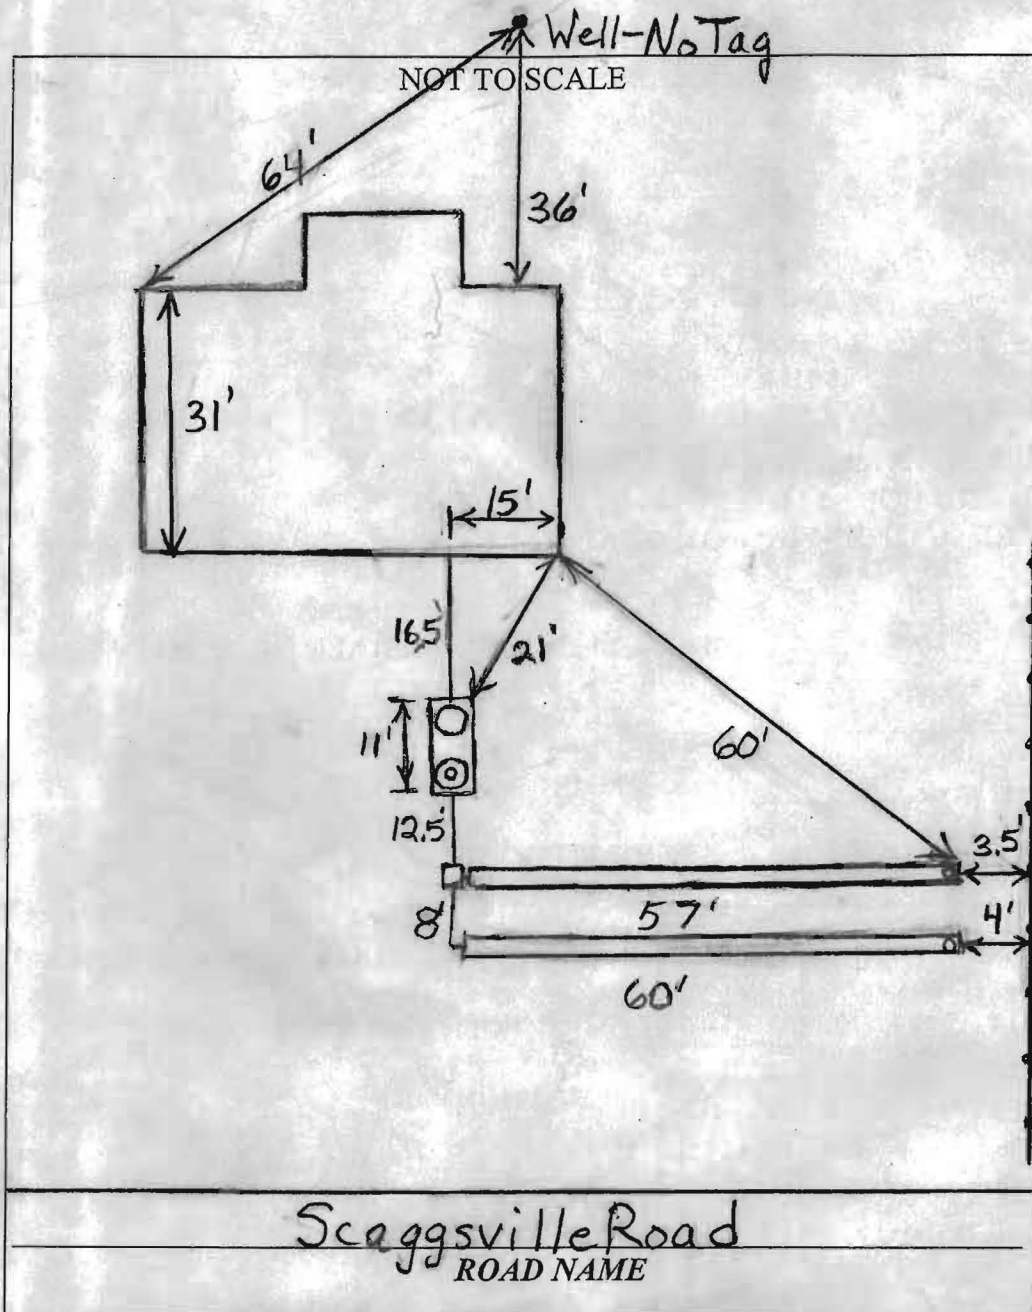

TRENCH/DRAINFIELD DATA		
WIDTH	INLET	BOTTOM
2'	5'	10'
NUMBER OF TRENCHES 2		
TOTAL LENGTH 117'		
ABSORPTION AREA 585		
DISTRIBUTION BOX LEVEL Levelers		
DISTRIBUTION BOX BAFFLE Yes		
DISTRIBUTION BOX PORT No		

SEPTIC TANK DATA	
SEPTIC TANK I LEVEL	Yes
MANUFACTURER	Babylon
CAPACITY	1500 GAL
SEAM LOC	Top
TANK LID DEPTH	4.5'-5'
BAFFLES	Yes
BAFFLE FILTER	No
MANHOLE LOC	Front
6" PORT LOC	Rear
WATERTIGHT TEST	No
SLOTTED	Yes
DATE ON LID	9/10/2010

PUMP/SEPTIC TANK LEVEL	N/A
MANUFACTURER	
CAPACITY	GAL
SEAM LOC	
TANK LID DEPTH	
BAFFLES	
BAFFLE FILTER	
MANHOLE LOC	
6" PORT LOC	
WATERTIGHT TEST	
SLOTTED	
DATE ON LID	

PRE-CONSTRUCTION:

3/24/2011 Trench layout done. Install two 58' trenches as high as possible but still being able to get a 5' trench inlet. Start trenches ~10' from drywell and run them straight across the yard. Keep trench bottoms level. BB

INSTALLATION:

3/14/2011 New traffic bearing tank installed where original collapsed tank had been. Drywell was reported to be on the verge of failing. BB 3/25/2011 System finished. O.K. to backfill. BB

FINAL INSPECTOR

B. Baker

DATE OF APPROVAL

3/25/2011