

PUB. SEWER STATUS VERIFIED BY _____

ISSUE DATE: 09/15/06

PERMIT

P 525558

APPROVAL DATE: 10/18/06

A REPAIR

Tax ID # 05-365 716

**ON-SITE SEWAGE DISPOSAL SYSTEM
HOWARD COUNTY HEALTH DEPARTMENT
BUREAU OF ENVIRONMENTAL HEALTH**

Martin C. Wuerstlin IS PERMITTED TO INSTALL ☐ ALTER ☒

ADDRESS: 12756 Route 216 PHONE NUMBER: 301-873-5820

SUBDIVISION: _____ LOT NUMBER: _____

ADDRESS: 12756 Route 216 PROPERTY OWNER: Martin C. Wuerstlin

SEPTIC TANK CAPACITY (GALLONS): _____

PUMP CHAMBER CAPACITY (GALLONS): _____

NUMBER OF BEDROOMS: 5

SQUARE FEET PER BEDROOM: 180

LINEAR FEET OF TRENCH REQUIRED: 162

*Trench 2' Wide
Inlet 4.5'
Bottom 8.5'
4' of Stone Below Pipe*

TRENCHES:	Trench to be _____ feet wide. Inlet _____ feet below original grade. Bottom maximum depth _____ feet below original grade. Effective area begins at _____ feet below original grade. _____ feet of stone below distribution pipe.
LOCATION:	
PURPOSE:	Existing septic system has failed. Call for inspection when ground is opened so sanitarian can recommend repair.

PLANS APPROVED: _____ DATE: _____

NOTE: PERMIT VOID AFTER 2 YEARS

NOTE: CONTRACTOR RESPONSIBLE FOR SCHEDULING A PRE-CONSTRUCTION INSPECTION FOR ALL INSTALLATIONS

NOTE: WATERTIGHT SEPTIC TANKS REQUIRED

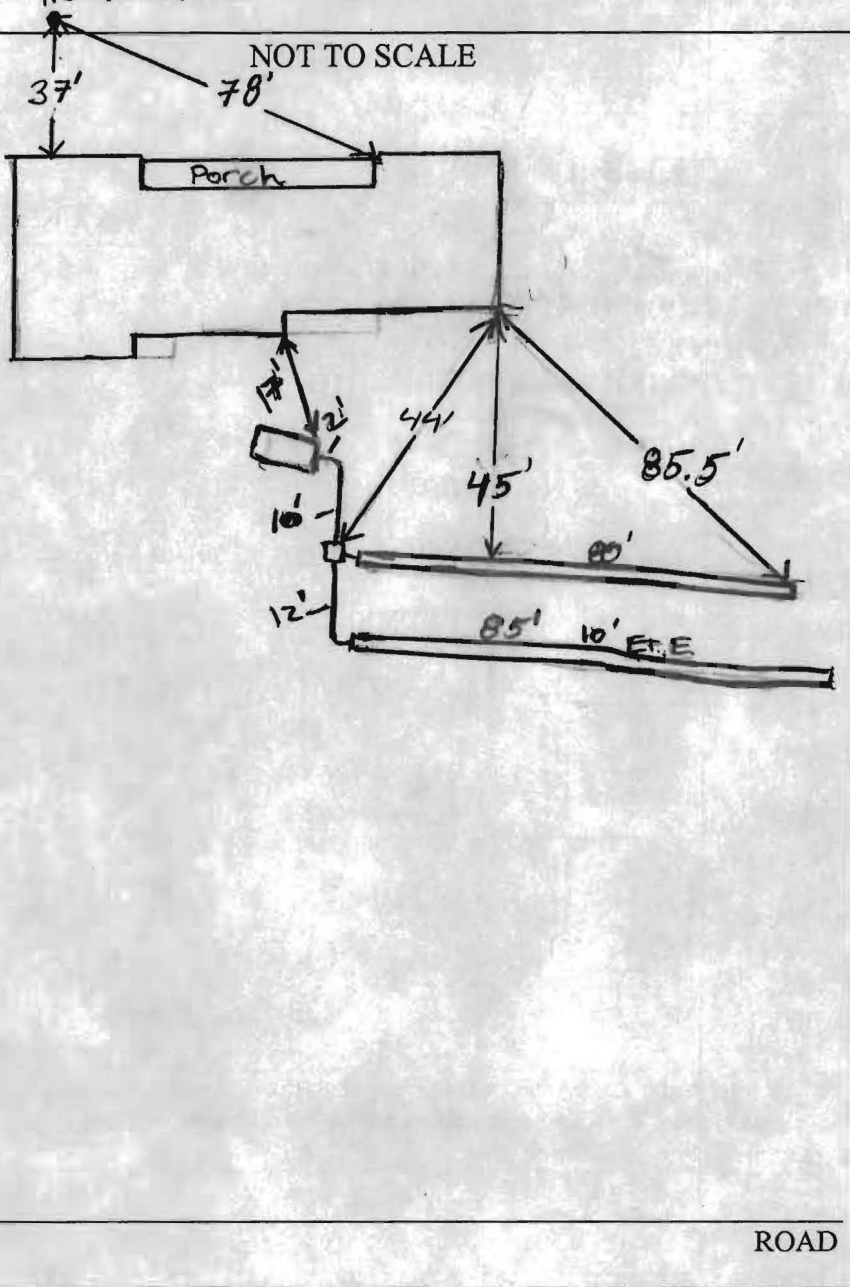
NOTE: ALL PARTS OF SEPTIC SYSTEM SHALL BE 100 FEET FROM ANY WATER WELL

NOTE: MANHOLE RISERS REQUIRED ON ALL SEPTIC TANKS AND PUMP CHAMBERS

**NEITHER THE HOWARD COUNTY COUNCIL OR THE HEALTH DEPARTMENT IS
RESPONSIBLE FOR THE SUCCESSFUL OPERATION OF ANY SYSTEM
PERMITTEE RESPONSIBLE FOR OBTAINING FINAL APPROVAL ON THIS PERMIT
CALL 410-313-2640 FOR INSPECTION OF SEPTIC SYSTEM**

H0-73-0792

NOT TO SCALE

**TRENCH/DRAINFIELD DATA**

WIDTH	INLET	BOTTOM
2'	4'	9'
NUMBER OF TRENCHES		2
TOTAL LENGTH		165'
ABSORPTION AREA		330 + SW
DISTRIBUTION BOX LEVEL		Yes (level)
DISTRIBUTION BOX BAFFLE		Yes
DISTRIBUTION BOX PORT		N/O

SEPTIC TANK DATA

SEPTIC TANK 1 LEVEL	Yes
CAPACITY	? GAL
SEAM LOC	mid
TANK LID DEPTH	3.5'
BAFFLES	Yes
BAFFLE FILTER	—
MANHOLE LOC	none
6" PORT LOC	none
WATERTIGHT TEST	—
SEPTIC TANK 2 LEVEL	—
CAPACITY	— GAL
SEAM LOC	—
TANK LID DEPTH	—
BAFFLES	—
BAFFLE FILTER	—
MANHOLE LOC	—
6" PORT LOC	—
WATERTIGHT TEST	—

PRE-CONSTRUCTION

INSTALLATION 10/16/06 Second trench dug to 9'. No stone yet. (SW) 10/18/06 Both trenches installed on contour. Made inlet only 4' w/ 9' bottom. system complete. OK to backfill. (KW)

FINAL INSPECTOR

DATE OF APPROVAL

10/18/06