

DEPARTMENT OF INSPECTIONS, LICENSES AND PERMITS
3430 COURT HOUSE DRIVE
ELLCOTT CITY, MD 21043
PERMITS (410) 313-2155 INSPECTIONS (410) 313-1810
AUTOMATED INFORMATION (410) 313-3800

HOWARD COUNTY
PERMIT APPLICATION

PERMIT NUMBER
B08001974

Building Address 12736 Scaggsville Rd.
HIGHLAND, MD 20777

Suite/Apt. #: SDP/WP/Petition #:

Census Tract Subdivision

Section Area Lot

Tax Map Parcel 335 Grid

Zoning Map Coordinates Lot size

Property Owner's Name Martin Wuerstlin

Address 12756 Scaggsville Rd.

City Highland State MD Zip Code 20777

Home Phone 301-854-3791 Work Phone 301-854-3233

Applicant's Name & Mailing Address, (if other than stated herein):

Phone Fax

Existing Use

Proposed Use

Estimated Construction Cost \$

Description of Work 32'x48' TIE TRAIL 16 STEELIES

Contractor Company Conestoga Structures
CB Structures

Contact Person Jim Dabosh

Address 202 Orton Rd.

City New Holland State Pa. Zip Code 17557

License No. 84759 CB Structures

Phone 717-351-7003 Fax

Occupant or Tenant

Contact Name

Address

City State Zip Code

Phone Fax

Engineer or Architect Company Conestoga Structures

Contact Person

Address

City State Zip Code

Phone Fax

BUILDING DESCRIPTION - COMMERCIAL

BUILDING DESCRIPTION - RESIDENTIAL

Building Characteristics

Height:

No. of stories:

Gross area, sq. ft. per floor:

Use group:

Construction type:

Reinforced Concrete

Structural Steel

Masonry

Wood Frame

State Certified Modular

Utilities

Water Supply:

Public

Private

Sewage Disposal:

Public

Private

Electric Yes No

Gas Yes No

Heating System:

Electric Oil

Natural Gas

Propane Gas

Sprinkler system: N/A

Full

Partial

Other Suppression

of Heads

Building Characteristics

SF Dwelling SF Townhouse

Depth Width

1st floor:

2nd floor:

Basement:

Finished Basement Unfinished Basement

Crawl space Slab on Grade

No. of Bedrooms

Height:

Multi-family dwellings:

No. of efficiency units:

No. of 1 BR units:

No. of 2 BR units:

No. of 3 BR units:

Other Structure:

Dimensions:

Footings:

Roof Height:

State Certified Modular

Manufactured Home

Utilities

Water Supply:

Public

Private

Sewage Disposal:

Public

Private

Electric Yes No

Gas Yes No

Heating System:

Electric Oil

Natural Gas

Propane Gas

Sprinkler system: N/A

NFPA #13D

NFPA #13R

Other:

THE UNDERSIGNED HEREBY CERTIFIES AND AGREES AS FOLLOWS: (1) THAT HE/SHE IS AUTHORIZED TO MAKE THIS APPLICATION; (2) THAT THE INFORMATION IS CORRECT; (3) THAT HE/SHE WILL COMPLY WITH ALL REGULATIONS OF HOWARD COUNTY WHICH ARE APPLICABLE THERETO; (4) THAT HE/SHE WILL PERFORM NO WORK ON THE ABOVE REFERENCED PROPERTY NOT SPECIFICALLY DESCRIBED IN THIS APPLICATION; (5) THAT HE/SHE GRANTS COUNTY OFFICIALS THE RIGHT TO ENTER ONTO THIS PROPERTY FOR THE PURPOSE OF INSPECTING THE WORK PERMITTED AND POSTING NOTICES.

Martin Wuerstlin

Applicant's Signature

Title/Company

MARTIN WUERSTLIN

Print Name

6.11.08

Date

Checks payable to: DIRECTOR OF FINANCE OF HOWARD COUNTY

PLEASE WRITE NEATLY AND LEGIBLY.

FOR OFFICE USE ONLY

AGENCY DATE SIGNATURE APPROVAL

Land Development DPZ

State Highways

Building Official

Dev. Engineering DPZ

Health 6-2-08

Fire Protection

Is Sediment Control approval required prior to issuance?

YES NO

CONTINGENCY CONSTRUCTION START: ONE STOP SHOP:

Distribution of Copies: White: Building Official Green: LDD, DPZ Yellow: DED, DPZ Pink: Health Gold: SHA

T:\home\PERMIT.FRM

DPZ SETBACK INFORMATION

Front: Filing fee \$

Rear: Permit fee \$

Side: Excise tax \$

Side St: Add'l per. fee \$

All minimum setbacks met? TOTAL FEES \$

YES NO

Is Entrance Permit required? Sub-total paid \$

YES NO

Check Balance due \$

Validation #

Historic District? YES NO


Lot Coverage for New/Town Zone

SDP/Red-line approval date Accepted by

PROPERTY ID#

Rev. 11/4/04

No evidence of property corners was found. Apparent occupation is shown

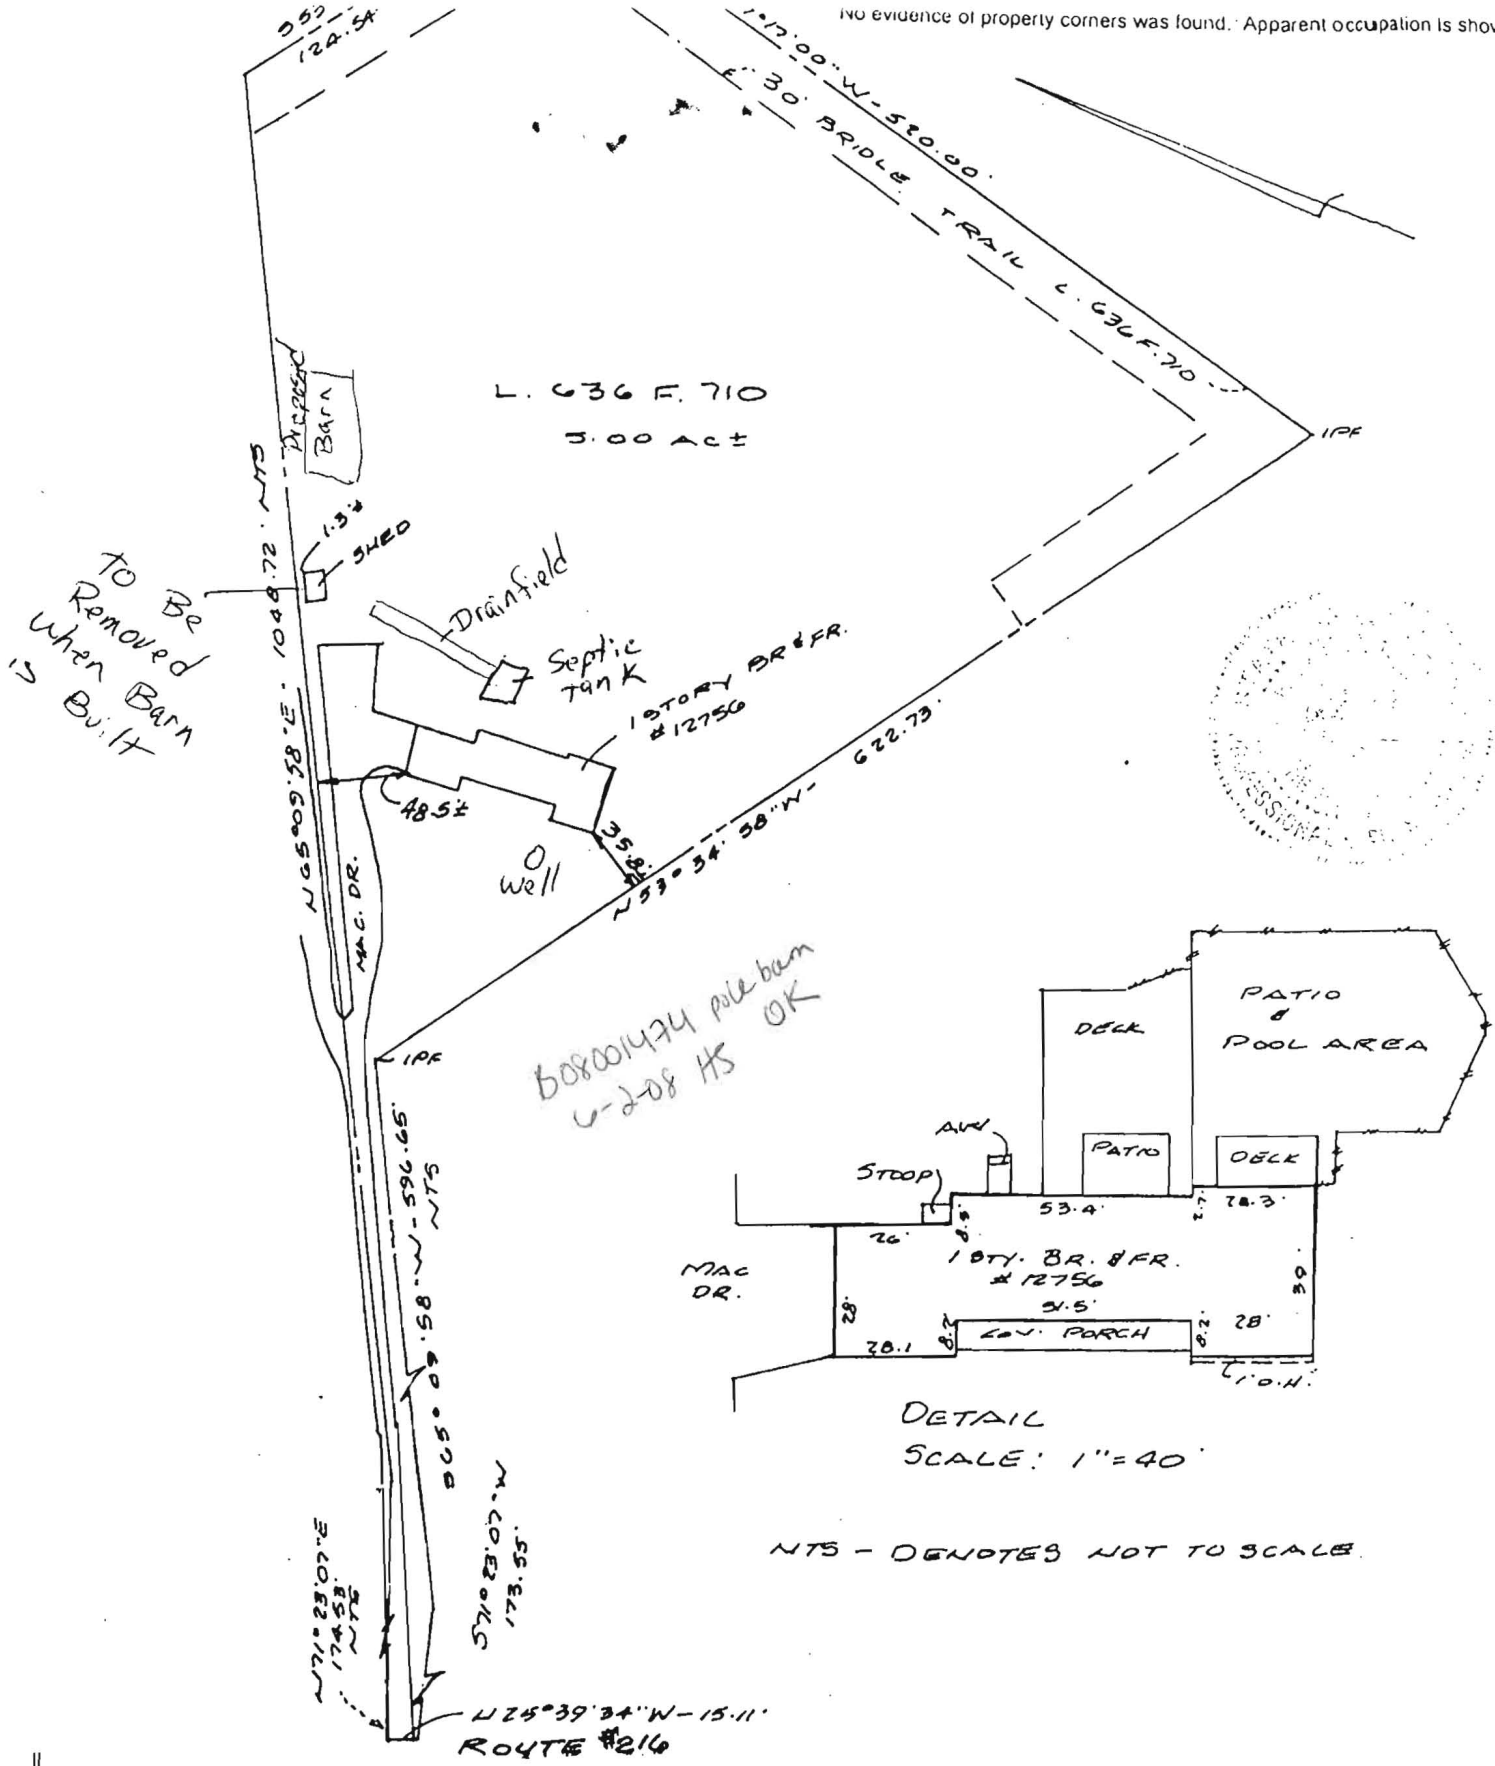

Date: 07-16-02
Plat Book:
Plat No.:
Work Order: 02-3456
Address: 12756 ROUTE 216
District: 5
Jurisdiction: HOWARD COUNTY, MD

Scale: 1"=100' Dwn: 2/16

NO TITLE REPORT FURNISHED

Surveyor's Certification

I hereby certify that the survey shown hereon is correct to the best of my knowledge and that, unless noted otherwise, it has been prepared utilizing description of record. This survey is not a boundary survey and the location or existence of property corners is neither guaranteed nor implied. Fence lines, if shown, are approximate in location. This property does not lie within a 100-year flood plain according to FEMA insurance maps as interpreted by the originator unless otherwise shown hereon. Building restriction lines shown are as per available information and are subject to the interpretation of the originator.

LOCATION DRAWING
LIBER 636
FOLIO 710