

Bureau of Environmental Health
8930 Stanford Boulevard, Columbia, MD 21045
Main: 410-313-2640 | Fax: 410-313-2648
TDD 410-313-2323 | Toll Free 1-866-313-6300
www.hchealth.org
Facebook: www.facebook.com/hocohealth

Maura J. Rossman, M.D., Health Officer

RECEIPT DATE: 10/21/15 **ONSITE SEWAGE DISPOSAL SYSTEM**

P 557421

INSTALLATION
APPROVAL DATE: 10/26/15 SEC

A _____

PERMIT

TANK REPLACEMENT

PROPERTY ADDRESS: 11967 Scaggsville Road

SUBDIVISION: _____ LOT: _____ TAX ID: _____

CONTRACTOR: Billings Outback Septic Service EMAIL: _____

CONTRACTOR ADDRESS: 180 Obrecht Road / Millersville, MD 21108 PHONE: 410-353-3880

PROPERTY OWNER: Stephen Rankin EMAIL: _____

OWNER ADDRESS: 11967 Scaggsville Road PHONE: _____

NUMBER OF BEDROOMS: _____ SEPTIC TANK SIZE: 1500 gal DRAINFIELD SIZE/TYPE: _____

| | |
|-----------|--|
| LOCATION: | Replace existing tank that has a damaged lid from equipment in area. |
| NOTES: | <p>New tank must be 1500 gallons, top seam, slotted. Place new tank 15' farther away from house than old tank to stay outside of 100' radius of well. Call for an inspection when setting the new tank.</p> <p>Old tank must be pumped and abandoned and documentation submitted to the Health Department.</p> |

ISSUED BY: Sarah Collins ISSUE DATE: 10/20/15 EXPIRATION DATE: 10/20/16

NOTE: CONTRACTOR MUST SCHEDULE AN INSPECTION AND GAIN APPROVAL OF ALL COMPONENTS PRIOR TO COVERING

NOTE: AN ELECTRICAL PERMIT IS REQUIRED FOR INSTALLATION OF ANY ELECTRICAL COMPONENTS OF THE SYSTEM

NOTE: MDE RECOMMENDS SEPTIC TANKS, BAT, AND OTHER PRETREATMENT UNITS BE PUMPED AT A FREQUENCY ADEQUATE TO ENSURE THAT SOLIDS ARE NOT DISCHARGED TO THE DISPOSAL AREA


**NEITHER THE HOWARD COUNTY COUNCIL NOR THE HEALTH DEPARTMENT IS RESPONSIBLE
FOR THE SUCCESSFUL OPERATION OF ANY SYSTEM.**

PERMITTEE RESPONSIBLE FOR OBTAINING FINAL APPROVAL ON THIS PERMIT.

CALL 410-313-1771 FOR INSPECTION OF SEPTIC SYSTEM.

Scaggsville Rd.

NOT TO SCALE

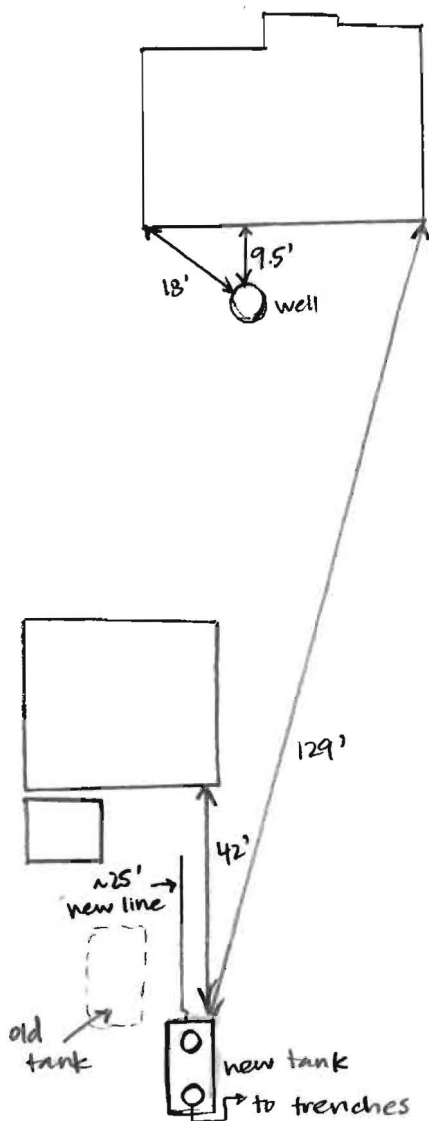

TRENCH/DRAINFIELD DATA

WIDTH INLET BOTTOM

NUMBER OF TRENCHES _____

TOTAL LENGTH _____

ABSORPTION AREA _____

DISTRIBUTION BOX LEVEL _____

DISTRIBUTION BOX BAFFLE _____

DISTRIBUTION BOX PORT _____

SEPTIC TANK DATA

SEPTIC TANK I LEVEL YES

MANUFACTURER BAY STAR

CAPACITY 1500 GAL

SEAM LOC TOP

TANK LID DEPTH 1'

BAFFLES YES

BAFFLE FILTER NO

MANHOLE LOC FRONT + REAR

6" PORT LOC NONE

WATERTIGHT TEST NO

SLOTTED YES

DATE ON LID —

~~PUMP/SEPTIC TANK LEVEL _____~~

~~MANUFACTURER _____~~

~~CAPACITY _____ GAL~~

~~SEAM LOC _____~~

~~TANK LID DEPTH _____~~

~~BAFFLES _____~~

~~BAFFLE FILTER _____~~

~~MANHOLE LOC _____~~

~~6" PORT LOC _____~~

~~WATERTIGHT TEST _____~~


~~SLOTTED _____~~

~~DATE ON LID _____~~

PRE-CONSTRUCTION:

INSTALLATION: 10/26/15 New tank installed. ~25' of new line installed to tie in new tank. Old tank pumped + collapsed. Trenches are to the east of the outlet of the new tank, according to Greg with Billings Outback. Inlet baffle 6", outlet 4". (SC)

FINAL INSPECTOR Sarah Collins DATE OF APPROVAL 10/26/15

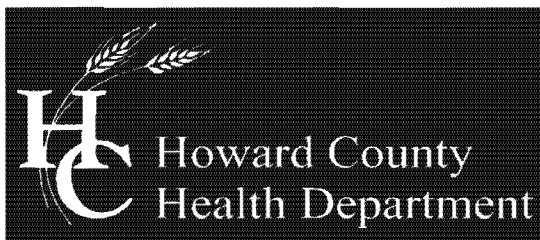

Bureau of Environmental Health

8930 Stanford Blvd, Columbia, MD 21045
Main: 410-313-2640 | Fax: 410-313-2648
TDD 410-313-2323 | Toll Free 1-866-313-6300
www.hchealth.org

Maura J. Rossman, M.D., Health Officer

October 20, 2015

Homeowner
11967 Scaggsville Rd.
Fulton, MD 20759

RE: **Well Sampling**
11967 Scaggsville Rd.

Dear Homeowner,

During a recent inspection for a septic tank replacement on your property, I noticed that the well is a potential source of contamination to your drinking water supply. The well appears to be enclosed in a 3'-wide pit and there is a gap between the lid and the base. It is possible for contaminants to enter the drinking water with this setup.

I am recommending that you get your water tested for contamination. Please contact the Community Hygiene Program at **(410) 313-1773** to schedule water sampling. This sampling includes testing for bacteria, nitrates, turbidity, and sand. There is currently **no charge** for the sampling and it is to your benefit to have it tested.

Sampling of the well should be collected from the primary indoor drinking tap, but if suitable scheduling is not possible, the sample may be taken from an outside tap to complete your sampling obligation. However, the potential for unsuccessful sample results increases when samples are collected from taps exposed to the outside environment.

If sampling has already been performed by an outside lab, please help us by forwarding the results of the samples to our office.

Feel free to contact me with any questions.

Sincerely,

Sarah Collins
Howard County Health Department
SCollins@howardcountymd.gov
410-313-6287

Cc: Community Hygiene Program
File

FILE INQUIRY NOTES

[illegible]

SITE INSPECTION SHEET

OWNER: _____ PHONE #: _____


ADDRESS: 11967 Scaggsville Rd. CONTRACTOR: _____

WELL TAG #: _____

SUBDIVISION: _____ LOT: _____ COUNTY #: _____

PROPOSAL: _____

LOCATION DIAGRAM

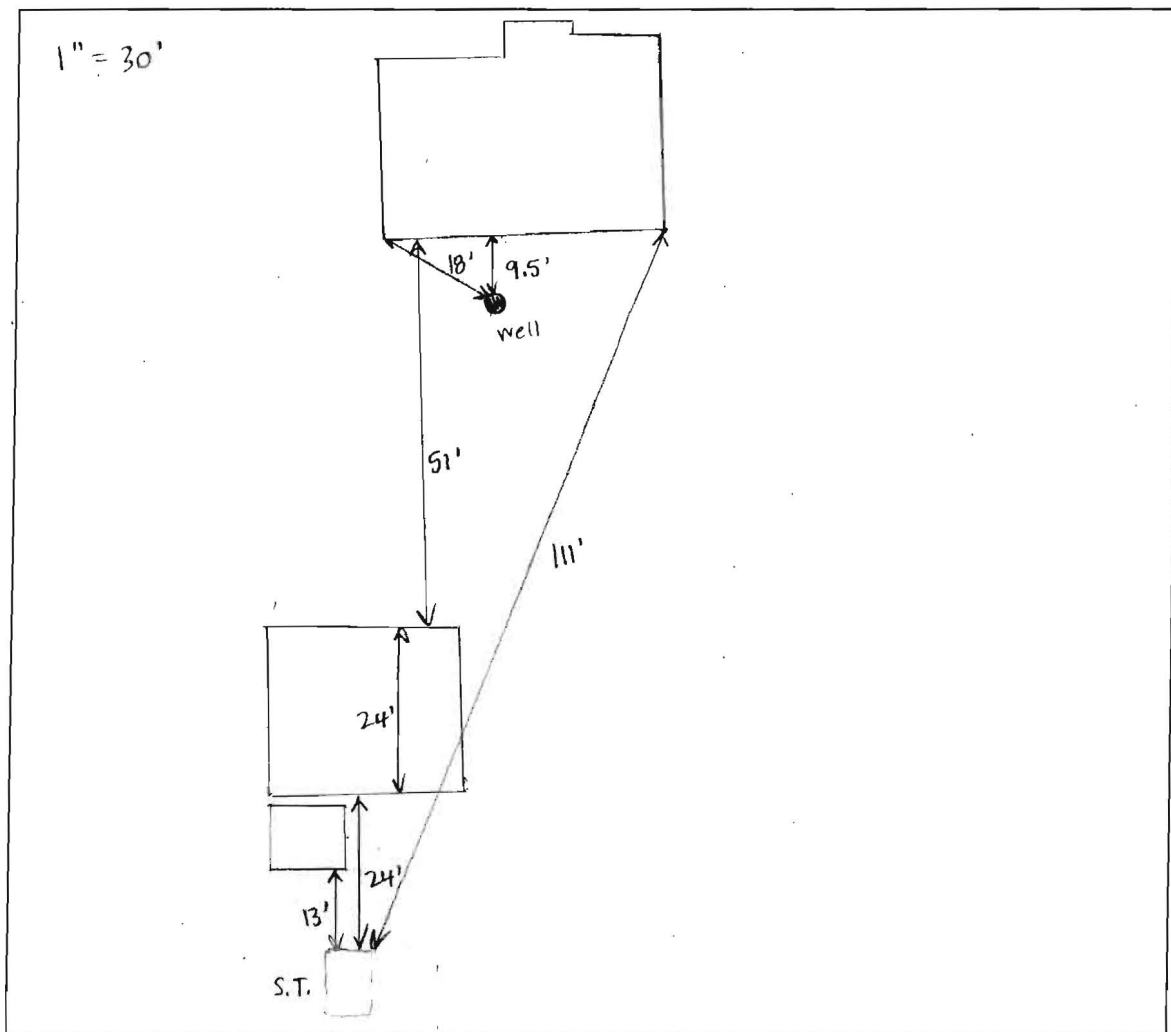

COMMENTS: 10/20/15 Took measurements of distances of tank and well from
buildings on site. Install new tank 15' farther from house to ensure it's
out of the 100' well radius.

DATE: 10/20/15 INSPECTOR: Sarah Collins

11967 ROUTE 216

