

Building Permit Application

Howard County Maryland

Department of Inspections, Licenses and Permits

3430 Court House Drive

Permits: 410-313-2455

www.howardcountymd.gov

Date Received:	9
Permit No.:	

Building Address: 11008 5	Property Owner's Name: Us @	ST, HARC	LD+ ANNE			
City: ELLICOTT CITYState:	MD Zip Code: 21	Address: 11008 STEEPLE CHASE CT				
Suite/Apt. #SDI		City: FLLICOTT CITY State: MD Zip Code: 21042 Phone: 410,497.7461 Fax:				
Census Tract:		1	Email:			
Section: Are			Applicant's Name & Mailing Ad	ddress. (If other th	nan stated herein)	
Tax Map: <u>ひのネタ</u> Parcel:	0021 Grid: C	Applicant's Name				
Zoning: Map Coordinates: Lot Size: 1/13 A			Address: 1101 PULASK 1 HYKIY City: BALTO State: M3 Zip Code: 2116 A			
			Phone: 410 335 40	196Fax: 410	335 4096	
Existing Use:					0.5010166	
Proposed Use:			Contractor Company: CREATIVE DECK DESIGNS Contact Person:			
Estimated Construction Cost: \$			Address: 1101 PULASICI HYWY			
Description of Work: Open clerk 40'x 18'			City: BALTState			
<u> </u>			License No.: 37346			
			Phone: 410-335.4095Fax: 410-331-4096			
Occupant or Tenant:			Email:			
Was tenant space previously occupied	i? □Yes	□No	Engineer/Architect Company: _			
Contact Name:			Responsible Design Prof.:			
Address:		Address:				
City:			City:State			
Phone:			Phone:			
Email:			150	1 ax		
Liliali.			Email:			
Commercial Building Characteristics			Utilities			
Height: No. of stories:	☐ SF Dwelling ☐ SF Tow Depth	nhouse Width	Water Supply			
Gross area, sq. ft./floor:	1 st floor:	wiatii	Public			
	2 nd floor:	×	Private			
Area of construction (sq. ft.):	Basement:		Sewage Disposal		·	
Hea group:	☐ Finished Basement		Public			
Use group:	e group: Unfinished Basement Crawl Space		☐ Private ☐ Private ☐ No			
Construction type:	☐ Slab on Grade					
☐ Reinforced Concrete	No. of Bedrooms:					
☐ Structural Steel	Multi-family Dwe	elling	Heating System			
Masonry No. of efficiency units:			☐ Electric ☐ Oil			
Wood Frame No. of 1 BR units:			☐ Natural Gas ☐ Propane Gas			
☐ State Certified Modular	No. of 2 BR units: No. of 3 BR units:		Other:			
 	Other Structure:		Sprinkler System:			
	Dimensions:		☐ Yes ☐ No			
> Roadside Tree Project Permit	Footings:					
□Yes □No	Roof:		Grading Permit Number:			
Roadside Tree Project Permit #	☐ State Certified Modula	ar			4	
	☐ Manufactured Home		Building Shell Perm	nit Number:	4	
THE UNDERSIGNED HEREBY CERTIFIES AND AG WITH ALL REGULATIONS OF HOWARD COUNTY THIS APPLICATION; (5) THAT HE/SHE GRANTS CAPPlicant's Signature	WHICH ARE APPLICABLE THERETO;	(4) THAT HE/SHE VITER ONTO THIS PRO	WILL PERFORM NO WORK ON THE ABOVE R	REFERENCED PROPERTY	NOT SPECIFICALLY DESCRIBED IN	
Email Address		-	Testo			
Email Address		_	ate			
Title/Company						
		PLEASE WRITE NE	FINANCE OF HOWARD COUNTY ATLY & LEGIBLY** E USE ONLY-		*	
ACEUCY .	CICALATURE OF ARESOLUTION	20. NO THE SHAREST A HELL	Carlos Salaria Anthropagnica	Filing Fee	\$	
AGENCY DATE	SIGNATURE OF APPROVAL	JAL DPZ SETBACK INFORMATION Front:		Permit Fee	\$	
State Highways		Rear:		Tech Fee	\$	
Building Officials	Side:		Excise Tax	Ś		

Distribution of Copies:

PSZA (Zoning)

PSZA (Engineering)

White: Building Officials

Health

Is Sediment Control approval required for issuance? ☐ Yes ☐ No
☐ CONTINGENCY CONSTRUCTION START


Green: PSZA,Zoning

Yellow: PSZA, Engineering

Lot Coverage for New Town Zone: SDP/Red-line approval date:

Side St.:

PSF\$ **Guaranty Fund** Add'l per Fee **Total Fees** Sub-Total Paid **Balance Due**

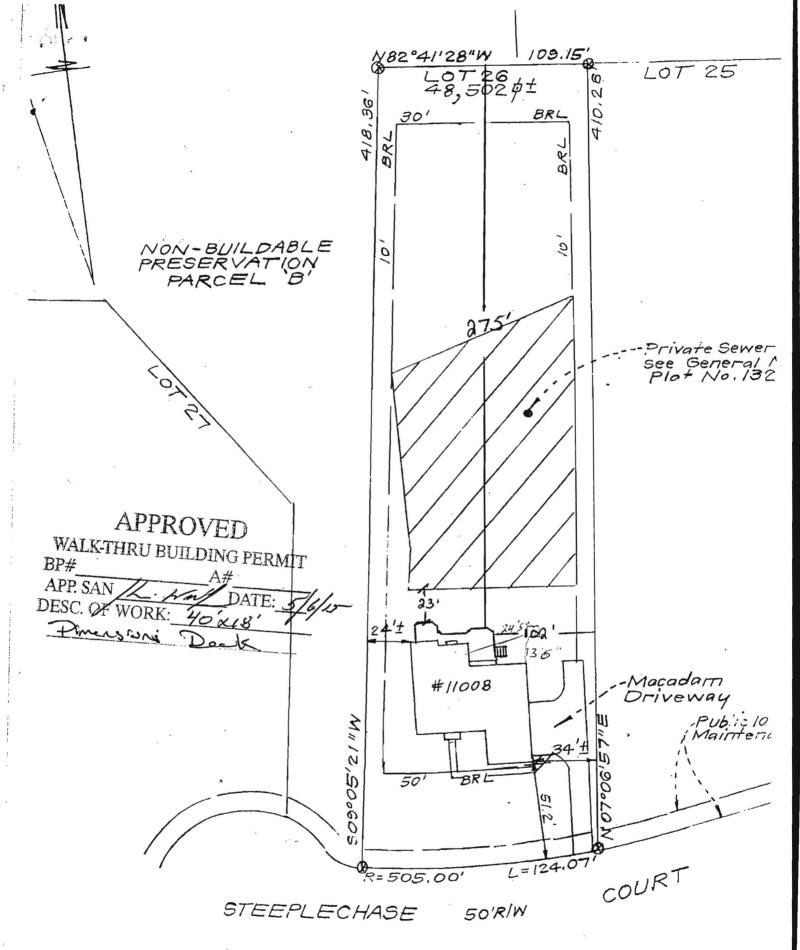

Scale /"= 50'