



Building Permit Application

Howard County Maryland
Department of Inspections, Licenses and Permits
3430 Court House Drive
Permits: 410-313-2455
www.howardcountymd.gov

Date Received: 9/16/15

Permit No.: B15004056

Building Address: 12698 Scaggsville Rd.
City: Highland State: MD Zip Code: 20777
Suite/Apt. #: SDP/WP/BA #:
Census Tract: Subdivision:
Section: Area: Lot:
Tax Map: Parcel: Grid:
Zoning: Map Coordinates: Lot Size:

Existing Use: Single family Dwelling
Proposed Use: Fuel supply for
Estimated Construction Cost: \$ 4,100
Description of Work: Burying 500 gallon propane
and connected to stub out for
heat
Occupant or Tenant:
Was tenant space previously occupied? ☐ Yes ☒ No
Contact Name:
Address:
City: State: Zip Code:
Phone: Fax:
Email:

Commercial Building Characteristics
Height:
No. of stories:
Gross area, sq. ft./floor:
Area of construction (sq. ft.):
Use group:
Construction type:
☐ Reinforced Concrete
☐ Structural Steel
☐ Masonry
☐ Wood Frame
☐ State Certified Modular
Residential Building Characteristics
☐ SF Dwelling ☐ SF Townhouse
Depth Width
1st floor:
2nd floor:
Basement:
☐ Finished Basement
☐ Unfinished Basement
☐ Crawl Space
☐ Slab on Grade
No. of Bedrooms:
Multi-family Dwelling
No. of efficiency units:
No. of 1 BR units:
No. of 2 BR units:
No. of 3 BR units:
Other Structure:
Dimensions:
Footings:
Roof:
☐ State Certified Modular
☐ Manufactured Home

Commercial Building Characteristics
Height:
No. of stories:
Gross area, sq. ft./floor:
Area of construction (sq. ft.):
Use group:
Construction type:
☐ Reinforced Concrete
☐ Structural Steel
☐ Masonry
☐ Wood Frame
☐ State Certified Modular
Residential Building Characteristics
☐ SF Dwelling ☐ SF Townhouse
Depth Width
1st floor:
2nd floor:
Basement:
☐ Finished Basement
☐ Unfinished Basement
☐ Crawl Space
☐ Slab on Grade
No. of Bedrooms:
Multi-family Dwelling
No. of efficiency units:
No. of 1 BR units:
No. of 2 BR units:
No. of 3 BR units:
Other Structure:
Dimensions:
Footings:
Roof:
☐ State Certified Modular
☐ Manufactured Home

Property Owner's Name: Brent Stubbs
Address: 12698 Scaggsville Rd
City: Highland State: MD Zip Code: 20777
Phone: 301 251 9868 Fax:
Email:

Applicant's Name & Mailing Address, (if other than stated herein)
Applicant's Name:
Address:
City: State: Zip Code:
Phone: Fax:
Email:

Contractor Company: Suburban Propane
Contact Person: Brent Stubbs
Address: 31 Derwood Cir.
City: Rockville State: MD Zip Code: 20854
License No.: 78263
Phone: 301 251 0606 Fax: 301 251 0608
Email:

Engineer/Architect Company:
Responsible Design Prof.:
Address:
City: State: Zip Code:
Phone: Fax:
Email:

Utilities	
Water Supply	
☐ Public	
☒ Private	
Sewage Disposal	
☐ Public	
☒ Private	
Electric: ☐ Yes ☐ No	
Gas: ☐ Yes ☐ No	
Heating System	
☐ Electric ☐ Oil	
☐ Natural Gas ☐ Propane Gas	
☐ Other:	
Sprinkler System:	
☐ Yes ☐ No	
Grading Permit Number:	
Building Shell Permit Number:	

THE UNDERSIGNED HEREBY CERTIFIES AND AGREES AS FOLLOWS: (1) THAT HE/SHE IS AUTHORIZED TO MAKE THIS APPLICATION; (2) THAT THE INFORMATION IS CORRECT; (3) THAT HE/SHE WILL COMPLY WITH ALL REGULATIONS OF HOWARD COUNTY WHICH ARE APPLICABLE THERETO; (4) THAT HE/SHE WILL PERFORM NO WORK ON THE ABOVE REFERENCED PROPERTY NOT SPECIFICALLY DESCRIBED IN THIS APPLICATION; (5) THAT HE/SHE GRANTS COUNTY OFFICIALS THE RIGHT TO ENTER ONTO THIS PROPERTY FOR THE PURPOSE OF INSPECTING THE WORK PERMITTED AND POSTING NOTICES.

Applicant's Signature
Brent Stubbs
Email Address
BSTUBBS@SUBURBANPROPANE.COM
Title/Company
CSC Manager/Suburban Propane

Print Name
Brent Stubbs
Date
9/16/15

RECEIVED

SEP 16 2015

Checks Payable to: DIRECTOR OF FINANCE OF HOWARD COUNTY

LICENSES & PERMITS
DIVISION

AGENCY	DATE	SIGNATURE OF APPROVAL
State Highways		
Building Officials		
PSZA (Zoning)		
PSZA (Engineering)		
Health	10/1/15	R.127

Is Sediment Control approval required for issuance? ☐ Yes ☐ No
☐ CONTINGENCY CONSTRUCTION START

DPZ SETBACK INFORMATION
Front:
Rear:
Side:
Side St.:
All minimum setbacks met? ☐ Yes ☐ No
Is Entrance Permit Required? ☐ Yes ☐ No
Historic District? ☐ Yes ☐ No
Lot Coverage for New Town Zone:
SDP/Red-line approval date:

Filing Fee	\$
Permit Fee	\$ 100.00
Tech Fee	\$ 10.00
Excise Tax	\$
PSFS	\$
Guaranty Fund	\$
Add'l per Fee	\$
Total Fees	\$ 110.00
Sub-Total Paid	\$
Balance Due	\$
CHECK MO	# 17-29533958

Distribution of Copies: White: Building Officials

Green: PSZA, Zoning


Yellow: PSZA, Engineering

Pink: Health

Gold: SHA

T:\Operations\Updated Forms\Building applmp B.2012.docx

PROPOSED UNDERGROUND
LIQUID PROPANE TANK
INSTALLATION LOCATION
FOR 12698 SCAGGSVILLE
ROAD, HOWARD COUNTY, MD

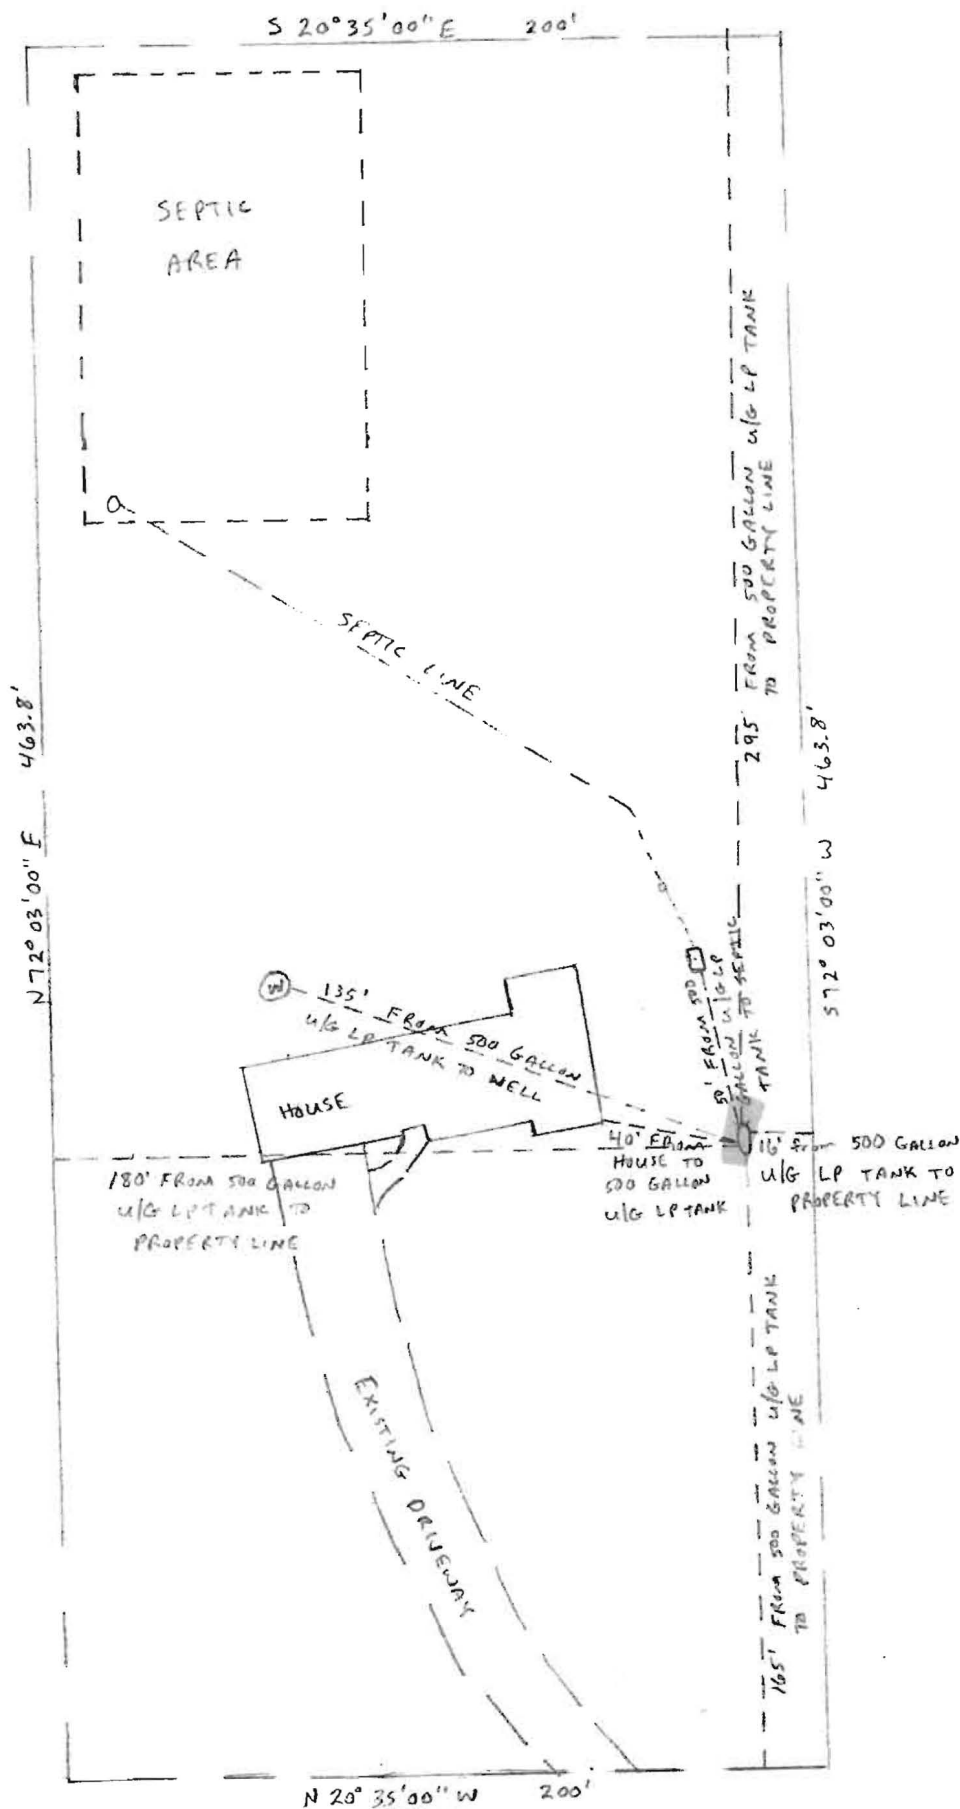

LEGEND	
---	PROPERTY LINES
---	DRIVEWAY
---	SEPTIC MARKINGS AND MEASUREMENT LINES
⊙	WELL
□	SEPTIC TANK
○	500 GALLON U/G LP TANK
---	STRUCTURE MARKINGS

Approved for UPT
B15004056
LRT 10/9/15