

9-5-01
LO-101T
10:30-11:00am
9/11/01 Followup
PH(2:30)
9/18/01-PM

9/12/01
CO.
2:30
9/13/01
11/9/01-
pump test
2:30pm

11/14/01 Pump Test 1:30

PERMIT

SEWAGE DISPOSAL SYSTEM
HOWARD COUNTY HEALTH DEPARTMENT
BUREAU OF ENVIRONMENTAL HEALTH
410-313-2640

P 515966

A 49229

ISSUE DATE 8/1/2001

APPROVAL DATE 11/15/01

INDEXED

South Carroll Backhoe, Inc

IS PERMITTED TO INSTALL X ALTER

ADDRESS 4410 Salem Bottom Road, Westminster, MD 21157 PHONE 410-875-4197

SUBDIVISION Cattail Run LOT NUMBER 3 ADDRESS 15600 Bushy Park Road

PROPERTY OWNER Jerry & Lisa Honsberger PROPERTY OWNER'S ADDRESS 13380 Pipes Lane (21784)

SEPTIC TANK CAPACITY 1500 GALLONS *TOP SEAMED SEPTIC TANK REQUIRED*

PUMP CHAMBER CAPACITY 1500 GALLONS **TOP SEAMED PUMP CHAMBER REQUIRED**

NUMBER OF BEDROOMS 5

SQUARE FEET PER BEDROOM 210

LINEAR FEET OF TRENCH REQUIRED 350

04-355865

TRENCHES: Trenches to be 3 feet wide. Inlet 1.5 feet below original grade. Bottom maximum depth

3 feet below original grade. 1.5 feet of stone below distribution ~~box~~ pipe.

LOCATION: Starting from the 211.20'/215.53' intersection, place distribution box 20 feet down the 215.53' lot line and 75 feet off this same lot line. Run trenches along contour in both directions.

INSTALL TRENCHES 10' APART CENTER-TO-CENTER.

3/14/01 O.K. (BB)

PLANS APPROVED Mark Rifkin, R.S. DATE 3/8/2001

PERMIT VOID AFTER 2 YEARS

NOTE: CONTRACTOR RESPONSIBLE FOR SCHEDULING A PRE-CONSTRUCTION INSPECTION FOR ALL INSTALLATIONS

NOTE: TOP OF SEPTIC TANKS ARE TO BE NO DEEPER THAN 3.0 FEET BELOW FINISH GRADE

NOTE: WATERTIGHT SEPTIC TANKS REQUIRED

NOTE: CLEANOUT REQUIRED EVERY 70 FEET OF SEWER LINE AND/OR AT 90° SWEEPS IN LINES FROM HOUSE TO DRAIN FIELDS, 90° ELBOWS ARE NOT ACCEPTABLE

NOTE: ALL PARTS OF SEPTIC SYSTEMS (I.E. TANK, DISTRIBUTION BOX, DRAINFIELDS) TO BE 100 FEET FROM ANY WATER WELL UNLESS OTHERWISE SPECIFICALLY AUTHORIZED

NOTE: NO ABSORPTION TRENCH TO EXCEED 100 FEET IN LENGTH UNLESS SPECIFICALLY AUTHORIZED

NOTE: ALL PIPE FROM HOUSE TO SEPTIC TANK MUST BE CAST IRON OR SCHEDULE 35/40 PVC OR ABS


NOTE: MANHOLE RISERS REQUIRED ON ALL SEPTIC TANKS AND PUMP CHAMBERS

NOTE: DISTRIBUTION BOXES MUST HAVE BAFFLES

NOTE: IF PUMPED SEPTIC SYSTEM REQUIRED, (1) SEPTIC PUMP DETAIL TO BE PROVIDED BY INSTALLER PRIOR TO ISSUANCE OF SEPTIC PERMIT (2) PUMP PERFORMANCE TEST IS NECESSARY PRIOR TO HEALTH DEPARTMENT APPROVAL OF SEPTIC PERMIT

NEITHER THE HOWARD COUNTY COUNCIL NOR THE HEALTH DEPARTMENT IS RESPONSIBLE FOR THE
SUCCESSFUL OPERATION OF ANY SYSTEM
PERMITTEE RESPONSIBLE FOR OBTAINING FINAL APPROVAL ON THIS PERMIT
CALL 410-313-2640 FOR INSPECTION OF SEPTIC SYSTEM

P 515966

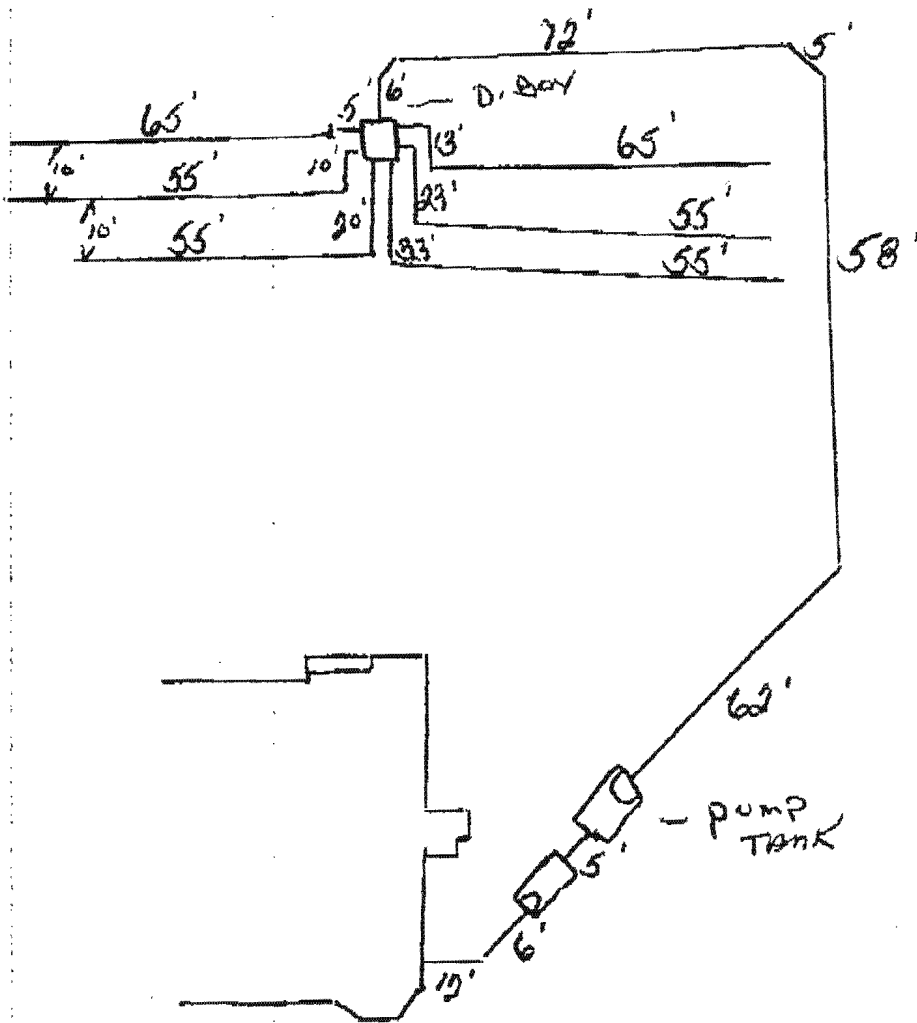

Jerry Hensberger
15600 Bushy Park Rd.

SITE INSPECTION SHEET

OWNER: _____ PHONE #: _____


ADDRESS: 15600 Bushy Park CONTRACTOR: _____

WELL TAG #: _____

SUBDIVISION: _____ LOT: 3 COUNTY #: _____

PROPOSAL: Confirm distance from Septic tank to proposed pool location

LOCATION DIAGRAM

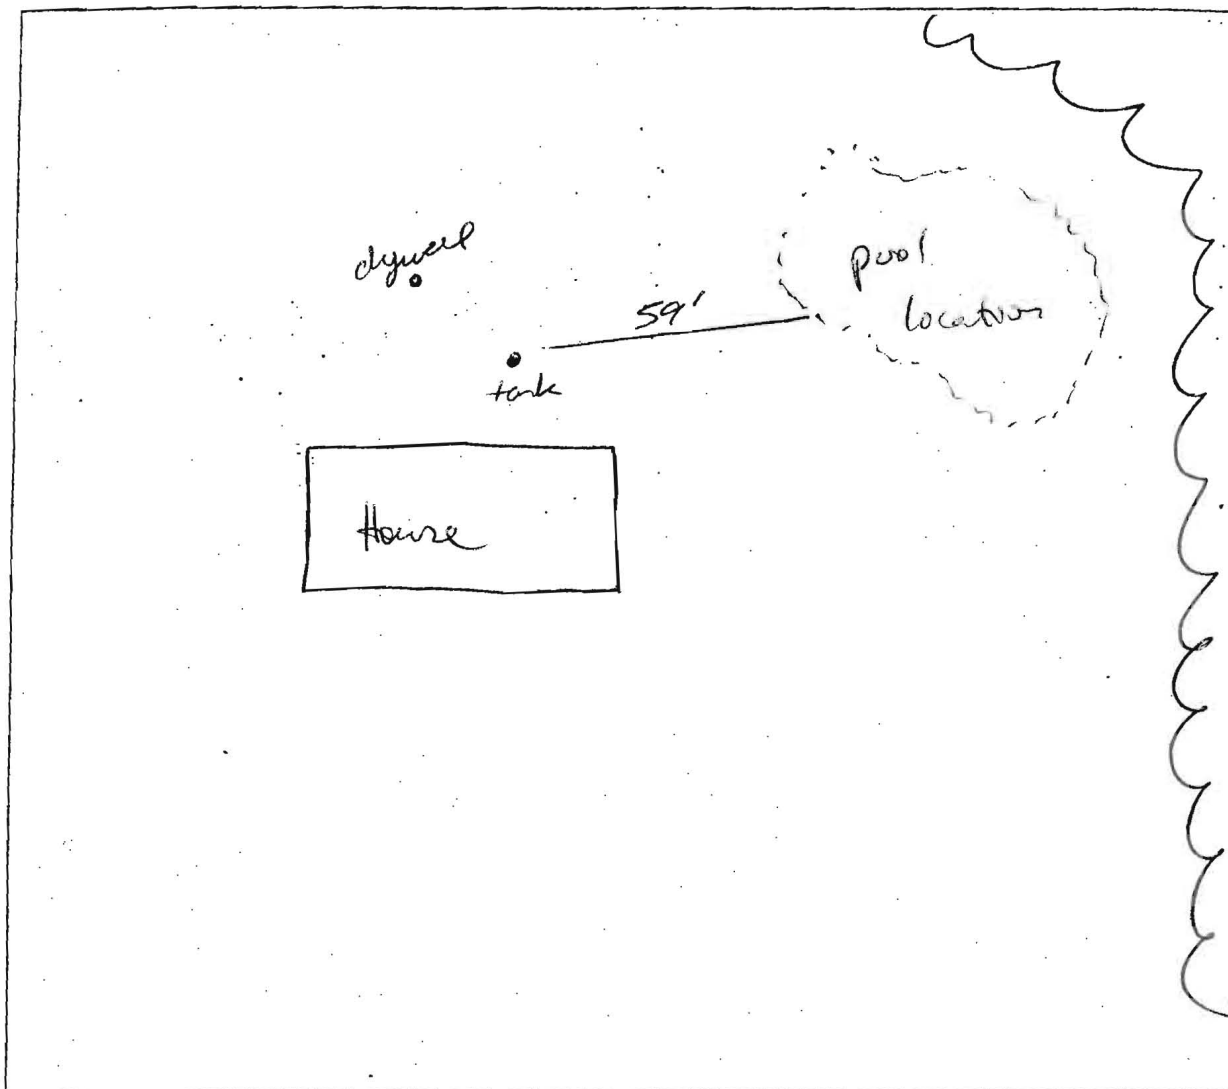

COMMENTS: Tank location same as field installation drawing 11/15/01. Tank is 59' from proposed pool location.

11/6/06 AH/SF



Approved Septic System Plan
Howard County Health Department

Mark Refkin 3/8/01
Signature Date

BASEMENT ELEV. 938	House to Left Bldg 80 FT.
FIRST FLOOR ELEV. 949	House to Front Bldg 90 FT.
SEPTIC TANK ELEV. 936	House to Right Bldg 55 FT.
Well ELEV. 956	House to Back Bldg 110 FT.
	House to Left Property Line 80 FT.
	House to Front Property Line 120 FT.
	House to Right Property Line 150 FT.
	House to Back Property Line 535 FT.
	THE MAP 20 (Parcel 208
	Fourth Election District
	zoning "Rc" DP+2 File

Total linear feet of trench required 350 feet
Width of trench(es) 3 feet
Depth of trench(es) 3 feet
Depth of stone required below distribution pipe 1 1/2 feet

INSTALL PRESSURE LINE AS SHOWN TO ALLOW POTENTIAL USE OF PREV. APPROVED AREA DOWNLOADED

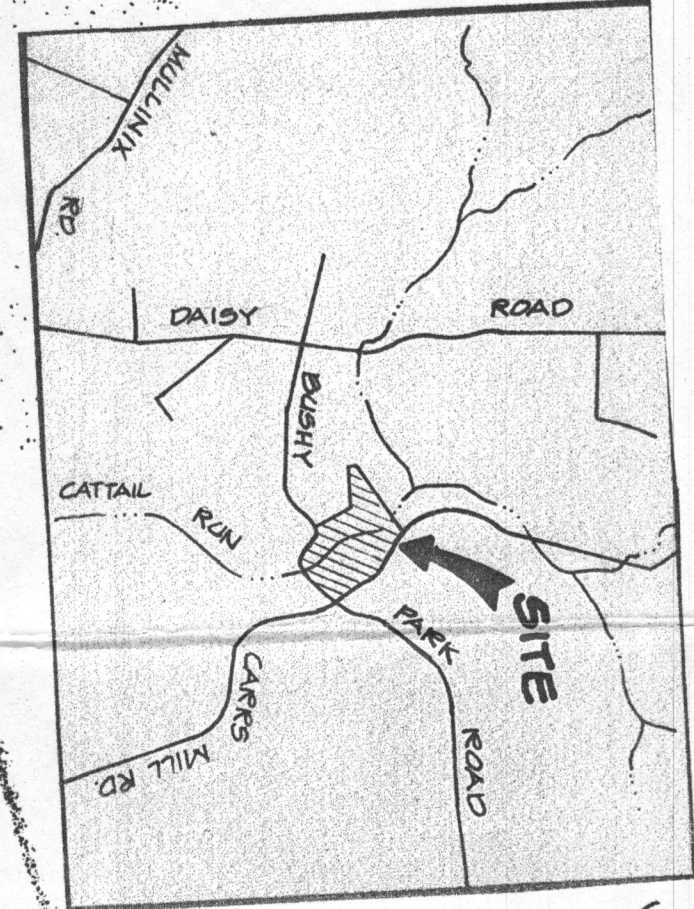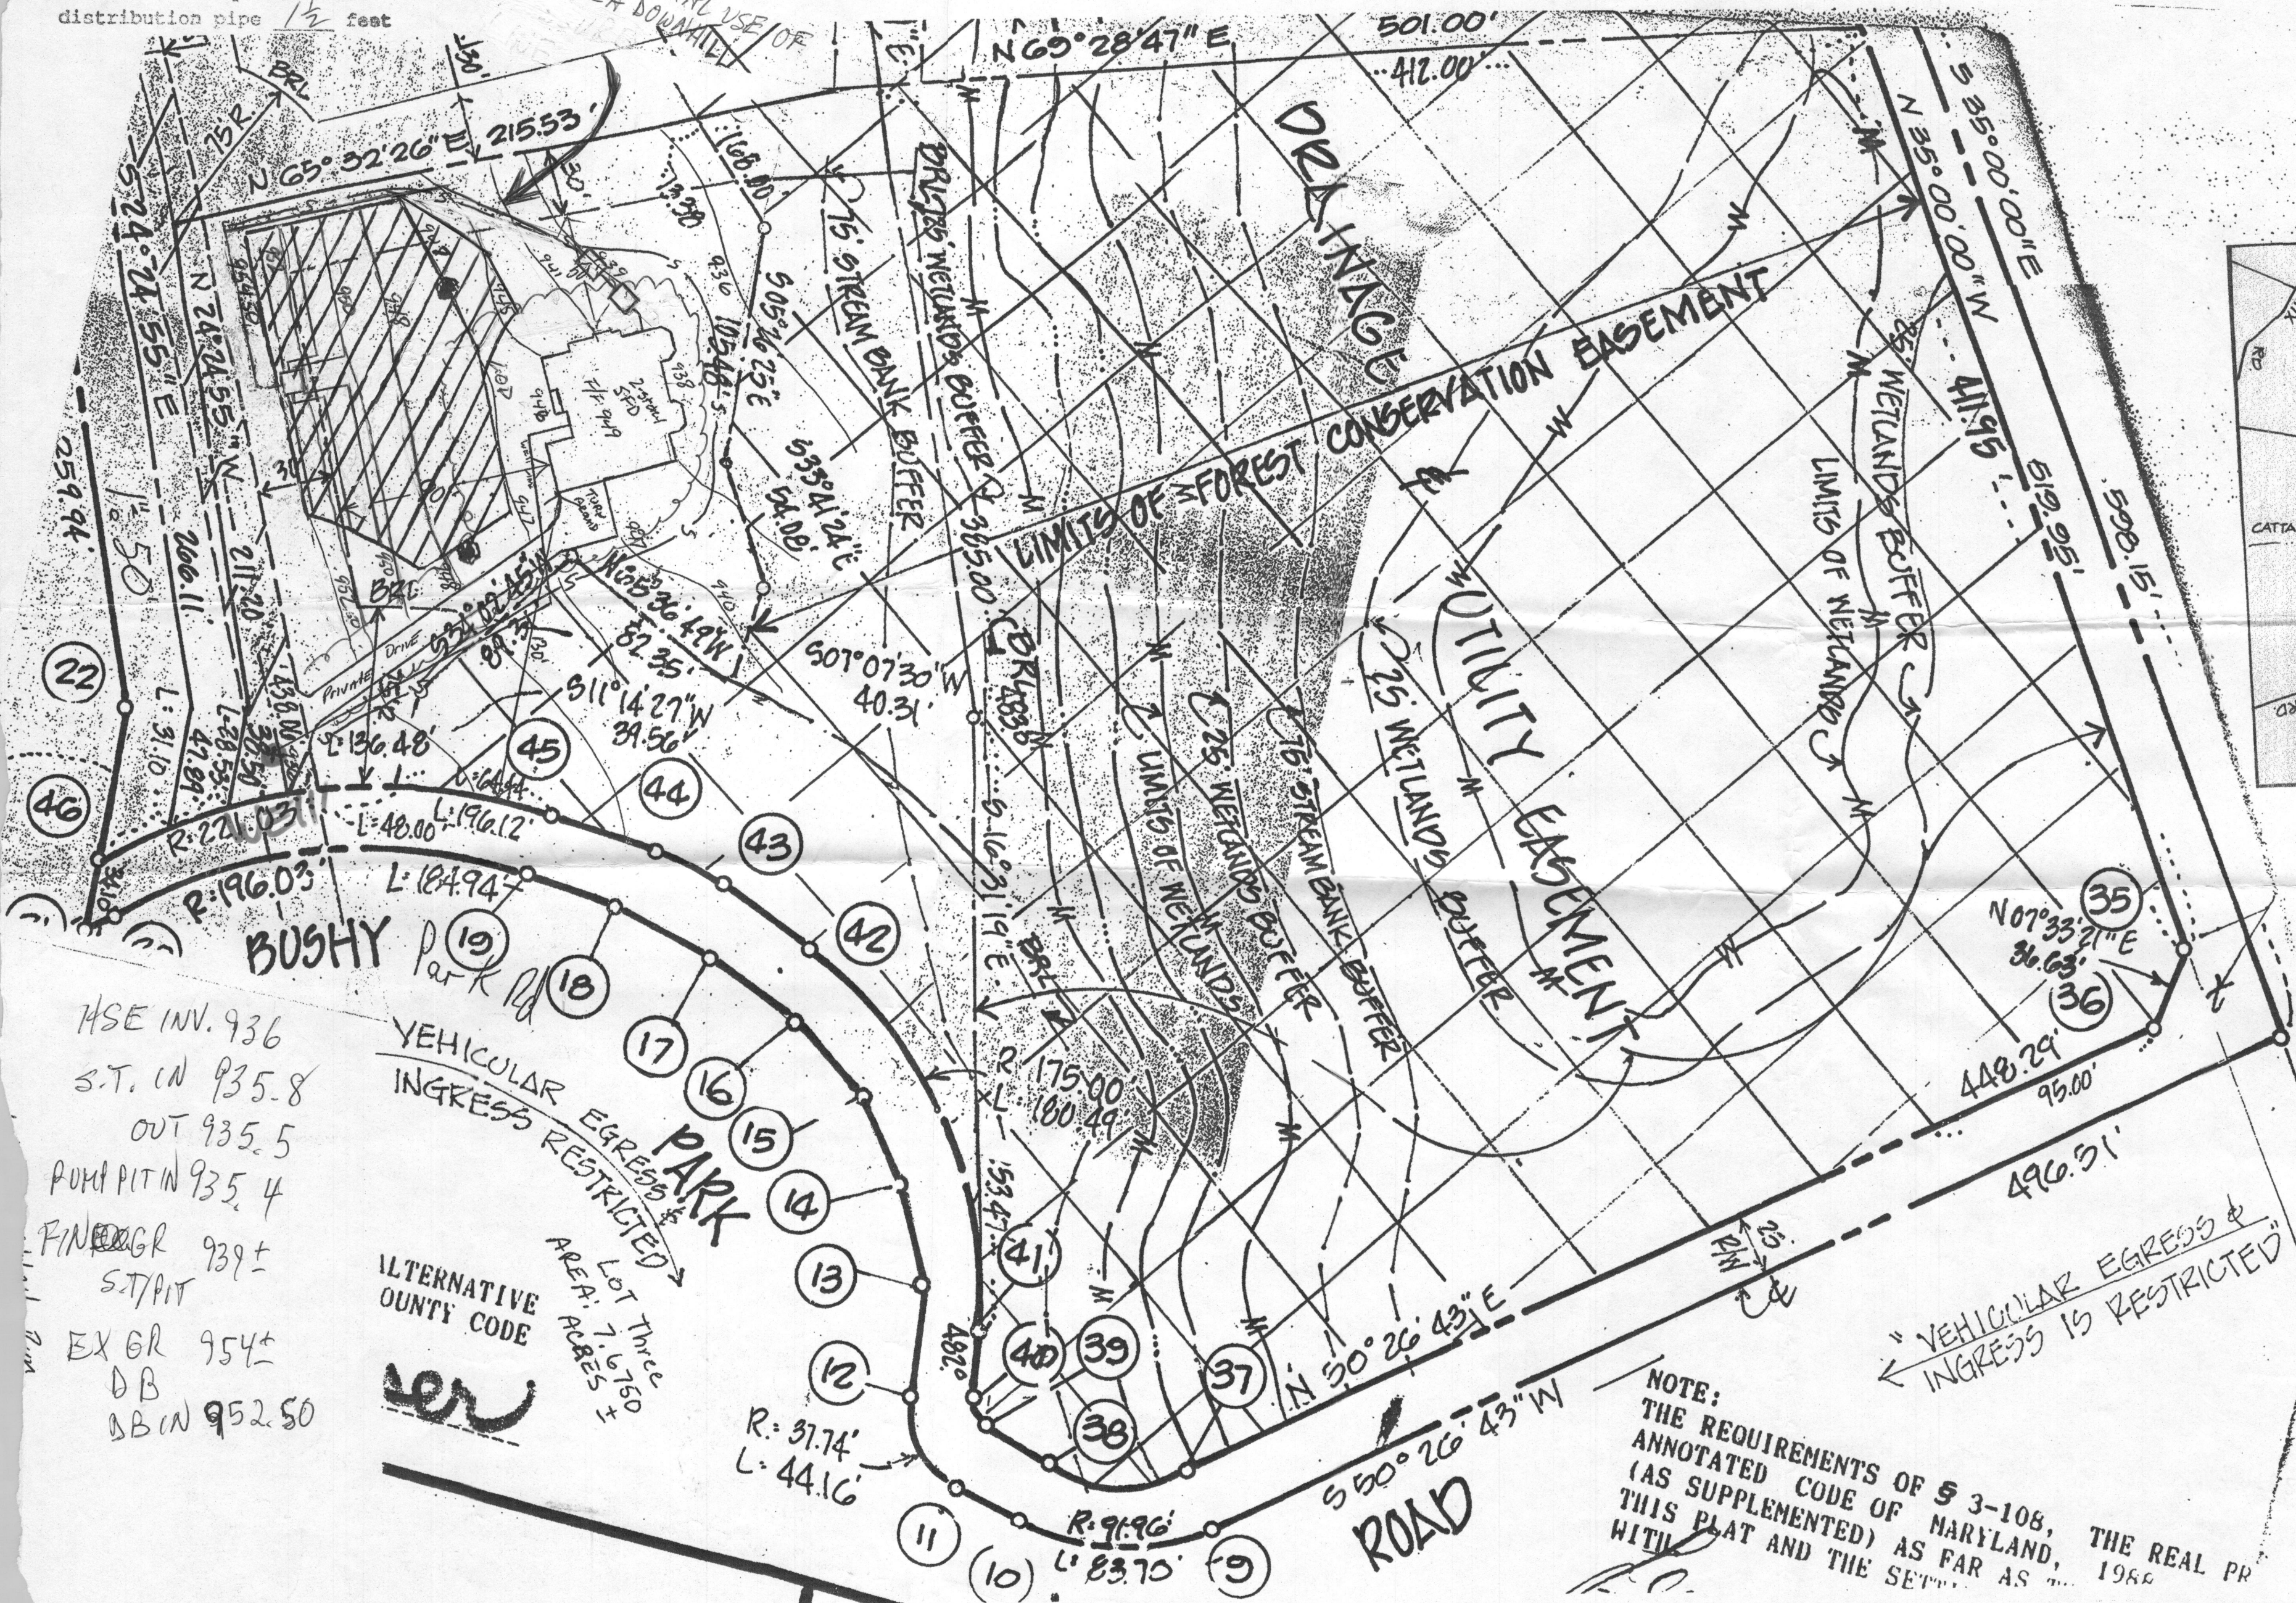

HSE INV. 936
S.T. IN 935.8
OUT 935.5
PUMP PIT IN 935.4
FINISH GR 939+
S.T. PIT
EX GR 954+
DB
DB IN 952.50

VEHICULAR EGRESS & INGRESS RESTRICTED
Lot Three
AREA: 7.6750 ACRES
ALTERNATIVE COUNTY CODE
er

NOTE:
THE REQUIREMENTS OF § 3-108, THE REAL PROPERTY EGRESS & INGRESS IS RESTRICTED
(AS SUPPLEMENTED) AS FAR AS THIS PLAT AND THE SET