

\*\*\*\*\*  
WATER WELL ABANDONMENT-SEALING REPORT FORM  
\*\*\*\*\*

SUBMIT COPIES OF COMPLETED FORM TO:

- \* COUNTY ENVIRONMENTAL AGENCY (contact MDE, WMA if address needed)
- \* WELL OWNER
- \* MDE, WATER MANAGEMENT ADMINISTRATION, WELL PROGRAM

DATE WELL ABANDONED: Aug 5 2013 (month/day/year)

\* PERMIT NUMBER OF ABANDONED WELL (if any)

\* PERMIT NUMBER OF REPLACEMENT WELL:

\* PERSON ABANDONING WELL: Ralph E Mayne WELL DRILLER'S LICENSE NUMBER: 117

CIRCLE: MWD / MSD / MGD

\* OWNER'S NAME: Land Design & Development

\* WELL LOCATION:

COUNTY: Howard

NEAREST TOWN: CLARKSVILLE

TAX MAP BLOCK PARCEL

SUBDIVISION: N/A


SECTION: LOT:

STREET ADDRESS: 12408 CLARKSVILLE MD

LATITUDE 39.20574

LONGITUDE 76.94313

SITE LOCATION MAP

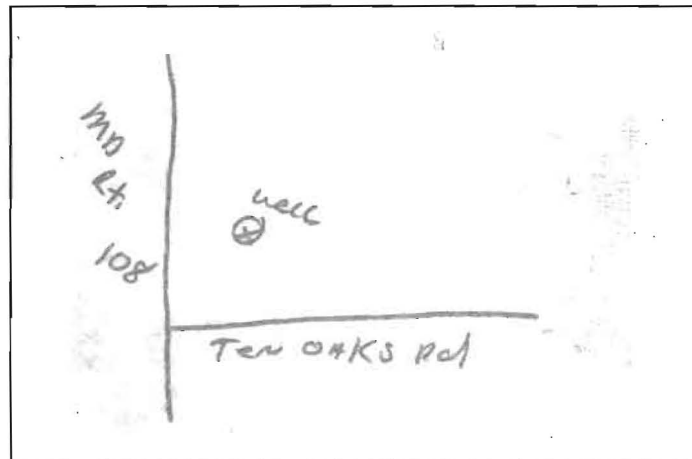

\* TYPE OF WELL BEING ABANDONED:

☒ DRILLED ☐ JETTED  
☐ BORED ☐ HAND DUG  
☐ OTHER (specify) \_\_\_\_\_

\* USE CODE: DOMESTIC

☐ IRRIGATION ☐ MUNICIPAL/PUBLIC  
☐ TEST/OBSERVATION ☐ INDUSTRIAL  
☐ ☐ GEOTHERMAL

\* TYPE OF CASING:

☒ STEEL ☐ PLASTIC  
☐ CONCRETE ☐ OTHER (specify) \_\_\_\_\_

SIZE OF CASING: 6" INCHES IN DIAMETER

DEPTH OF WELL: 200 FEET DEEP

WAS ANY CASING REMOVED? YES ☒ NO

If yes, length removed, in feet: \_\_\_\_\_

WAS CASING RIPPED OR PERFORATED? YES ☒ NO

LOG OF SEALING MATERIAL

MATERIAL	FEET	
	FROM	TO
Blue Joint	200	50
Cement	50	0

VOLUME OF MATERIAL USED

4 Ton Stone  
20 Bags Cement