

MARYLAND DEPARTMENT OF THE ENVIRONMENT, WATER MANAGEMENT ADMINISTRATION
1800 Washington Blvd., Baltimore, Maryland 21230 (410) 537-3784

WATER WELL ABANDONMENT-SEALING REPORT FORM

SUBMIT COPIES OF COMPLETED FORM TO:

- * COUNTY ENVIRONMENT AGENCY (contact MDE, WMA if address needed)
- * WELL OWNER
- * MDE, WATER MANAGEMENT ADMINISTRATION, WELL PROGRAM

DATE WELL ABANDONED: Sept. 30 2011 (month/day/year)

* PERMIT NUMBER OF ABANDONED WELL (if any) N/A

* PERMIT NUMBER OF REPLACEMENT WELL N/A

* PERSON ABANDONING WELL: Ralph E. Mayne


WELL DRILLERS LICENSE NUMBER: 117

CIRCLE: MWD/MSD/MGD

* OWNER'S NAME: Taylor Services

SITE LOCATION MAP

* WELL LOCATION:
COUNTY: Howard
NEAREST TOWN: ELLICOTT CITY
TAX MAP N/A BLOCK PARCEL
SUBDIVISION: N/A
SECTION: LOT:
NEAREST ROAD: 4109 COLLEGE AVE

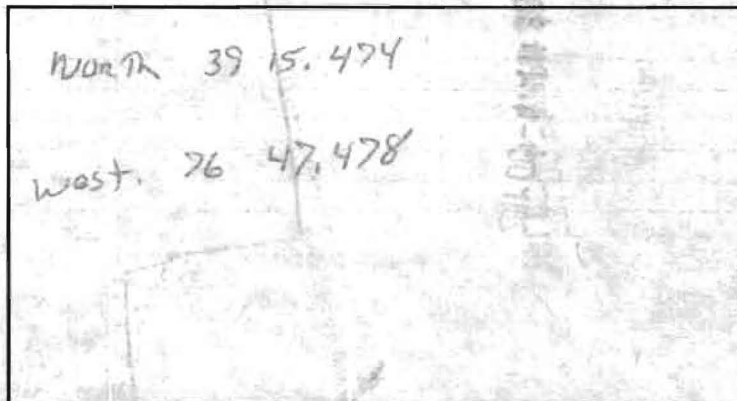

* TYPE OF WELL BEING ABANDONED:

☒ DRILLED ☐ JETTED
☐ BORED/AUGERED ☐ HAND DUG
☐ OTHER (specify)

* USE CODE:

☒ DOMESTIC ☐ MUNICIPAL/PUBLIC
☐ IRRIGATION ☐ INDUSTRIAL
☐ TEST/OBSERVATION ☐ GEOTHERMAL

* TYPE OF CASING:

☐ STEEL ☐ PLASTIC
☐ CONCRETE ☒ OTHER (specify) TARICATA

* SIZE OF CASING: 6 INCHES IN DIAMETER

* DEPTH OF WELL: 60 FEET DEEP

* WAS ANY CASING REMOVED? ☐ YES ☒ NO
if yes, length removed, in feet:

* WAS CASING RIPPED OR PERFORATED? ☐ YES ☒ NO

SIGNATURE-MASTER WELL DRILLER OR SUPERVISING SANITARIAN Ralph E. Mayne

LICENSE # 117

MWD/MSD/MGD Sept. 30 2011

DATE

DENV 828 JULY 1997

2) COUNTY ENVIRONMENTAL AGENCY