
 WATER WELL ABANDONMENT-SEALING REPORT FORM

SUBMIT COPIES OF COMPLETED FORM TO:

- * COUNTY ENVIRONMENTAL AGENCY (contact MDE, WMA if address needed)
- * WELL OWNER
- * MDE, WATER MANAGEMENT ADMINISTRATION, WELL PROGRAM

DATE WELL ABANDONED: 8-7-15 (month/day/year)

OK
 12/29/15 SC

* PERMIT NUMBER OF ABANDONED WELL (if any) _____

* PERMIT NUMBER OF REPLACEMENT WELL: _____

HO-95-2612


* PERSON ABANDONING WELL: Andrew Houseman

WELL DRILLER'S LICENSE NUMBER: 224

CIRCLE: MWD / MSD / MGD

* OWNER'S NAME: Catonsville Homes

SITE LOCATION MAP

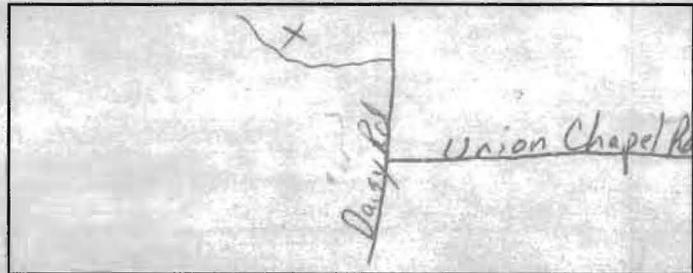

* WELL LOCATION:
 COUNTY: Howard
 NEAREST TOWN: Woodbine
 TAX MAP 0013 BLOCK 0012 PARCEL 0110
 SUBDIVISION: _____
 SECTION: _____ LOT: _____
 STREET ADDRESS: 2684 Daisy Rd

LATITUDE 3 9.302299

LONGITUDE 7 7.069625

LOG OF SEALING MATERIAL

MATERIAL	FEET	
	FROM	TO
<u>Cement</u>	<u>76</u>	<u>0</u>

* TYPE OF WELL BEING ABANDONED:

- DRILLED JETTED
- BORED HAND DUG
- OTHER (specify) _____

* USE CODE:

- DOMESTIC MUNICIPAL/PUBLIC
- IRRIGATION INDUSTRIAL
- TEST/OBSERVATION GEOTHERMAL

VOLUME OF MATERIAL USED

1.5 yards

* TYPE OF CASING:

- STEEL PLASTIC
- CONCRETE OTHER (specify) _____

SIZE OF CASING: 6 INCHES IN DIAMETER

DEPTH OF WELL: 80 FEET DEEP

WAS ANY CASING REMOVED? YES NO

If yes, length removed, in feet: _____

WAS CASING RIPPED OR PERFORATED? YES NO

Andrew K. Houseman MSD 224

MWD / MSD / MGS

8-7-15

SIGNATURE-MASTER WELL DRILLER OR SUPERVISING SANITARIAN LICENSE#

CIRCLE ONE

DATE

COUNTY

