

MARYLAND DEPARTMENT OF THE ENVIRONMENT, WATER MANAGEMENT ADMINISTRATION  
1800 Washington Blvd., Baltimore, Maryland 21230 (410) 537-3784

WATER WELL ABANDONMENT-SEALING REPORT FORM

SUBMIT COPIES OF COMPLETED FORM TO:

- \* COUNTY ENVIRONMENTAL AGENCY (contact MDE, WMA if address needed)
- \* WELL OWNER
- \* MDE, WATER MANAGEMENT ADMINISTRATION, WELL PROGRAM

DATE WELL ABANDONED: 04/12/15 (month/day/year)

\* PERMIT NUMBER OF ABANDONED WELL (if any)

\* PERMIT NUMBER OF REPLACEMENT WELL:

\* PERSON ABANDONING WELL: John Hess

WELL DRILLER'S LICENSE NUMBER:

CIRCLE: MWD / MSD / MGD

\* OWNER'S NAME: Thomas E Wahl

\* WELL LOCATION:

COUNTY: Howard

NEAREST TOWN: Ellicott City

TAX MAP 0025 BLOCK 0021 PARCEL 0194

SUBDIVISION:

SECTION:


LOT:

STREET ADDRESS: 4361 College Ave

LATITUDE 3

LONGITUDE 7

SITE LOCATION MAP

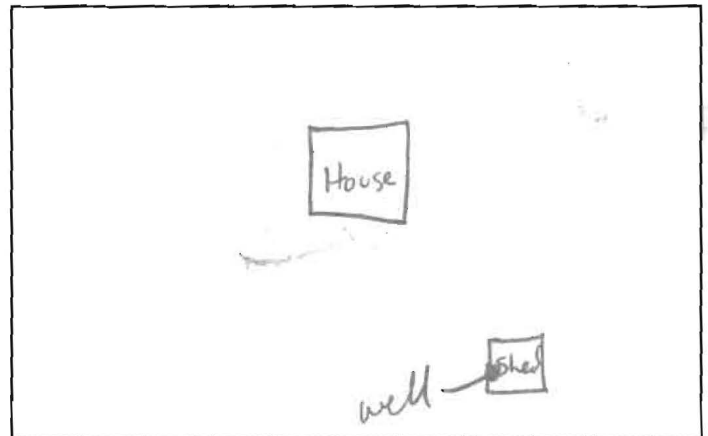

\* TYPE OF WELL BEING ABANDONED:

- ☒ DRILLED ☐ JETTED
- ☐ BORED ☐ HAND DUG
- ☐ OTHER (specify) \_\_\_\_\_

\* USE CODE:

- ☒ DOMESTIC ☐ MUNICIPAL/PUBLIC
- ☐ IRRIGATION ☐ INDUSTRIAL
- ☐ TEST/OBSERVATION ☐ GEOTHERMAL

\* TYPE OF CASING:

- ☒ STEEL ☐ PLASTIC
- ☐ CONCRETE ☐ OTHER (specify) \_\_\_\_\_

SIZE OF CASING: 6 INCHES IN DIAMETER

DEPTH OF WELL: 60 FEET DEEP

WAS ANY CASING REMOVED? YES ☒ NO

If yes, length removed, in feet: \_\_\_\_\_

WAS CASING RIPPED OR PERFORATED? YES ☒ NO

LOG OF SEALING MATERIAL

| MATERIAL                | FEET      |          |
|-------------------------|-----------|----------|
|                         | FROM      | TO       |
| <u>Pestonick Clay</u>   | <u>60</u> | <u>1</u> |
| <u>Cement</u>           | <u>1</u>  | <u>0</u> |
| VOLUME OF MATERIAL USED |           |          |
| <u>15 bags</u>          |           |          |

MWD / MSD / MGS

CIRCLE ONE

DATE

SIGNATURE MASTER WELL DRILLER OR SUPERVISING SANITARIAN LICENSE#

COUNTY