
APPLICATION

SEWAGE DISPOSAL TESTING

STATE OF MARYLAND - DEPARTMENT OF HEALTH A	AND MENTAL HYGIENE
HOWARD COUNTY HEALTH DEPARTMENT	DISTRICT Pifth
ENVIRONMENTAL HEALTH SERVICES	DATE 9/9/76
P. & BOX 476, ELLICOTT CITY, MARYLAND 21043	DATE
TELEPHONE: 465-5000, EXT. 356	
	Approx.
	All the state of t
	Barrie Con
,	A CONTRACTOR OF THE PROPERTY O
TO: THE COUNTY HEALTH OFFICER	A STATE OF THE STA
ELLICOTT CITY, MARYLAND	A CONTRACTOR OF THE CONTRACTOR
I, HEREBY, APPLY FOR THE NECESSARY TEST IN ORDER TO CONS	STRUGT (OR RECONSTRUCT) A SEWAGE
DISPOSAL SYSTEM.	A CONTRACTOR OF THE PARTY OF TH
The state of Allenda In	ν
PROPERTY OWNER Mr. and Mrs. Smith W. Allnutt, Jr.	
ADDRESS Highland MD 20777	PHONE 988-9305
ADDRESS	PHONE
PROPERTY LOCATION:	
PROPERTY ESCATION.	
SUBDIVISION Hi - Land Farm Estates	LOT NO
ROAD AND DESCRIPTION ROAD IN	
· gran	
	-A
SIZE OF LOT 1.84 Ac.	TYPE BLDG. 3 or 4 bedroom
25"	NUMBER OF BEDROOMS
IF NOT SINGLE RESIDENCE DESCRIBE	
THE SYSTEM INSTALLED UNDER THIS APPLICATION IS	ACCEPTABLE ONLY UNTIL PUBLIC
FACILITIES BECOME AVAILABLE.	
SIGNATURE OF APPLICANT /5/ Margaret G. Allnu	te
SIGNATURE OF APPLICANT	\
APPROVED BY AFFECT FORFOR	DATE
	SYSTEM)
REJECTED BY	DATE
IKINDOF	
HOLD PENDING FURTHER TESTS	DATE
y.	\ ,
REASONS FOR REJECTION OR HOLDING	
a'	1

THIS IS NOT A PERMIT

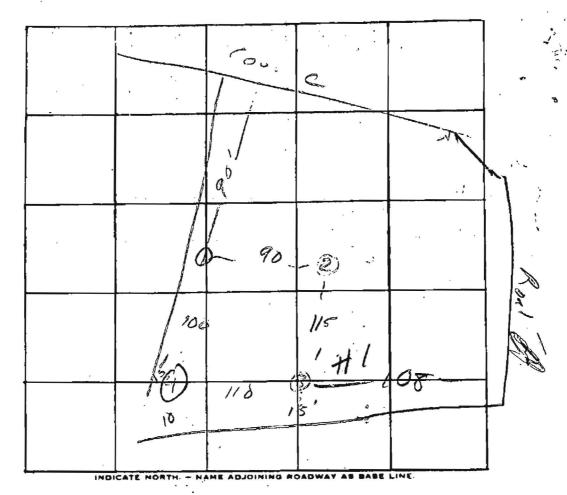

DATE	TEST NO.	DEPTH	PRE-WET START STOP		TEST - 1" DROP START STOP		TIME
1/53	.13	2/2	50 S	211	211	2/6	5
	d	131	7 53	£ 35	3 0 c-	211	6
	2 000	12'	- good	Ser, -	- 1		
	35	3//2	28.3	229	229	257	8
	d	131	224	225	285	2 20	2'
	4.5	¥°	216	217	217.	218	1
	d	190	216	2.18	25	2 31	3

REMARKS					-
TYPE OF SOIL _		•	,		
TESTED BY	Joy		ALSO PRESENT:	41 Herm	Allatt