

Bureau of Environmental Health
7178 Gateway Drive Columbia, MD 21046
(410) 313-2640 Fax (410) 313-2648
TDD (410) 313-2323 Toll Free 1-866-313-6300
website: www.hchealth.org

Maura J. Rossman, M.D., Health Officer

RECEIPT DATE: 5/29/14
INSTALLATION
APPROVAL
DATE: _____

ONSITE SEWAGE DISPOSAL SYSTEM

P 546379

PERMIT

A Repair

REPAIR

PROPERTY ADDRESS: 3330 Daisy Road

SUBDIVISION: _____ LOT: _____ TAX ID: 04-335848

CONTRACTOR: Fogles Septic Clean Inc. EMAIL: kevin@foglesinc.com

CONTRACTOR ADDRESS: 580 Obrecht Road, Sykesville, MD 21784 PHONE: 410-795-5670

PROPERTY OWNER: Kurt and Mary Krammer EMAIL: _____

OWNER ADDRESS: 3330 Daisy Road, Woodbine, MD 21797 PHONE: 301-802-7254

SEPTIC TANK SIZE (GALLONS): Existing

PUMP CHAMBER CAPACITY (GALLONS): N/a (future) STATIC HEAD (FEET): N/a

NUMBER OF BEDROOMS: 4 HOUSE SQ. FT. N/a APPLICATION RATE: _____

DISTRIBUTION SYSTEM: GRAVITY FED ☒ LOW PRESSURE DOSED ☐

| | | |
|-----------|---------------------------------------|---------------------------------------|
| TRENCHES: | LINEAR FEET REQUIRED: _____ | INLET DEPTH: _____ |
| | TRENCH WIDTH: _____ | MAXIMUM BOTTOM DEPTH: _____ |
| | MINIMUM SPACE BETWEEN TRENCHES: _____ | EFFECTIVE AREA BEGINNING DEPTH: _____ |
| | | |
| LOCATION: | | |
| NOTES: | | |

ISSUED BY: _____ ISSUE DATE: _____ EXPIRATION DATE: _____

NOTE: CONTRACTOR MUST SCHEDULE A PRE-CONSTRUCTION INSPECTION PRIOR TO BEGINNING ANY INSTALLATION

NOTE: CONTRACTOR MUST SCHEDULE AN INSPECTION AND GAIN APPROVAL OF ALL COMPONENTS PRIOR TO COVERING

NOTE: STONE MUST BE APPROVED BY HEALTH DEPARTMENT AND GRAVEL TICKET MUST BE AVAILABLE FOR REVIEW.

NOTE: WATERTIGHT SEPTIC TANKS REQUIRED

NOTE: ALL PARTS OF SEPTIC SYSTEM SHALL BE AT LEAST 100 FEET DOWNGRADIENT FROM ANY WATER WELL

NOTE: MANHOLE RISERS REQUIRED ON ALL SEPTIC TANKS AND PUMP CHAMBERS

NOTE: AN ELECTRICAL PERMIT IS REQUIRED FOR INSTALLATION OF ANY ELECTRICAL COMPONENTS OF THE SYSTEM

**NEITHER THE HOWARD COUNTY COUNCIL NOR THE HEALTH DEPARTMENT IS RESPONSIBLE FOR THE
SUCCESSFUL OPERATION OF ANY SYSTEM.**

PERMITTEE RESPONSIBLE FOR OBTAINING FINAL APPROVAL ON THIS PERMIT.

CALL 410-313-1771 TO SCHEDULE INSPECTIONS.

NOT TO SCALE

TRENCH/DRAINFIELD DATA

WIDTH INLET BOTTOM

NUMBER OF TRENCHES _____

TOTAL LENGTH _____

ABSORPTION AREA _____

DISTRIBUTION BOX LEVEL _____

DISTRIBUTION BOX BAFFLE _____

DISTRIBUTION BOX PORT _____

SEPTIC TANK DATA

SEPTIC TANK 1 LEVEL _____

MANUFACTURER _____

CAPACITY _____ GAL

SEAM LOC _____

TANK LID DEPTH _____

BAFFLES _____

BAFFLE FILTER _____

MANHOLE LOC _____

6" PORT LOC _____

WATERTIGHT TEST _____

SLOTTED _____

DATE ON LID _____

PUMP/SEPTIC TANK LEVEL _____

MANUFACTURER _____

CAPACITY _____ GAL

SEAM LOC _____

TANK LID DEPTH _____

BAFFLES _____

BAFFLE FILTER _____

MANHOLE LOC _____

6" PORT LOC _____

WATERTIGHT TEST _____

SLOTTED _____

DATE ON LID _____

ROAD NAME

PRE-CONSTRUCTION:

INSTALLATION:

FINAL INSPECTOR _____ DATE OF APPROVAL _____

Howard County Health Department

Bureau of Environmental Health, Ellicott City, Maryland 410-313-2640

SEWAGE DISPOSAL PERMIT NO. A- _____ P- 546379

PERMITTEE

Fogles Septic Clean Inc.

LOCATION

3330 Daisy Road Daisy Woods Lot 3
Catherine Krammer

Do Not Cover Work Until Health Department Approval Appears On This Card

POST THIS CARD WHERE IT CAN BE SEEN FROM ROAD

☐

STOP ALL CONSTRUCTION ON SEWAGE
DISPOSAL SYSTEM AND CONTACT HEALTH
DEPARTMENT BEFORE CONTINUING

☐

WORK IS SATISFACTORY,
CONTINUE

Inspector

Date

Inspector

Date

☐

FINAL INSPECTION MADE,
COVER ALL WORK

Inspector

Date

PERMIT

SEWAGE DISPOSAL SYSTEM

MARYLAND STATE DEPARTMENT OF HEALTH

HOWARD COUNTY

INDEXED

ELLICOTT CITY

DISTRICT 4th

DATE 11/21/77

1/11/78
3/1/78
Piggen, Inc. (phone: 489-7242)

James Zimmerman

IS PERMITTED TO INSTALL ☒ ALTER

ADDRESS 3330 Daisy Road

PHONE

A SEWAGE DISPOSAL SYSTEM LOCATED AT

SUBDIVISION

ROAD 3330 Daisy Rd.

LOT 3

PROPERTY OWNER James Zimmerman

ADDRESS 3330 Daisy Rd.

SPECIFICATIONS 4 bedrooms

DRAIN FIELD DEPTH FEET, BOTTOM AREA SQ. FT.

SEEPAGE PITS ABSORBENT SIDE-WALL AREA SQ. FT.

SEPTIC TANK CAPACITY 1250 GALLONS

Garbage Disposal - 1500 gallon septic tank

FOR GARBAGE GRINDER, INCREASE DISPOSAL AREA 22% & TANK CAPACITY 50%.

OTHER DRY WELL to have 125 sq. ft. effective ~~max~~ absorbent sidewall area per bedroom ~~show~~ inlet. Inlet to be 4 ft. below original grade and maximum depth 11 ft. Location: 95 ft. off left property and 125 ft. from ~~front~~ front property line when facing lot from road (perc hole 1 & 2).

NOTE: ALL PIPE FROM HOUSE TO DISPOSAL AREA MUST BE CAST IRON. PERMIT VOID AFTER 3 YEARS.

NOTE: INSTALL STAND PIPES ON SEPTIC TANK AND DRY WELL. STAND PIPES MUST BE 6 INCHES IN DIAMETER. CAST IRON, CONCRETE OR TERRA COTTA ACCEPTED.


PLANS APPROVED BY C. B. Streaker

DATE 11/18/76

FILL SEPTIC TANK AND DISTRIBUTION BOX WITH WATER BEFORE CALLING FOR AN INSPECTION. COVER NO WORK UNTIL INSPECTED AND APPROVED.

NEITHER THE HOWARD COUNTY COMMISSIONERS NOR THE HEALTH DEPARTMENT IS RESPONSIBLE FOR THE SUCCESSFUL OPERATION OF ANY SYSTEM.

22983

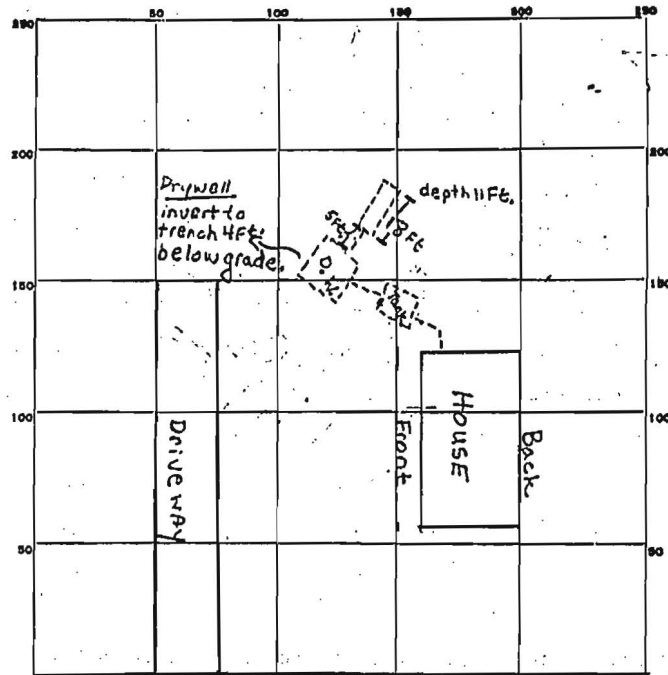

INDICATE NORTH. - NAME ADJOINING ROADWAY AS BASE LINE.

Daisy Rd.

PERMIT CARD Yes

S.T. D.W.

SEPTIC TANK, LEVEL ✓

CLEANOUTS ✓

DISTRIBUTION BOX, LEVEL NA

Trench
TILE FIELD, DEPTH 11 FT. TRENCH WIDTH 2 FT.

GRAVEL DEPTH 7 IN. TOTAL LENGTH 18 FT. ①

NUMBER OF TRENCHES 1 TOTAL BOTTOM AREA 126

SEEPAGE PITS, INSIDE DIAMETER outside perimeter 60 FT. DEPTH BELOW INLET 7 FT. ②

ABSORBENT AREA 420 ± SQ. FT. ③ 546

REMARKS (1/2/78 discussed over phone)
with Mr. 2 in morning
see house plans

1/2/78 Told them to go ahead and put in gravel, but to install a 1500 gallon
Septic Tank 2/17/78.

DATE SYSTEM APPROVED 2/11/78 INSPECTOR RB