

A514952-F
COUNTY #

NOT TO SCALE

Lot 34

SOIL PROFILE

714/714B

red-brown clay

orange-brown sandy loam

25-35% ROCK FRAGS

715/716A

red-brown clay

tan-sandy loam

5-15% ROCK FRAGS

716

red-brown clay

tan sandy loam

20-30% ROCK FRAGS

14'

SOIL PROFILE

717

red-brown clay

tan-sandy loam


20-30% ROCK FRAGS

718/719/719A

red-brown clay loam

tan-sandy loam

30-40% ROCK FRAGS

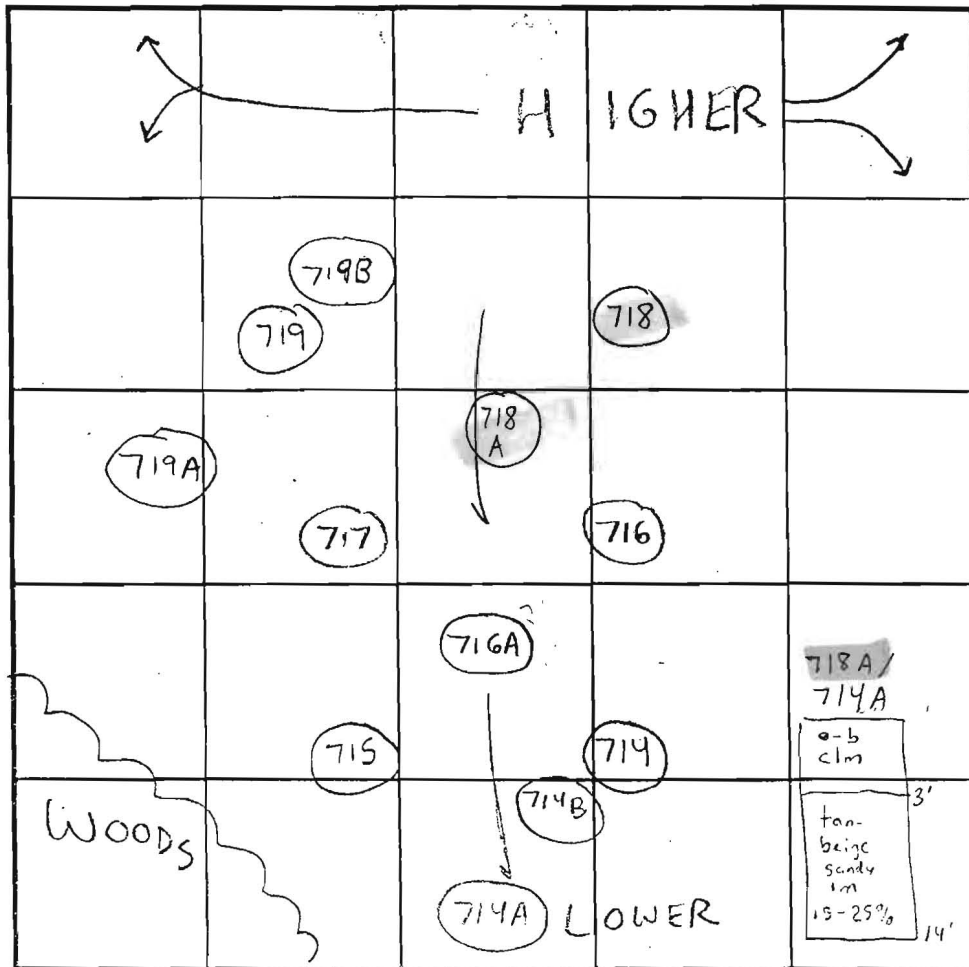

INDICATE NORTH - NAME ADJOINING ROADWAY AS BASE LINE.

13'5" - 14'

DATE	TEST NO.	DEPTH	PRE-WET		TEST - 1" DROP		TIME	
			START	STOP	START	STOP		
7/25/01	714	4'T 13'V	3:05pm	3:08pm	3:08pm	3:12pm	4min	OK
2/1/02 *	714B	7'T 13'5"V	1:45pm	1:50pm	1:50pm	1:55pm	5min	OK
	714A	7'T 13'5"V	1:50pm	1:52pm	1:52pm	1:58pm	4min	OK
7/25/01	715	5'5" T 13'V	3:19pm	3:20pm	3:20pm	3:23pm	3min	OK
2/1/02	716A	13'5"V	(VISUAL)	OK	SEE SOIL PROFILE			OK
7/25/01	716	5'T 14'V	3:45pm	3:48pm	3:48pm	3:50pm	2min	OK
	717	5'T 13'5"V	4:01pm	4:05pm	4:05pm	4:08pm	3min	OK
2/1/02	718A	14'V	(VISUAL)	OK	SEE SOIL PROFILE			OK
7/25/02	718	5'T 14'V	4:14pm	4:18pm	4:18pm	4:20pm	2min	OK
	719	5'T 14'V	4:31pm	4:36pm	4:36pm	4:37pm	2min	OK
2/1/02 *	719A/B	8'T 13'5"V	1:06pm	1:10pm	1:10pm	1:15pm	5min	OK

REMARKS * Tested in treatment zone - Shallow System Only!

TYPE OF SOIL Glenelg

TESTED BY SRK

ALSO PRESENT Chuck Sharp

TRENCH DESIGN DATA: AVERAGE PERCOLATION TIME 5min

TRENCH WIDTH 3'

INLET DEPTH 2

MAXIMUM BOTTOM DEPTH 4.5'

SQ. FT./BEDROOM 180

F.03122 Signed 8/26/03

**ENVIRONMENTAL
NON-BUILDABLE
RESERVATION
PARCEL 'B'**

1.65 Ac± Total
This sheet 0.67 Ac±
Privately owned and
maintained. Easement
holders: H.O.A. and
Howard County,
Maryland

Land dedicated to
Howard County, Maryland
for the purpose
of a public road.
This sheet 0.09 Ac±

**DAISY ROAD
(MAJOR COLLECTOR)
(PUBLIC COUNTY ROAD)**

Vehicle
ingress and
egress is
restricted.

**ELEANORS
GARDEN
WAY**
(PUBLIC ACCESS PLAZA)

MATCHLINE

LOT 21
56,930sf±

LOT 23
41,232sf±

LOT 22
45,496sf±

LOT 25
45,262sf±

LOT 44
42,423sf±

LOT 34
49,376sf±

LOT 35
44,550sf±

LOT 35
40,161sf±

SEE SH

