

12/14/71
12/23/71
Randy

12/14/71
Note checked. OK.
12/23/71
F.F.C.R.T.
Fruit C.O. OK P.T.

File INDEXED

PERMIT

SEWAGE DISPOSAL SYSTEM

P 165321
A 15922

MARYLAND STATE DEPARTMENT OF HEALTH

HOWARD COUNTY

ELLICOTT CITY

DISTRICT 2

DATE 12/8/71

Francis Collins IS PERMITTED TO INSTALL X ALTER

ADDRESS 8475 Old Frederick Road, Ellicott City, Md. PHONE 465-1659

A SEWAGE DISPOSAL SYSTEM LOCATED AT _____

SUBDIVISION _____ ROAD Daniels Rd. (see application for better directions) LOT _____

PROPERTY OWNER Francis & Joan Collins

ADDRESS _____

SPECIFICATIONS - 3 bedrooms

DRAIN FIELD _____ DEPTH _____ FEET. BOTTOM AREA _____ SQ. FT.

SEEPAGE PITS _____ ABSORBENT SIDE-WALL AREA _____ SQ. FT.

SEPTIC TANK CAPACITY 1,000 GALLONS

FOR GARBAGE GRINDER, INCREASE DISPOSAL AREA 22% & TANK CAPACITY 50%.

OTHER Dry well - 300 sq. ft. absorbent sidewall area to begin below the inlet.

Maximum depth permitted for dry well is 9 1/2 ft. below original grade. Locate dry well

60 ft. from left side line and 60 ft. from rear property line as seen from Daniels

Road. Well has to be at least 75 ft. and upgrade from septic system. ~~AND~~ AND SEPTIC
SYSTEM HAVE TO BE INSTALLED BEFORE BUILDING PERMIT IS RELEASED.

NOTE: ALL PIPE FROM HOUSE TO SEPTIC TANK MUST BE CAST IRON.

PERMIT VOID AFTER THREE YEARS.

PLANS APPROVED BY Robert Torre DATE 11/16/71

NOTE: INSTALL STAND PIPE ON SEPTIC TANK AND DRY WELL.

FILL SEPTIC TANK AND DISTRIBUTION BOX WITH WATER BEFORE CALLING FOR AN INSPECTION. COVER NO WORK
UNTIL INSPECTED AND APPROVED.

NEITHER THE HOWARD COUNTY COMMISSIONERS NOR THE HEALTH DEPARTMENT IS RESPONSIBLE FOR THE
SUCCESSFUL OPERATION OF ANY SYSTEM.

A 15922




Free State Home Builders, Inc.

RT. 1 • BOX 264 • MANCHESTER, MD.

374-6390

A15922

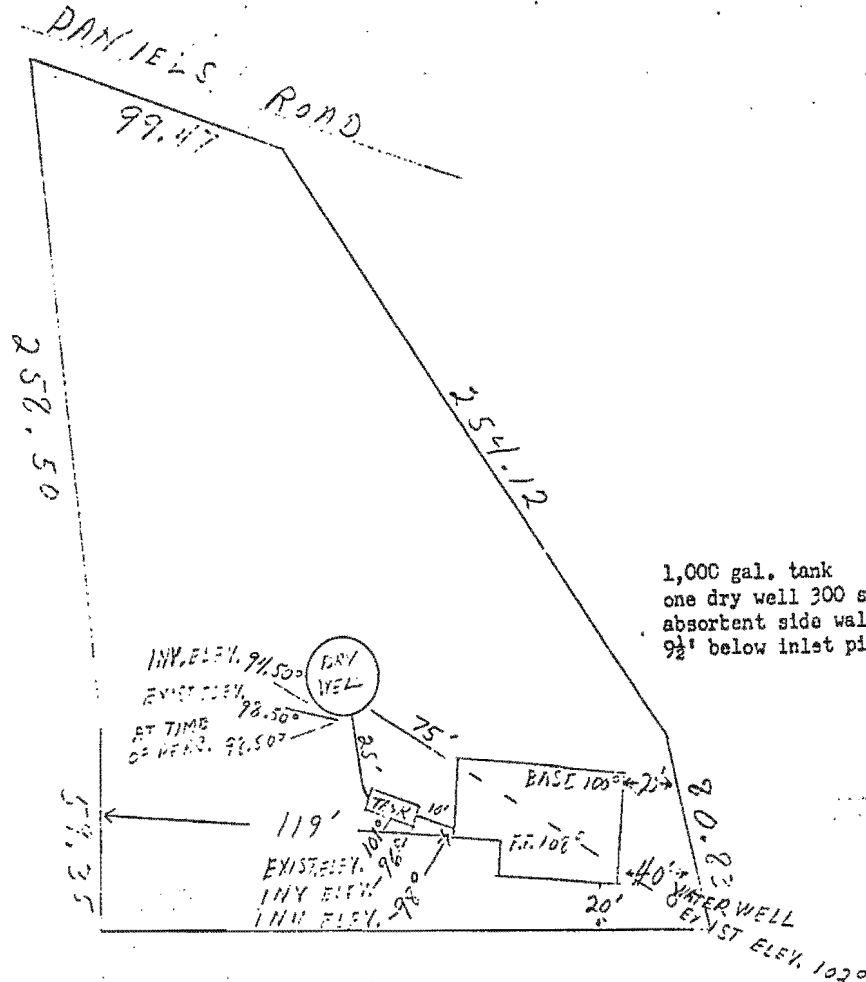

1,000 gal. tank
one dry well 300 sq. ft.
absorbent side wall area
9 1/2' below inlet pipe.

Lot #5 Sec. #2 John C. Kuhn Sub-division

I certify the above measurements and elevations are actual & correct for this property.

Signed: John B. Kuhn, Jr.

Phone: 239 8105

5/6/71
9:30
2:30

5/6/71 Final OK.
R. Toner

PERMIT

SEWAGE DISPOSAL SYSTEM

MARYLAND STATE DEPARTMENT OF HEALTH

HOWARD COUNTY

INDEXED

P 15924

A

ELLICOTT CITY

DISTRICT 5

DATE 4/30/71

Jack Pyock IS PERMITTED TO INSTALL ALTER X

ADDRESS Ten Oaks Road, Glenelg, Maryland PHONE 286-2939

A SEWAGE DISPOSAL SYSTEM LOCATED AT

SUBDIVISION 2255 ROAD Route 216 LOT

PROPERTY OWNER Richard Arron

ADDRESS

SPECIFICATIONS

DRAIN FIELD DEPTH FEET, BOTTOM AREA SQ. FT.

SEEPAGE PITS ADSORBENT SIDE-WALL AREA SQ. FT.

SEPTIC TANK CAPACITY GALLONS

FOR GARBAGE GRINDER, INCREASE DISPOSAL AREA 22% & TANK CAPACITY 50%.

OTHER REPAIR - Call for inspection of ground when opened and Sanitarian

will recommend repair system.


Clay on top then sandy loam & water
4 ft trench - 6 ft. of gravel

PLANS APPROVED BY Palmer F. Wine DATE 5/3/71

FILL SEPTIC TANK AND DISTRIBUTION BOX WITH WATER BEFORE CALLING FOR AN INSPECTION. COVER NO WORK UNTIL INSPECTED AND APPROVED.

NEITHER THE HOWARD COUNTY COMMISSIONERS NOR THE HEALTH DEPARTMENT IS RESPONSIBLE FOR THE SUCCESSFUL OPERATION OF ANY SYSTEM.

215924

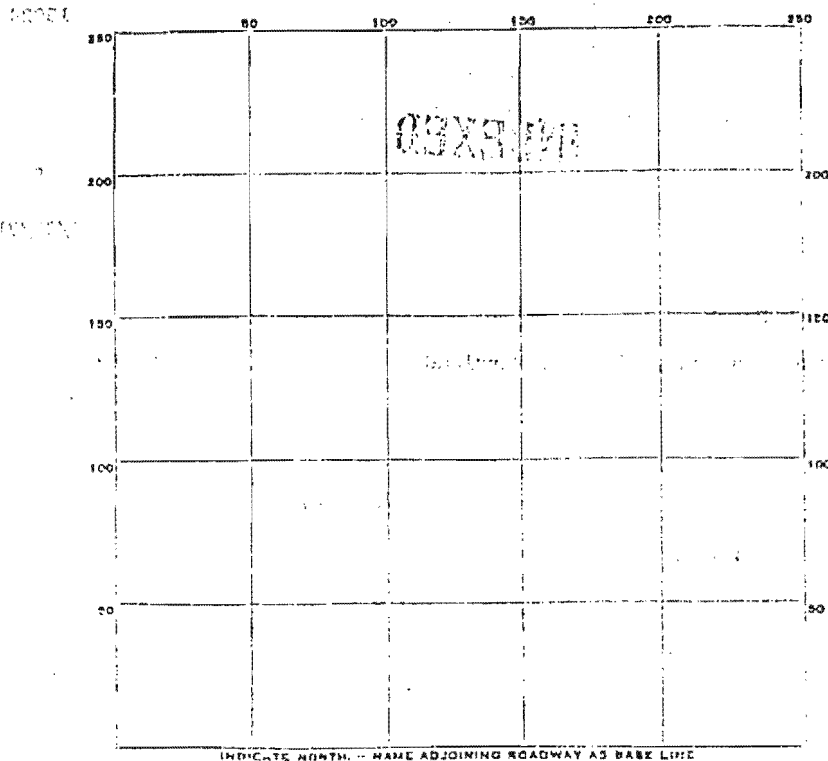

PERMIT CARD

Signed

SEPTIC TANK, LEVEL

CLEANOUTS

DISTRIBUTION BOX, LEVEL

Trench

TILE FIELD, DEPTH

8'

FT.

TRENCH WIDTH

18 in

IN

GRAVEL DEPTH

6 ft

FT.

TOTAL LENGTH

40

FT.

NUMBER OF TRENCHES

1

Side wall

TOTAL BOTTOM AREA

480 sq. ft.

SEEPAGE FITS, INSIDE DIAMETER

FT.

DEPTH BELOW INLET

FT.

ABSORBENT AREA

SQ. FT.

REMARKS

DATE SYSTEM APPROVED

5/6/21

INSPECTOR

R. Tume