

APPLICATION

SEWAGE DISPOSAL TESTING

MARYLAND STATE DEPARTMENT OF HEALTH

HOWARD COUNTY *Septic Tank - 1000 gal.*

ELLICOTT CITY

Dry Well - 300 sq. ft. abundant, sidewalk area

DISTRICT *2*

DATE *4-30-71*

To begin below the outlet. Maximum depth permitted for dry well is 9 1/2 ft. below original grade. Locate dry well 60 ft. from depth water line and 60 ft. from rear property line as shown. Daniels Rd. Well has to be at least 75 ft. and upgrade

TO: THE COUNTY HEALTH OFFICER, *from Septic System. Well Septic System*
ELLICOTT CITY, MARYLAND

I, HEREBY, APPLY FOR THE NECESSARY TESTS IN ORDER TO CONSTRUCT OR RECONSTRUCT *WELL Septic System*
DISPOSAL SYSTEM.

PROPERTY OWNER *Joan Collins*

ADDRESS *8475 Old Frederick Rd., E.C., Md.*

PHONE *465-1659*

PROPERTY LOCATION:

SUBDIVISION

LOT NO.

ROAD AND DESCRIPTION *Daniels Rd., Ellicott City, Md.*

off Old Frederick Rd. left on Daniels 6th Driveway on right.

OCCUPANT

PHONE

PERSON TO CONSTRUCT SYSTEM

ADDRESS

PHONE

Single Family Dwelling

SIZE OF LOT *one acre +*

TYPE BLDG. *3 - Bedrooms*

NUMBER OF BEDROOMS

IF NOT SINGLE RESIDENCE DESCRIBE

SIGNATURE OF APPLICANT *Joan Collins*

APPROVED BY *Robert V. Ture*

FOR *Dry Well*

DATE *11/16/71*

REJECTED BY

FOR


DATE

HOLD PENDING FURTHER TESTS *Robert V. Ture*

DATE *1/1/71*

REASONS FOR REJECTION OR HOLDING

THIS IS NOT A PERMIT

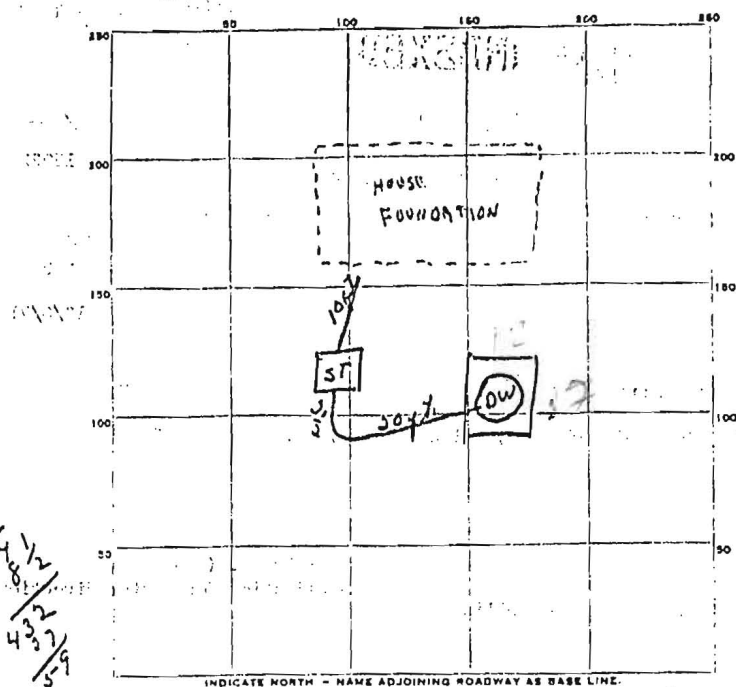

2644
22/4 1/2
5-8
432
437
5-9
4

PERMIT CARD _____

SEPTIC TANK, LEVEL OK 10092 CLEANOUTS OK

DISTRIBUTION BOX, LEVEL _____

TILE FIELD, DEPTH _____ FT. TRENCH WIDTH _____ FT.

GRAVEL DEPTH _____ IN. TOTAL LENGTH _____ FT.

NUMBER OF TRENCHES _____ TOTAL BOTTOM AREA _____

SEE PAGE PITS, outside perimeter 12113Y14Y15 FT. DEPTH BELOW INLET 7 1/2 FT.

ABSORBENT AREA 459 SQ. FT.


REMARKS 12/14/71 - Checked location and depth (10ft). Same approved to
continue
R.T.F.F.

12/20/71 ALL PIPE IS CAST IRON.

SEWER LINE NOT CONNECTED TO HOUSE.

5ft to house will be installed by plumber.

DATE SYSTEM APPROVED 12/20/71 INSPECTOR R. Toner

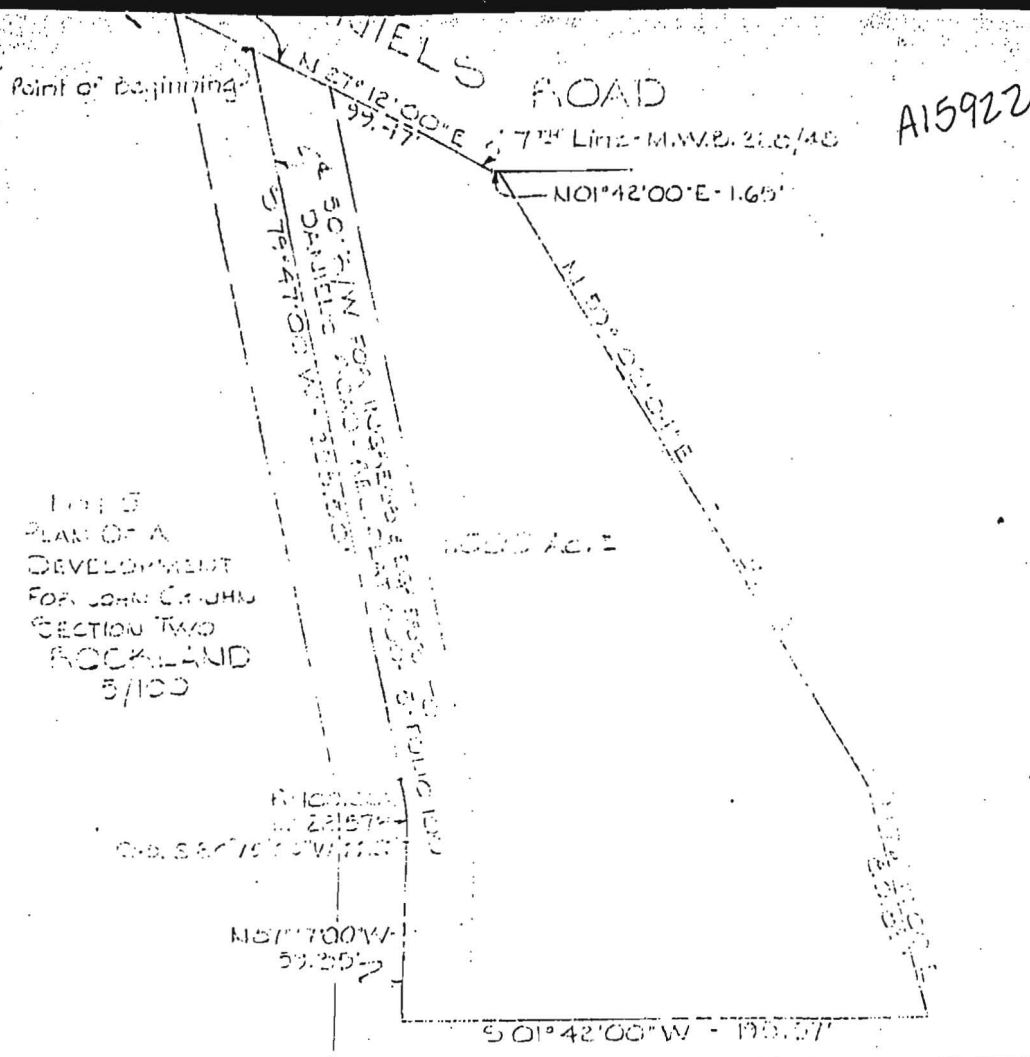

THIS
 PLAN OF A
 DEVELOPMENT
 FOR JOHN C. KUHN
 SECTION TWO
 ROCKLAND
 5/100

APPROVED: FOR PRIVATE WATER AND PRIVATE SEWERAGE SYSTEM, HOWARD COUNTY HEALTH DEPT.

[Signature] 3/18/71
 County Health Officer Date

PARCEL TO BE CONVEYED BY
 JOHN C. KUHN, ET AL.
 COLLECTION DISTRICT
 MARCH 31, 1971



WILLIAM G. JESCHKE
 ENGINEER & LAND SURVEYOR
 3677 PARK AVENUE
 ELLICOTT CITY, MD 21043







Recess
measured
from day
you will be
poc hole repaired
for repair
over in
1997





possible
repair
area
french
presented
Barney
plate
H



20' 1/2' 25% sloped

proposed reflection room

St. Joseph's



