

177
8/30/77
9/13/77
final
PERMIT

SEWAGE DISPOSAL SYSTEM

MARYLAND STATE DEPARTMENT OF HEALTH

HOWARD COUNTY

ELLICOTT CITY

DISTRICT 3rd

DATE 6/17/87

03-283968
INDEXED

Paul E. Petenbrink

IS PERMITTED TO INSTALL X ALTER

ADDRESS 506 Heath Ave. Linthicum, Md. PHONE 636 4044

A SEWAGE DISPOSAL SYSTEM LOCATED AT

SUBDIVISION Dickey Farms ROAD Day Rd. LOT 33

PROPERTY OWNER Paul E. Petenbrink

ADDRESS 506 Heath Ave. Linthicum, Md.

SPECIFICATIONS 4 Bedrooms

DRAIN FIELD DEPTH FEET, BOTTOM AREA SQ. FT.

SEEPAGE PITS ABSORBENT SIDE-WALL AREA SQ. FT.

SEPTIC TANK CAPACITY 1500 GALLONS

FOR GARBAGE GRINDER, INCREASE DISPOSAL AREA 22% & TANK CAPACITY 50%.

OTHER DRY WELL & TRENCH - to have 135 sq. feet effective absorbent sidewall area per bedroom. Dry well inlet to be 2 feet & maximum depth 8 feet. Dry well to be located 130 feet from Road and 10 feet from right lot line. Trench to be 30 feet and total absorption area 180 square feet. Trench inlet 2 feet and maximum depth 8 feet. Trench to run towards rear of lot, from a point 40 feet from right property line 130 from road, on the contour.

NOTE: ALL PIPE FROM HOUSE TO DISPOSAL AREA MUST BE CAST IRON. PERMIT VOID AFTER THREE YEARS.


PLANS APPROVED BY David J. O'Neill DATE 6/17/77
NOTE: INSTALL STAND PIPE ON SEPTIC TANK AND DRY WELL. STAND PIPES MUST BE 6 INCHES IN DIAMETER. CAST IRON, CONCRETE OR TERRA COTTA AXCEPTED.

FILL SEPTIC TANK AND DISTRIBUTION BOX WITH WATER BEFORE CALLING FOR AN INSPECTION. COVER NO WORK UNTIL INSPECTED AND APPROVED.

NEITHER THE HOWARD COUNTY COMMISSIONERS NOR THE HEALTH DEPARTMENT IS RESPONSIBLE FOR THE SUCCESSFUL OPERATION OF ANY SYSTEM.

BLDG. PERMIT SIGNED
AND RETURNED 5/10/85
Serial # 64767-
P.M.

25057

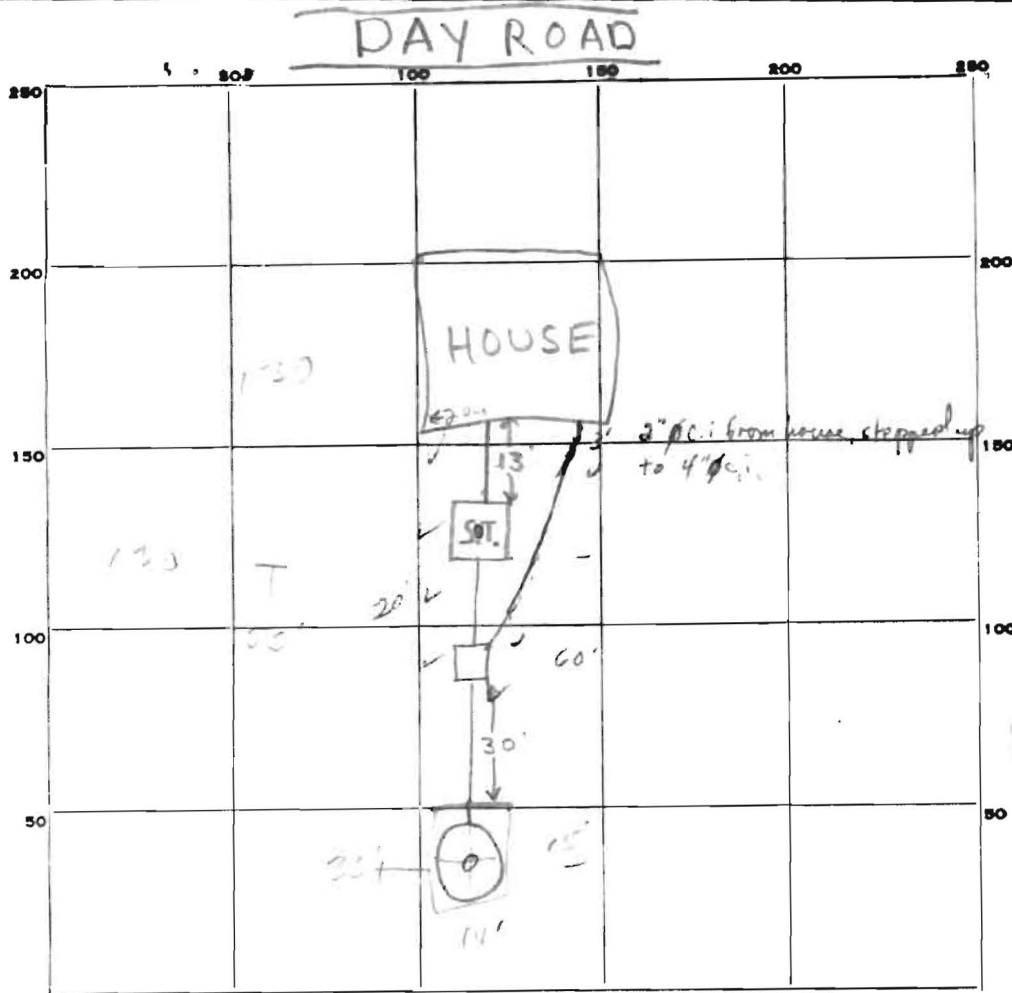

INDICATE NORTH. - NAME ADJOINING ROADWAY AS BASE LINE.

PERMIT CARD None 9/13/77 TSD

S.T. D.W.

SEPTIC TANK, LEVEL ✓

CLEANOUTS ✓

DISTRIBUTION BOX, LEVEL ✓

TILE FIELD, DEPTH FT. TRENCH WIDTH FT.

GRAVEL DEPTH IN. TOTAL LENGTH FT.

NUMBER OF TRENCHES TOTAL BOTTOM AREA

SEEPAGE PITS, ^{OUTSIDE PERIMETER} 58' INSIDE DIAMETER FT. DEPTH BELOW INLET 12 FT.

ABSORBENT AREA SQ. FT.

REMARKS

55' to, 5' back, 25' d.
 9/2/77 Septic tank now 13' from house; 30' of cast iron preceding drywell is installed; Distribution box not yet installed; 2" ϕ c.i. line to be hooked up directly from Kitchen to D.Box. F.S. Nothing done 9-9-77 DB + Lines installed
 9/13/77 T.S.G.: All work covered except 25' of pipe from kitchen corner towards (dist. box?)


DATE SYSTEM APPROVED

9/19/77

INSPECTOR

[Signature]

DAY ROAD

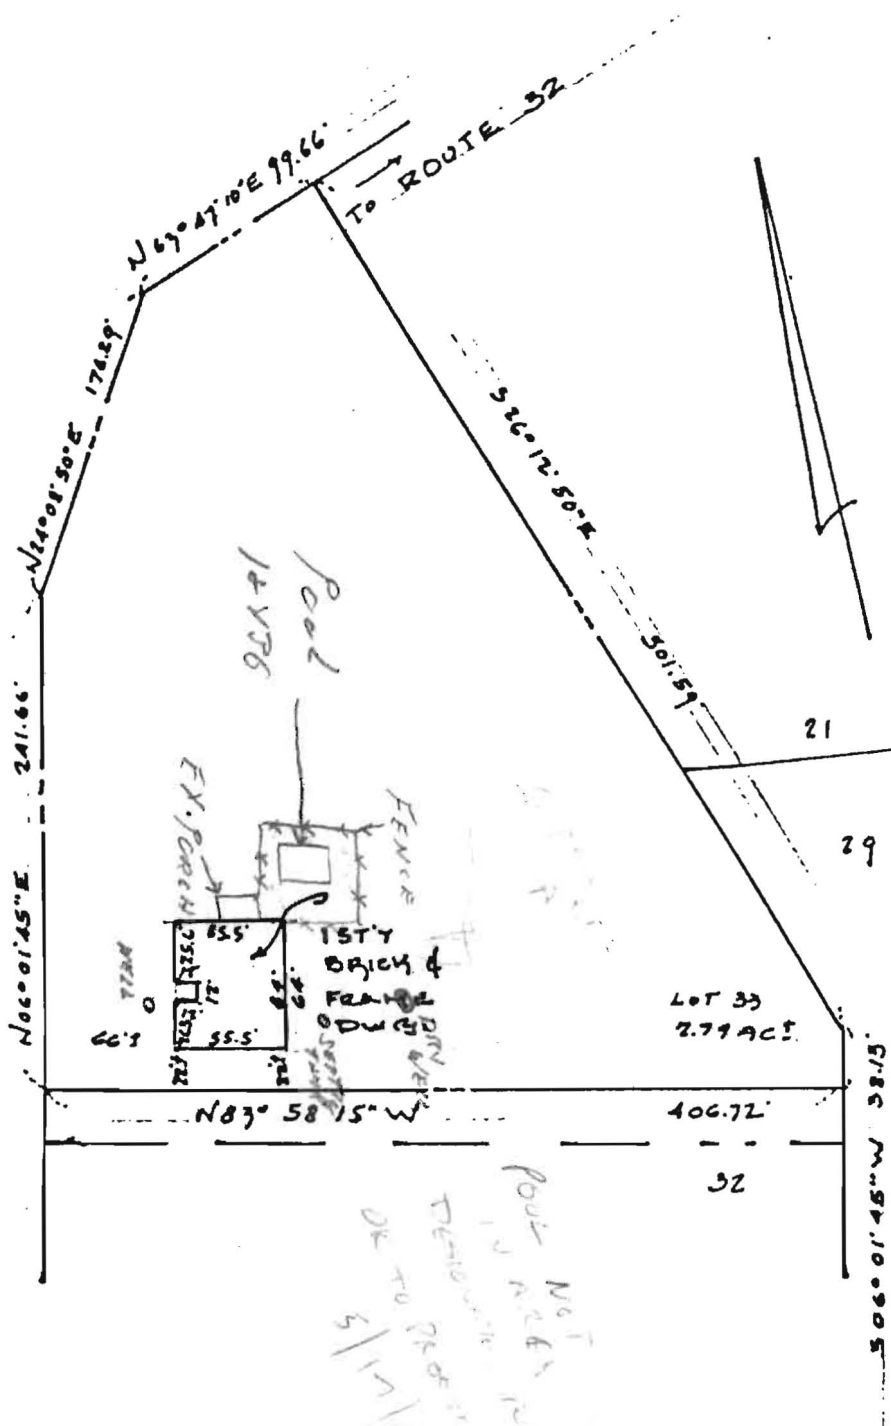

CERTIFICATION

This is to certify that I have surveyed the property known as: 1029

DAY ROAD

SEAL



SCALE: 1"=100'

DATE: 3-2-1978

AXEL F. LOEN