


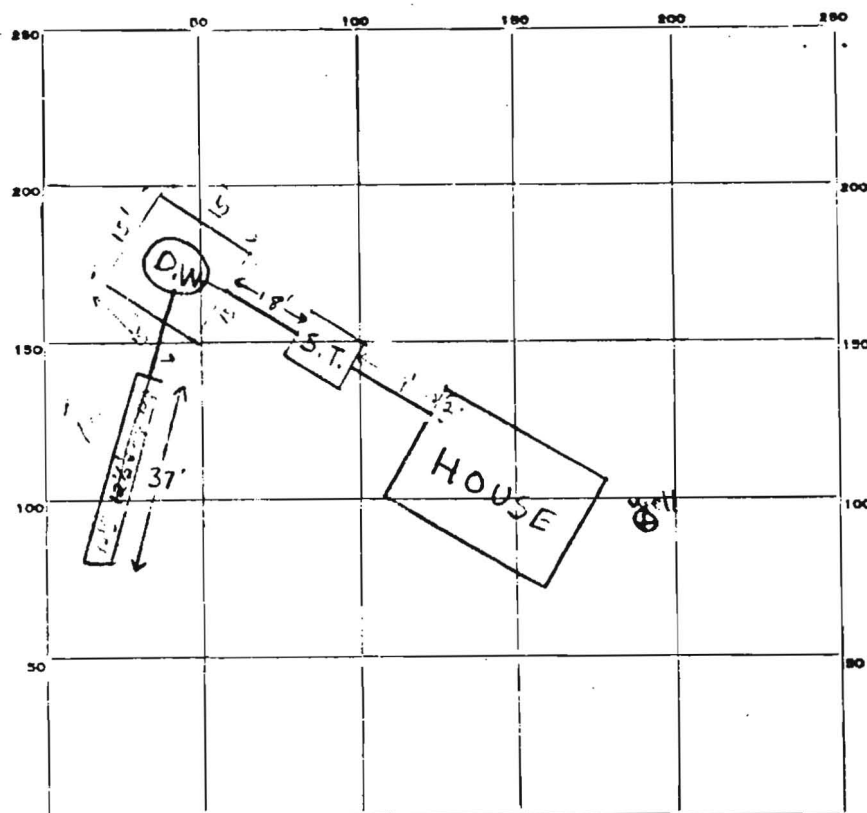

INDICATE NORTH. NAME ADJOINING ROADWAY. & BASE LINE.

DAY ROAD (ent)

PERMIT CARD *(signed for OK)*

SEPTIC TANK, LEVEL ✓ 1250 gal

CLEANOUTS

S.T.	D.W.
✓	✓

DISTRIBUTION BOX, LEVEL n.a.

TILE FIELD, DEPTH 12 1/2 FT. TRENCH WIDTH 2 FT.

GRAVEL DEPTH 7 1/2 FT. TOTAL LENGTH 37 FT.

NUMBER OF TRENCHES 1 1/2 SIDEWALL TOTAL BOTTOM AREA 277.5

SEEPAGE PITS, OUTSIDE PERIMETER 60 FT. DEPTH BELOW INLET 8 1/2 FT.

Drywell Abs. area 510

Total ABSORBENT AREA 788 SQ. FT.

REMARKS 6/5/77 M-gravel in drywell & trench. O.K. to install gravel & pipe in drywell & trench. Call for final insp. before covering drywell & trench. FS & TO.

6/9/77 No A y.c. 6/8 insp (DW is about 1/2 stone) wuz.

DATE SYSTEM APPROVED 6/11/77

INSPECTOR T. J. J.

Property known as:


LINDER 222-7040 702

THIRD ELECTION DISTRICT

HOWARD COUNTY, MD.

THIS PLAT CAN NOT BE USED TO ESTABLISH PROPERTY
LINES OR CORNERS.

DAY ROAD

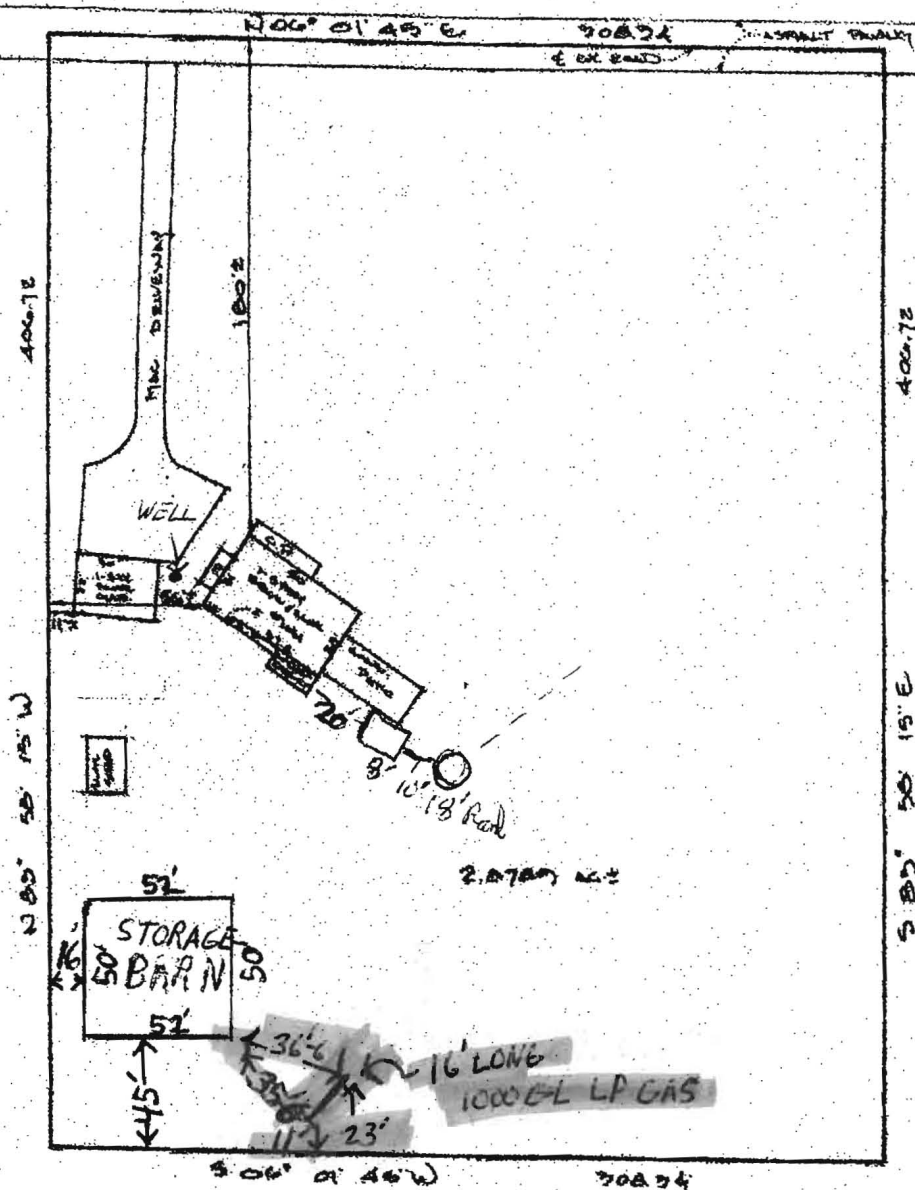

LOCATION SURVEY PLAT

SUBJECT PROPERTY NOT LOCATED IN A FLOOD PLAIN AREA UNLESS OTHERWISE NOTED

CERTIFICATION	SEAL	SCALE 1" = 60' DATE 7-26-1999
This is to certify that I have surveyed the property known as: <u>DAY ROAD</u> for the purpose of locating the improvements thereon, and the improvements are located as shown.	Walter Paul	LAND DESIGN ENGINEERING, INC. SUITE 210 10620 OUILFORD ROAD JESSUP, MARYLAND 20794 980-0034 (BALT) 604-6264 (WASH) 604-6735 (FAX)