

APPLICATION

A 25052

SEWAGE DISPOSAL TESTING

P _____

STATE OF MARYLAND - DEPARTMENT OF HEALTH AND MENTAL HYGIENE

HOWARD COUNTY HEALTH DEPARTMENT
ENVIRONMENTAL HEALTH SERVICES

P. O. BOX 476, ELLICOTT CITY, MARYLAND 21043
TELEPHONE: 465-5000, EXT. 356

DISTRICT 3rd

DATE 12/27/76

300-100 gal.
4 B. E. - 125 gal.

135 #/bedroom

inlet 4 ft. below O.B.

max. 10 ft. " "

well located 100' from center of the road
and 20' from the right side property line as
seen from the property from the road.

TO: THE COUNTY HEALTH OFFICER
ELLICOTT CITY, MARYLAND

I, HEREBY, APPLY FOR THE NECESSARY TEST IN ORDER TO CONSTRUCT (OR RECONSTRUCT) A SEWAGE DISPOSAL SYSTEM.

PROPERTY OWNER

Charles Wohlend. Picky property

ADDRESS

Ellen St. Ct., Mt.

PHONE

465-8755

PROPERTY LOCATION:

Jeffrey Sunderland
6154 Clearbrook Ct.

SUBDIVISION

Picky Farms. Col. Md. 21045

LOT NO.

7

ROAD AND DESCRIPTION

off Day Road

SIZE OF LOT

4,1940

TYPE BLDG.

3

NUMBER OF BEDROOMS

IF NOT SINGLE RESIDENCE DESCRIBE _____

THE SYSTEM INSTALLED UNDER THIS APPLICATION IS ACCEPTABLE ONLY UNTIL PUBLIC FACILITIES BECOME AVAILABLE.

SIGNATURE OF APPLICANT

Albert Wohlend

APPROVED BY _____

FOR _____

DATE _____

(KIND OF SYSTEM)

REJECTED BY _____

FOR _____

DATE _____

(KIND OF SYSTEM)

HOLD PENDING FURTHER TESTS _____

DATE _____


REASONS FOR REJECTION OR HOLDING _____

Please see above well too close to perc. test

holes - fill & seal well and see

2/11 retest hole

THIS IS NOT A PERMIT

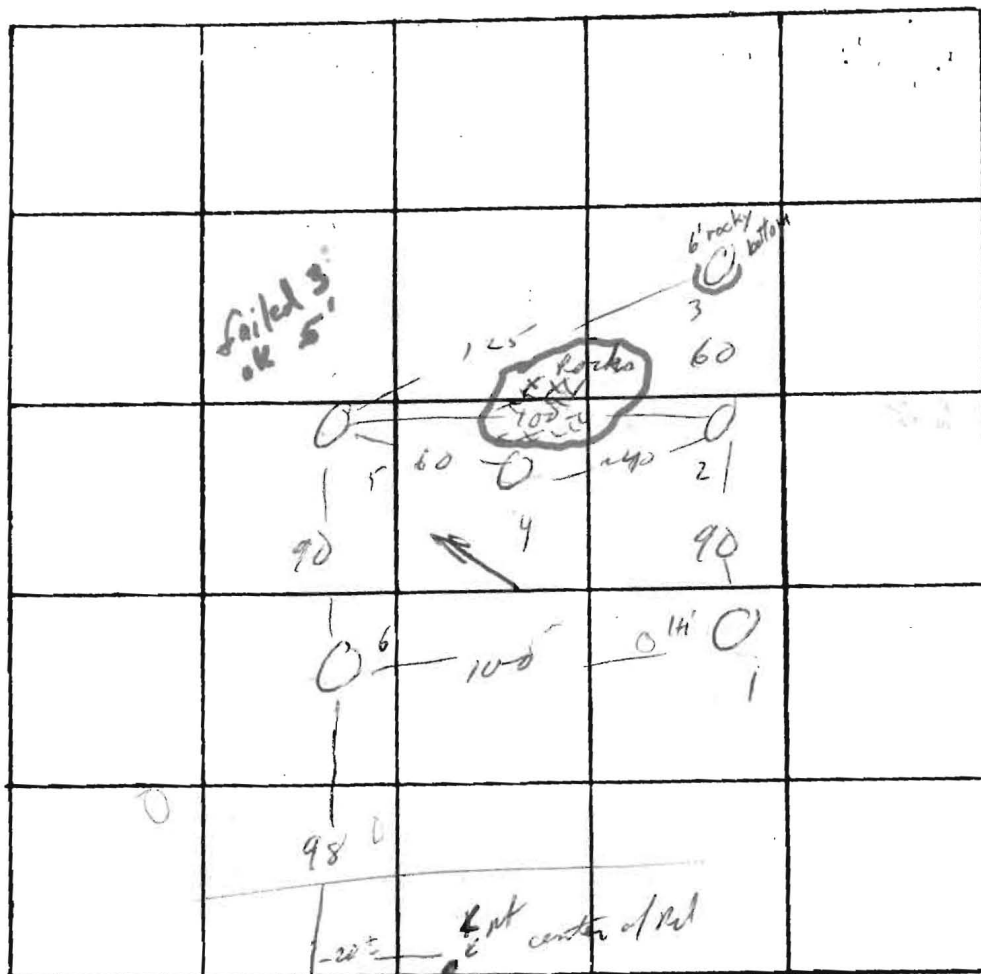

DATE	TEST NO.	DEPTH	PRE-WET		TEST - 1" DROP		TIME
			START	STOP	START	STOP	
4/6/73	1	4 $\frac{1}{2}$	1126	1130	1130	1135	5
	1A	13 $\frac{1}{2}$	1128	1134	1134	1150	16
	2	12 $\frac{1}{2}$	1131	1141	1141	1150	9
	2A	3	1138	1135	1135	1141	6
	(3)	6	rocky		bottom		
	4	11	sandy				
	6	13	vis				
	(5A)	3	1137	almost 1" by 12"			230
	5	12 $\frac{1}{2}$	1137	1141	1141	1150	9
	5B	5	1200	1207	1207	1220	13

TYPE OF SOIL

TESTED BY

ALSO PRESENT:

● = OLD TEST

Ⓢ = EXIST WELL

① = RETEST PERC

② = RETEST
VISUAL HOLE


THE LOT SHOWN HEREON COMPLIES
WITH THE MINIMUM OWNERSHIP
WIDTH AND LOT AREA AS REQUIRED
BY THE MARYLAND STATE DEPT.
OF HEALTH AND MENTAL HYGIENE.

APPROVED FOR PRIVATE WATER AND
PRIVATE SEWAGE SYSTEMS.

HOWARD COUNTY HEALTH DEPARTMENT

Joyce M. Broglie 2-9-77
PUBLIC HEALTH OFFICER DATE

TAX MAP 9 PARCELS 255 thru 287

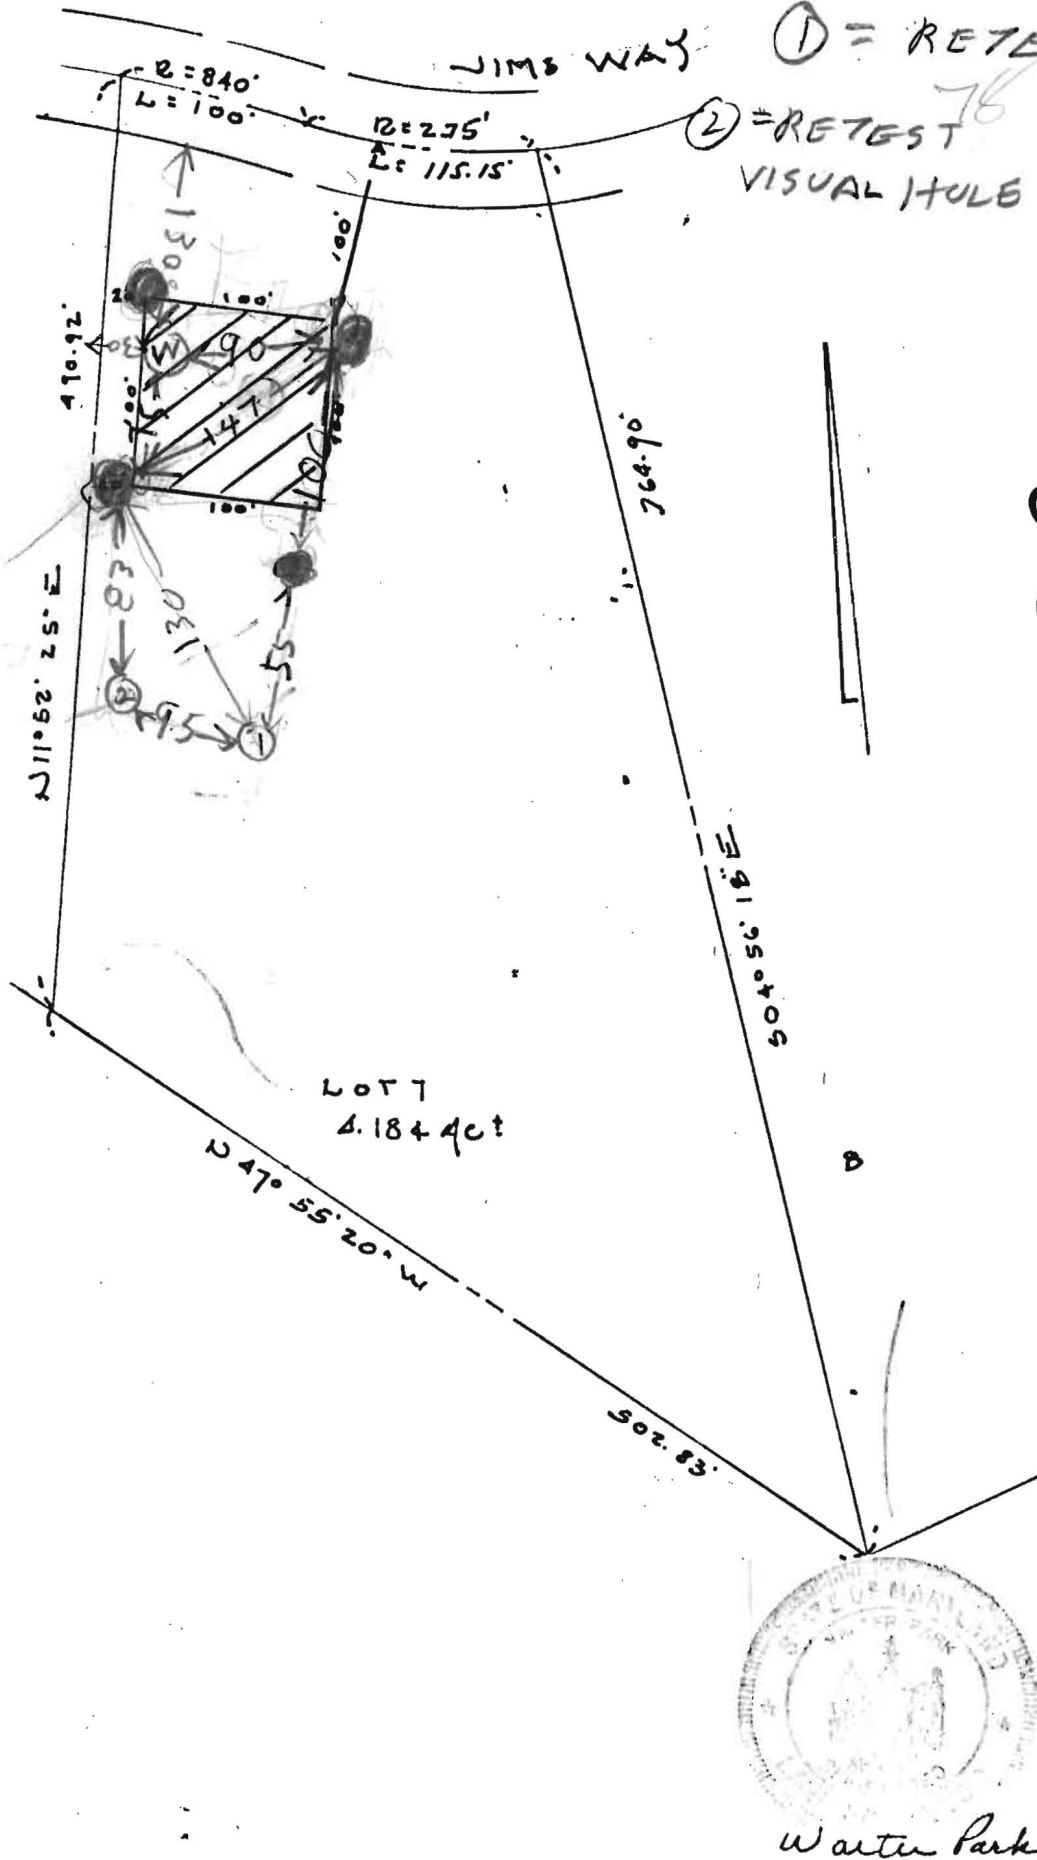

FIELD LOCATED PERC HOLES

LOT 7 DICKEY FARMS
DEED 711 FOLIO 558
3rd ELECTION DISTRICT
HOWARD COUNTY, MD
SCALE 1"=100' DEC. 6, 1977

HUDKINS ASSOCIATES
231 JOSEPH SQUARE
COLUMBIA, MD 21044