

APPLICATION

A 28018

P

SEWAGE DISPOSAL TESTING

STATE OF MARYLAND - DEPARTMENT OF HEALTH AND MENTAL HYGIENE

HOWARD COUNTY HEALTH DEPARTMENT
ENVIRONMENTAL HEALTH SERVICESP. O. BOX 476, ELLICOTT CITY, MARYLAND 21043
TELEPHONE: 465-5000, EXT. 3561000 gallons
3rd
1250 gallons
DATE 5/8/78Septic tank { 1-3 Bedrooms
4 Bedrooms
Dig well to have 120 sq. ft.

effective absorbent sidewall area per bedroom
below inlet. Inlet to be 3 1/2' below original grade
and maximum depth 12'. Location per plat. 70' from
front property line and 100' from right side line when
facing lot from front of property.

TO: THE COUNTY HEALTH OFFICER
ELLICOTT CITY, MARYLAND

center of JIM'S WAY

(1) 5' earth buffer
between trench
and dig wellI, HEREBY, APPLY FOR THE NECESSARY TEST IN ORDER TO CONSTRUCT (OR RECONSTRUCT) A SEWAGE
DISPOSAL SYSTEM.

PROPERTY OWNER John R. Browning, III & Eileen Browning

ADDRESS 2067 Beechwood Ave., Balto., Md. 21207

PHONE 448-0389

Work (John) - 665-6600
Work (Eileen) - 594-0558

PROPERTY LOCATION

SUBDIVISION (Dickey Farms)

LOT NO. 28

ROAD AND DESCRIPTION off Day Road, Sykesville, Md.

SIZE OF LOT 3.05 acres m/l.

TYPE BLDG. 3 or 4 bedrooms

NUMBER OF BEDROOMS

IF NOT SINGLE RESIDENCE DESCRIBE

THE SYSTEM INSTALLED UNDER THIS APPLICATION IS ACCEPTABLE ONLY UNTIL PUBLIC
FACILITIES BECOME AVAILABLE.

SIGNATURE OF APPLICANT /s/ John R. Browning, III

APPROVED BY C.B. Treaster FOR Dig well & trench DATE 6/19/78

(KIND OF SYSTEM)

REJECTED BY FOR DATE

(KIND OF SYSTEM)

HOLD PENDING FURTHER TESTS

DATE

REASONS FOR REJECTION OR HOLDING


certified holes in new area + house plan
spec written

BLDG. PERMIT SIGNED

AND RETURNED 10/16/78

serial # 37444

THIS IS NOT A PERMIT

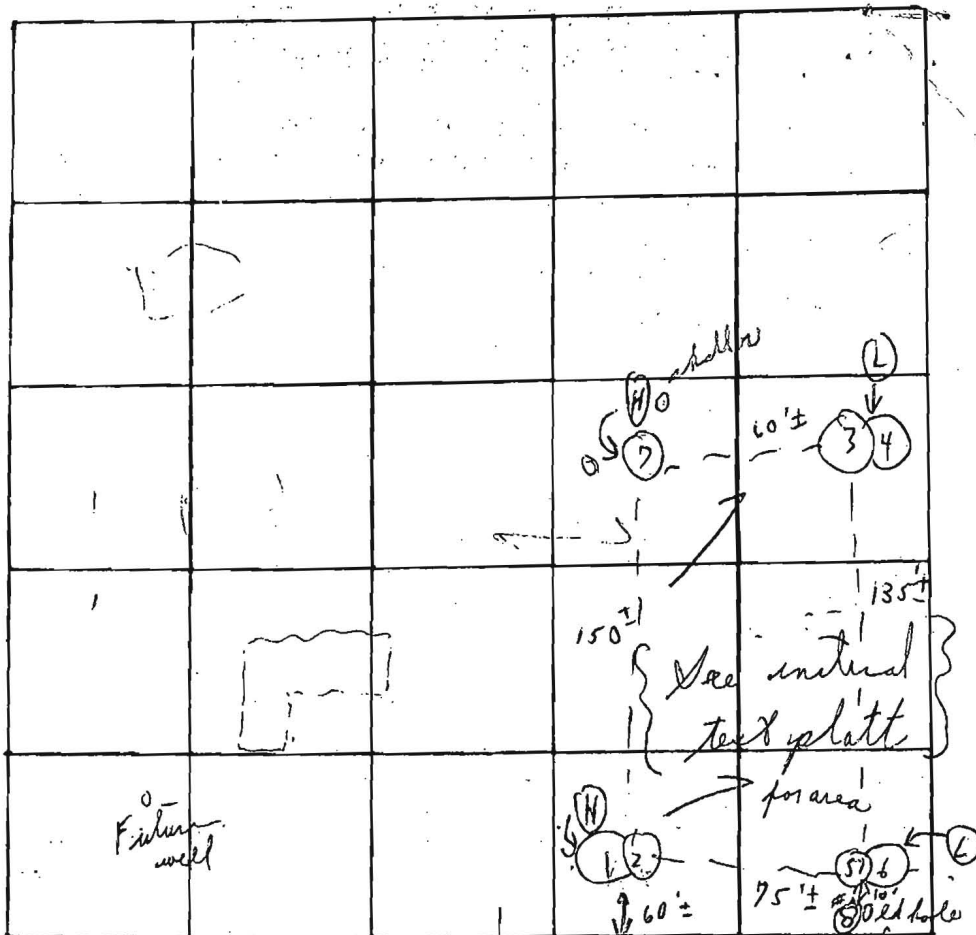

Soil Profile

Below clay

hoon

DATE	TEST NO.	DEPTH	PRE-WET		TEST - 1" DROP		TIME
			START	STOP	START	STOP	
6/1/72	1	3 1/2'	10:24	10:29	10:29	10:31	4 m
	(H) 2	13'	10:25	10:37	10:37	11:03	26 m
	3	4'	10:34	10:40	10:40	10:02	22 m
	(L) 4	13'	10:34	10:36	10:36	10:42	6 m
	5	4 1/2'	(Similar to 1 & 2)				4 58
	(L) 6	12'					
	(H) 7	12'	Vertical		old # (576)		

(closed 3 1/2' Handpan ← clay in)

15'

REMARKS

Open field

TYPE OF SOIL


TESTED BY

C. B. S.

ALSO PRESENT:

B. Arnold & Father
(Mr. & Mrs. Brown - 7)

Percolation Holes Shown Hereon Have
Been Field Located.

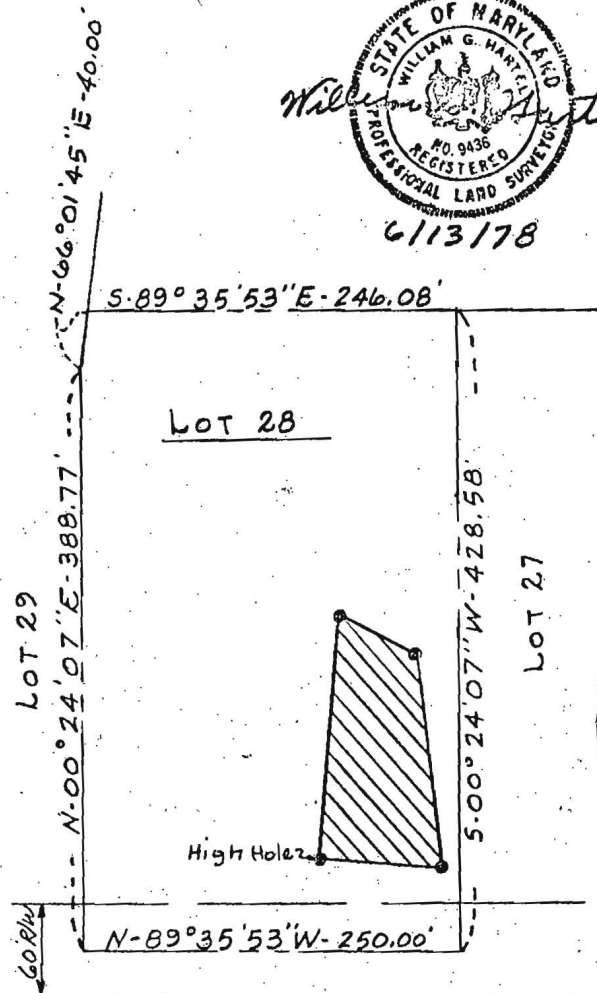

JIM'S WAY

The Lot shown hereon complies with the minimum
ownership width and Lot Areas as required by
The Maryland State Department of Health.

APPROVED: For Private Water and Sewer Systems
Howard County Health Department

Joseph Boyles
County Health Officer

6-16-78
Date

TITLE PERCOLATION TEST PLAT			
PROJECT LOT 28 - DICKEY FARMS			
LOCATION 3 rd ELECTION DISTRICT, HOWARD CO. MD.			
DATE: June 13, 1978	DESIGN BY: _____	DRAWN BY: WGH	CHECKED BY: _____
SCALE: 1" = 100'	JOB NO.: 78126	DRAWING NO.: 1 of 1	
boender associates		engineers surveyors planners	
BALTIMORE 301-465-7777 • SALISBURY 301-749-1286			

K&E BALTIMORE 10 815 ALBANY 8 77 MCG 336