

APPLICATION

A 28018

P

SEWAGE DISPOSAL TESTING

STATE OF MARYLAND - DEPARTMENT OF HEALTH AND MENTAL HYGIENE

HOWARD COUNTY HEALTH DEPARTMENT
ENVIRONMENTAL HEALTH SERVICESP. O. BOX 476, ELLICOTT CITY, MARYLAND 21043
TELEPHONE: 465-5000, EXT. 356Septic tank { 1-3 bedrooms 1000 gallons
4 bedrooms 1250 gallons
DATE 5/8/78

dry well to have 170 sq. ft.

effective absorbent sidewall area per bedroom
below inlet. Inlet to be 3 1/2' below original grade
and maximum depth 12'. Location per plat. 75' from
front property line and 100' from right side line when
facing lot from front of property. If dry well & trench used need:
(1) 5' earth buffer between trench and dry well
(2) 2 inspections of trench - before and after stone in.

TO: THE COUNTY HEALTH OFFICER
ELLICOTT CITY, MARYLAND

center of JIM'S WAY

I, HEREBY, APPLY FOR THE NECESSARY TEST IN ORDER TO CONSTRUCT (OR RECONSTRUCT) A SEWAGE DISPOSAL SYSTEM.

PROPERTY OWNER John R. Browning, III & Eileen Browning

ADDRESS 2067 Beechwood Ave., Balto., Md. 21207

PHONE 448-0389
Work (John) - 665-6600
Work (Eileen) - 594-0558

PROPERTY LOCATION:

SUBDIVISION (Dickey Farms)

LOT NO. 28 (3) Trenches to run to rear of lot

ROAD AND DESCRIPTION off Day Road, Sykesville, Md.

SIZE OF LOT 3.05 acres m/l.

TYPE BLDG. 3/4 bedrooms
NUMBER OF BEDROOMS

IF NOT SINGLE RESIDENCE DESCRIBE

THE SYSTEM INSTALLED UNDER THIS APPLICATION IS ACCEPTABLE ONLY UNTIL PUBLIC FACILITIES BECOME AVAILABLE.

SIGNATURE OF APPLICANT /s/ John R. Browning, III


APPROVED BY C.B. Trecker FOR dry well & trench DATE 6/19/78
(KIND OF SYSTEM)REJECTED BY FOR DATE
(KIND OF SYSTEM)

HOLD PENDING FURTHER TESTS DATE

6/1/78 REASONS FOR REJECTION OR HOLDING certified holes in new area, + house plan spec written C.B.T.

BLDG. PERMIT SIGNED
AND RETURNED 10/16/78
serial # 37444

THIS IS NOT A PERMIT

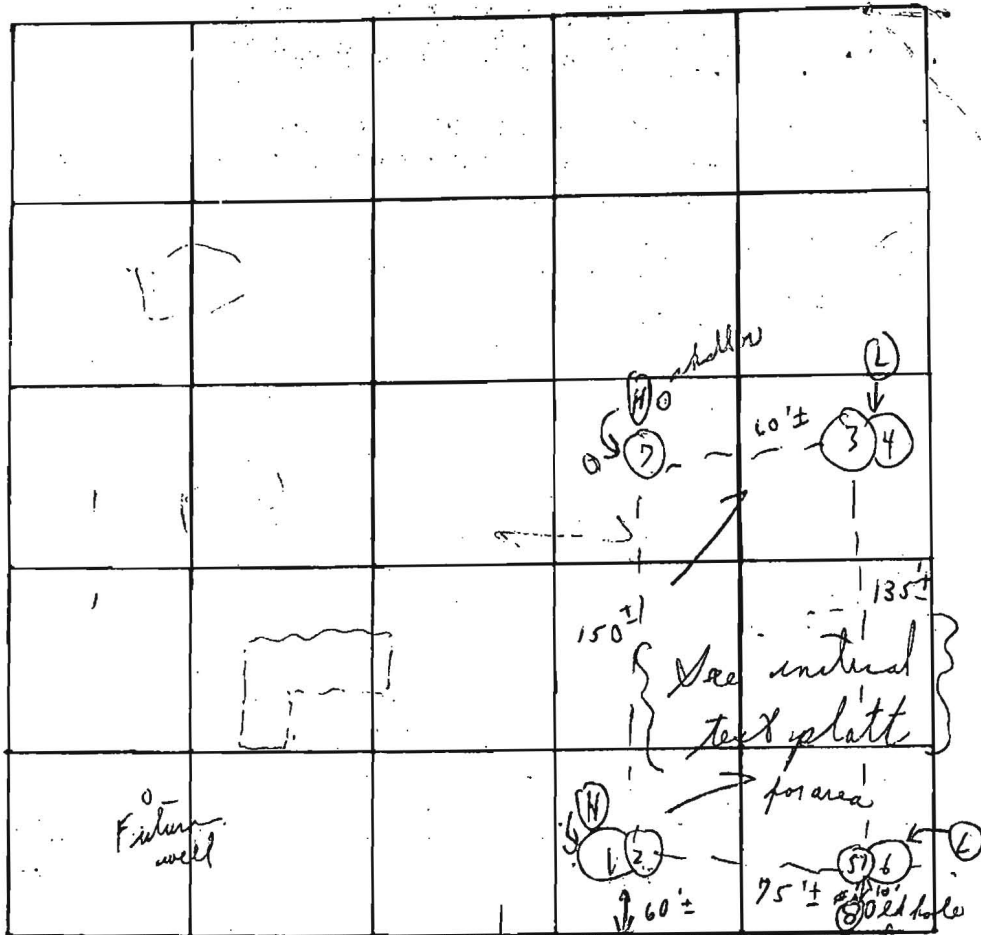

Soil Profile

Below clay

from

DATE	TEST NO.	DEPTH	PRE-WET		TEST - 1" DROP		TIME
			START	STOP	START	STOP	
6/1/22	1	3 1/2'	10:24	10:27	10:27	10:31	4 m
	(H) 2	13'	10:25	10:37	10:37	11:03	26 m
	3	4'	10:34	10:40	10:40	11:02	22 m
	(L) 4	13'	10:34	10:36	10:36	10:42	6 m
	5	4 1/2'					4:58
	(L) 6	12'	(Similar to 1 & 2)				
	(H) 7	12'	Vertical		old # (576)		

(dashed 3 1/2')
Hardpan
← clayish

15 m

REMARKS

Open field

TYPE OF SOIL


TESTED BY

C. B. S.

ALSO PRESENT:

B. Arnold & Father
Mr. & Mrs. Brown

Percolation Holes Shown Hereon Have
Been Field Located.

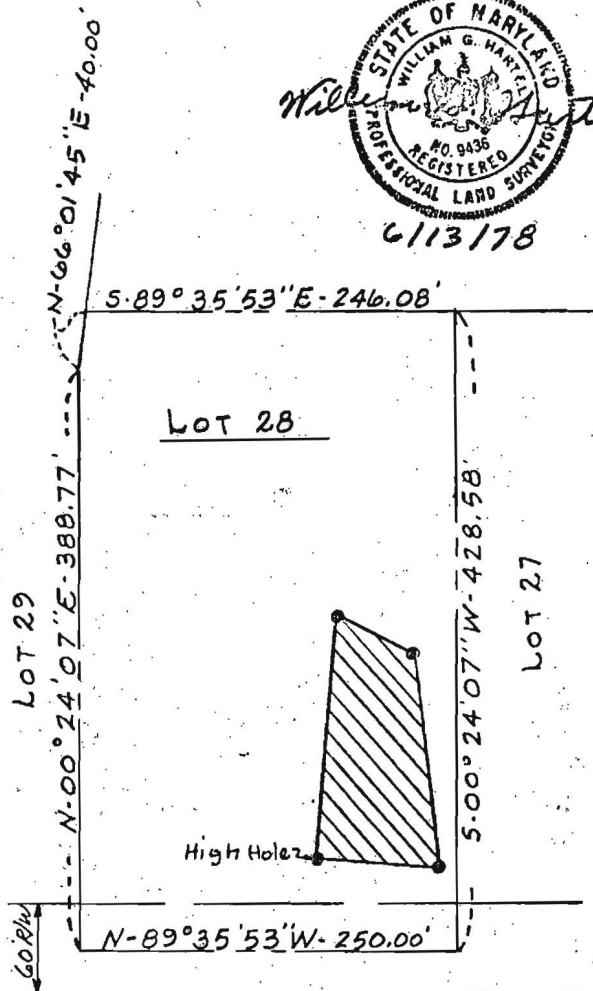

JIM'S WAY

The Lot shown hereon complies with the minimum
ownership width and Lot Areas as required by
The Maryland State Department of Health.

APPROVED: For Private Water and Sewer Systems
Howard County Health Department

Joseph F. [Signature]
County Health Officer

6-16-78
Date

TITLE PERCOLATION TEST PLAT			
PROJECT LOT 28 - DICKEY FARMS			
LOCATION 3 rd ELECTION DISTRICT, HOWARD CO. MD.			
DATE: June 13, 1978	DESIGN BY: _____	DRAWN BY: WGH	CHECKED BY: _____
SCALE: 1" = 100'	JOB NO.: 78126	DRAWING NO.: 1 of 1	
boender associates		engineers surveyors planners	
BALTIMORE 301-485-7777 • SALISBURY 301-749-1286			