

LAYOUT 2/20/07 INSP 4 \_\_\_\_\_  
INSP 2 \_\_\_\_\_ INSP 5 \_\_\_\_\_  
INSP 3 \_\_\_\_\_ INSP 6 \_\_\_\_\_

ISSUE DATE: 01/30/07

P 526208

APPROVAL DATE: 2/21/07

A 524132

# PERMIT

TAX ID # 04-339711

## ON-SITE SEWAGE DISPOSAL SYSTEM HOWARD COUNTY HEALTH DEPARTMENT BUREAU OF ENVIRONMENTAL HEALTH

Fogles Septic Clean, Inc IS PERMITTED TO INSTALL ☒ ALTER ☐

ADDRESS: 580 Obrecht Road, Sykesville PHONE NUMBER: 410-795-5670

SUBDIVISION: \_\_\_\_\_ LOT NUMBER: \_\_\_\_\_

ADDRESS: 16272 Compromise Court PROPERTY OWNER: William J Boettner

SEPTIC TANK CAPACITY (GALLONS): 1500 OUTLET BAFFLE FILTER REQUIRED ☐

PUMP CHAMBER CAPACITY (GALLONS): N/A COMPARTMENTED TANK REQUIRED ☒

NUMBER OF BATHROOMS: 2

SQUARE FEET PER BEDROOM: 187.5

LINEAR FEET OF TRENCH REQUIRED: 125.0

TRENCHES:	Trench to be 3.0 feet wide. Inlet <sup>4.0</sup> 5.0 feet below original grade. Bottom maximum depth 7.0 feet below original grade. Effective area begins at 7.0 feet below original grade. <sup>2.0</sup> 2.0 feet of stone below distribution pipe.
LOCATION:	Septic tank > 10' from NE barn wall
NOTES:	Two 62.5 feet distribution lines to be installed in highest area of septic easement (near to 'old barn')

PLANS APPROVED: Robert Bricker DATE: 01/30/2007

NOTE: PERMIT VOID AFTER 2 YEARS

NOTE: CONTRACTOR RESPONSIBLE FOR SCHEDULING A PRE-CONSTRUCTION INSPECTION FOR ALL INSTALLATIONS


NOTE: WATERTIGHT SEPTIC TANKS REQUIRED

NOTE: ALL PARTS OF SEPTIC SYSTEM SHALL BE 100 FEET FROM ANY WATER WELL

NOTE: MANHOLE RISERS REQUIRED ON ALL SEPTIC TANKS AND PUMP CHAMBERS UNLESS SPECIFICALLY AUTHORIZED

**NEITHER THE HOWARD COUNTY COUNCIL NOR THE HEALTH DEPARTMENT IS  
RESPONSIBLE FOR THE SUCCESSFUL OPERATION OF ANY SYSTEM  
PERMITTEE RESPONSIBLE FOR OBTAINING FINAL APPROVAL ON THIS PERMIT  
CALL 410-313-1771 FOR INSPECTION OF SEPTIC SYSTEM**

H0-95-0504

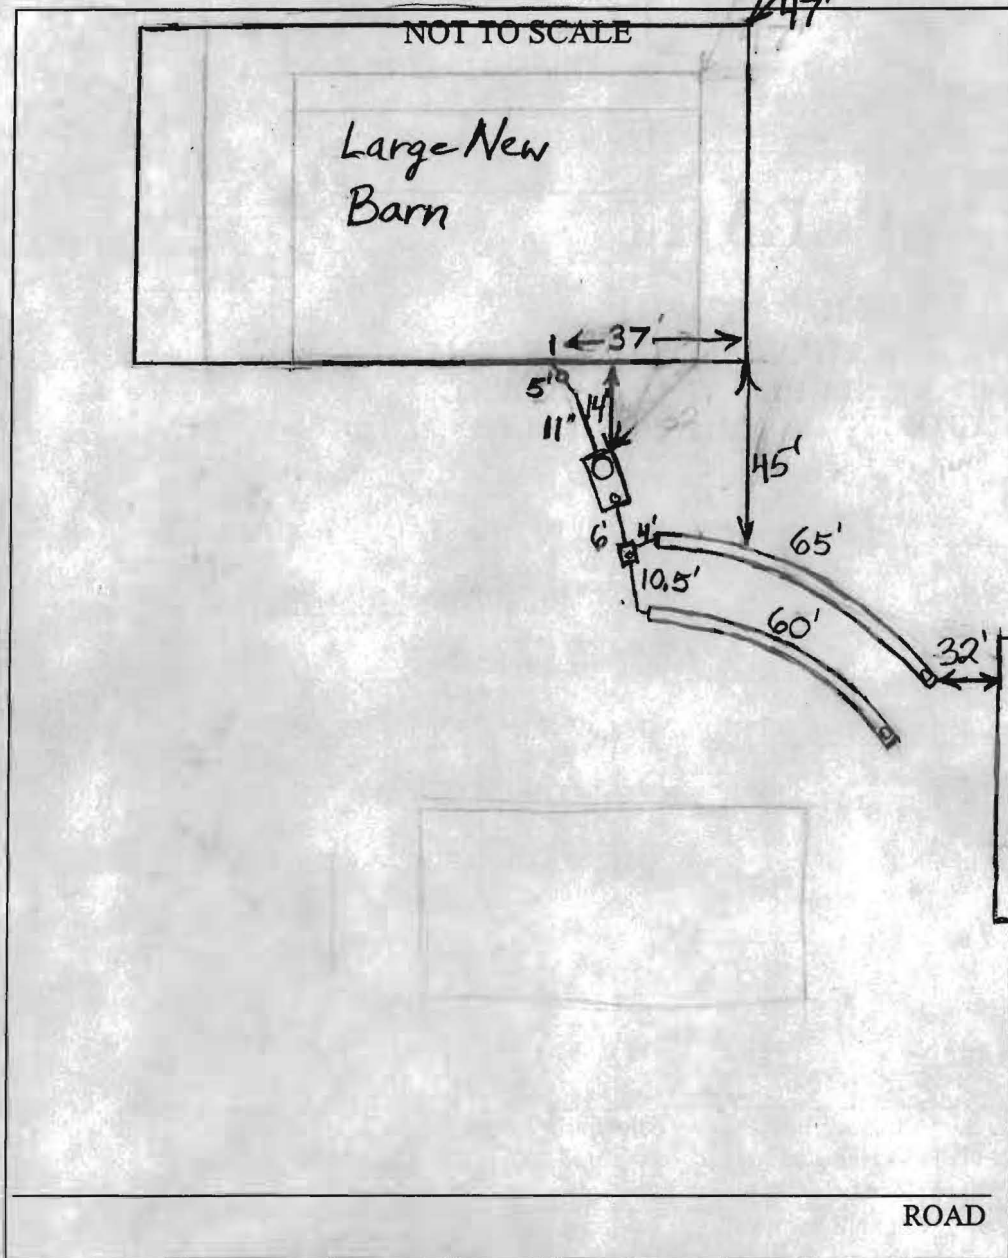

TRENCH/DRAINFIELD DATA		
WIDTH	INLET	BOTTOM
3'	5'	7'
NUMBER OF TRENCHES		
2		
TOTAL LENGTH		
125'		
ABSORPTION AREA		
375'		
DISTRIBUTION BOX LEVEL		
Levelers		
DISTRIBUTION BOX BAFFLE		
Yes		
DISTRIBUTION BOX PORT		
Yes		

SEPTIC TANK DATA	
SEPTIC TANK 1 LEVEL	Yes
CAPACITY	1500 GAL
SEAM LOC	Top
TANK LID DEPTH	0.5'-3'
BAFFLES	Yes
BAFFLE FILTER	None
MANHOLE LOC	Front
6" PORT LOC	Rear
WATERTIGHT TEST	No
SEPTIC TANK 2 LEVEL	N/A
CAPACITY	GAL
SEAM LOC	
TANK LID DEPTH	
BAFFLES	
BAFFLE FILTER	
MANHOLE LOC	
6" PORT LOC	
WATERTIGHT TEST	

2-Comp.  
Babylon  
Barn

PRE-CONSTRUCTION 2/20/07 Tank set and connection to barn made.  
 INSTALLATION 2/21/07 System finished. O.K. to backfill. (BB)

FINAL INSPECTOR B. Baber DATE OF APPROVAL 2/21/07



