

8/6/75 to make imp. after 1:30 PM
8/18/75
PERMIT

SEWAGE DISPOSAL SYSTEM

MARYLAND STATE DEPARTMENT OF HEALTH

HOWARD COUNTY

ELLICOTT CITY

DISTRICT 5

DATE 8/1/75

INDEXED

8/18/75
8/18/75
8/18/75
file ok WNB
Chris Spengler _____ IS PERMITTED TO INSTALL ☒ ALTER _____

ADDRESS 8928 Apt. F - Town & Country Blvd., Ellicott PHONE 465-9217
City, Md.

A SEWAGE DISPOSAL SYSTEM LOCATED AT _____
11524 Crows Nest Rd.

SUBDIVISION Clarksville Meadows ROAD Intersection of Rt. 32 LOT C
 & Whitegate Lane

PROPERTY OWNER Community Financial Services, Inc.

ADDRESS _____

SPECIFICATIONS - 4 bedrooms

DRAIN FIELD _____ DEPTH _____ FEET, BOTTOM AREA _____ SQ. FT.

SEEPAGE PITS _____ ABSORBENT SIDE-WALL AREA _____ SQ. FT.

SEPTIC TANK CAPACITY 1,250 GALLONS

FOR GARBAGE GRINDER, INCREASE DISPOSAL AREA 22% & TANK CAPACITY 50%.

OTHER Dry well (and trench) to have 144 sq. ft. effective sidewall absorption area per
bedroom to begin below the first 4 ft. of non-porous soil. Maximum depth permitted for
dry well or trench is 13 ft. below original grade. Place the dry well 225 ft. from the
lot line that is 400 ft. long and 165 ft. from the lot line that is 362.58 ft. long.

If trench is used in addition to dry well start trench after a 6 ft. earth buffer and place
it parallel to the ground surface contour the required distance.

PLANS APPROVED BY Frank Skinner DATE 6/2/75


NOTE: IF TRENCH IS USED CALL FOR INSPECTION WHEN GROUND IS EXCAVATED BEFORE ANY GRAVEL IS
FILL SEPTIC TANK AND DISTRIBUTION BOX WITH WATER BEFORE CALLING FOR AN INSPECTION. COVER NO WORK
UNTIL INSPECTED AND APPROVED. INSTALLED.

NOTE: ALL PIPE FROM HOUSE TO DISPOSAL AREA MUST BE CAST IRON.

NEITHER THE HOWARD COUNTY COMMISSIONERS NOR THE HEALTH DEPARTMENT IS RESPONSIBLE FOR THE
SUCCESSFUL OPERATION OF ANY SYSTEM.
PERMIT VOID AFTER THREE YEARS.

NOTE: INSTALL STAND PIPE ON SEPTIC TANK AND DRY WELL. STAND PIPES MUST BE 6" IN DIA.,
CAST IRON, CONCRETE OR TERRA COTTA ACCEPTED.

A 21333

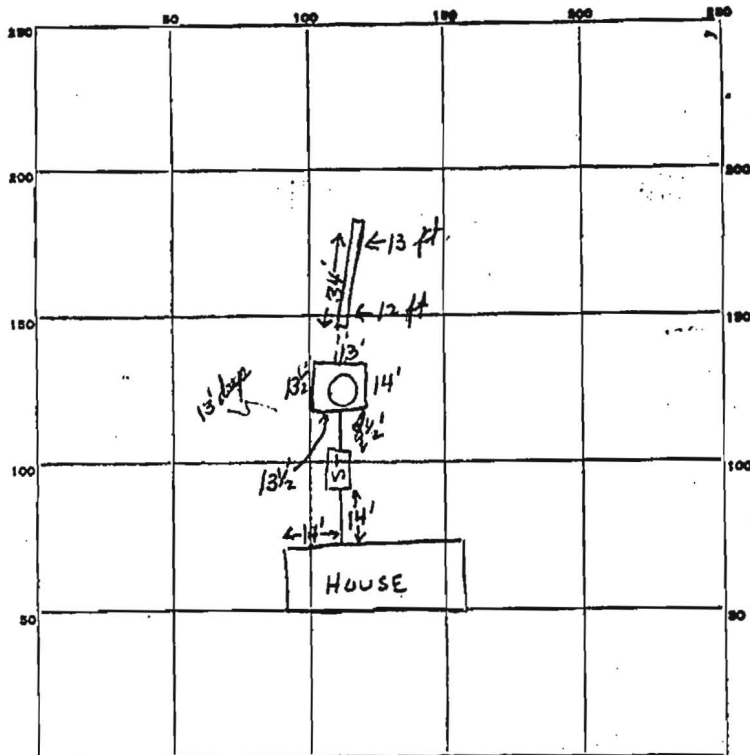

INDICATE NORTH. - NAME ADJOINING ROADWAY AS BASE LINE.

PERMIT CARD. ☒

SEPTIC TANK, LEVEL

1250 gal. 1500 gal.

CLEANOUTS

ST DW
✓ ✓

DISTRIBUTION BOX, LEVEL

TILE FIELD, DEPTH

FT. TRENCH WIDTH 2 FT.

GRAVEL DEPTH

7 1/2 FT. TOTAL LENGTH 34 FT.

NUMBER OF TRENCHES 1

SIDEWALL TOTAL BOTTOM AREA 255

SEEPAGE PITS, INSIDE-DIAMETER

54 FT. DEPTH BELOW INLET 9 FT.

ABSORBENT AREA

486 SQ. FT.

REMARKS

8/11/75 AM No cleanouts, pipes not cemented
8/11/75 PM All OK. Total sq ft = 441
5 BR. HOUSE

DATE SYSTEM APPROVED

8/11/75

INSPECTOR

William H. Zapp

144
5
720
144
4
576
34
7 1/2
238
17
255
2.7
2.7
54
9
486
255
741

S88°39'00"E

5000'

CHANGING PENCE MEASURES ALONG THIS LINE

4000'

5.562 V. ACRES
(Parcel 'C')

125/01 ✓

WELL
VICINITY

PROP. FAM. ROOM TO
REPL. EX. DECK
(MR.)

OK
FOR
BF

PROP.
DECK

ST.

GRAVEL

216'±

N01°14'10"E

N88°39'00"W

362.53'

approx
Trench location
from 8/11/75
septic
Permit

1:100

1:60

This is to certify that I have
located the improvements on the lot
shown hereon, and that said improve-
ments exist, and that said improve-
ments lie entirely within the bound-
aries.



NOT INTENDED TO BE USED TO ESTABLISH
PROPERTY LINES.

20'± rear Eas.
N88°39'00"W 150'
20'± rear Eas.

JST. ENGINEERING Co
3812 MARY AVEN
BALTIMORE, MARYLAND