c1 36741	SEQUENCE NO. (MDE USE ONLY)			STATE OF MARYLAND WELL COMPLETION REPORT	THIS REPORT MUST BE SUBMITTED WITHIN 45 DAYS AFTER WELL IS COMPLETED.
1 2 3 6 (THIS NUMBER IS TO BE PUNCHED IN COLS. 3-6 ON ALL CARDS)				FILL IN THIS FORM COMPLETELY PLEASE TYPE	COUNTY NUMBER
ST/CO USE ONLY DATE Received MM DD YY/6 8 13	DAT		COMPL	ETED Depth of Well 22 20 26 (TO NEAREST FOOT)	PERMIT NO. FROM "PERMIT TO DRILL WELL" /21/16 Sc 26 29 30 31 32 33 34 35 36 37
OWNER MC INTOSH JAMIC					
WELL SITE ADDRESS 600 Beet 2 Rd TOWN MT alky					
WELL LOG				GROUTING RECORD yes no	C 3
Not required for driven wells STATE THE KIND OF FORMATIONS PENETRATED, THEIR COLOR, DEPTH, THICKNESS AND IF WATER BEARING				WELL HAS BEEN GROUTED (Circle Appropriate Box) TYPE OF GROUTING MATERIAL (Circle one)	1 2 PUMPING TEST
DESCRIPTION (Use FEET check			check	CEMENT CM BENTONITE CLAY	HOURS PUMPED (nearest hour)
additional sheets if needed)	FROM	TO	bearing	NO. OF BAGS 46 1 NO. OF POUNDS 45 50	PUMPING RATE (gal. per min.) 1 • 2
Brown Suite	34	34		GALLONS OF WATER DEPTH OF GROUT SEAL (to nearest foot)	METHOD USED TO MEASURE PUMPING RATE Buchet
Gray Slota Brown Slote	43	43	ļх.	from	WATER LEVEL (distance from land surface)
Gray slate	44	47		(enter 0 if from surface) casing CASING RECORD	BEFORE PUMPING 50 ft.
Brownistate	47	49		types insert appropriate	
Gray - Brinn S	11	82		code PL OT below PLASTIC OTHER	TYPE OF PUMP USED (for test)
Cruy-Drown S	11- 1-1	02		MAIN Nominal diameter Total depth	P piston T turbine
Purple Slata	82	89		CASING top (main) casing of main casing TYPE (nearest inch)! (nearest foot)	C centrifugal R rotary O ther (describe below)
Gray Slote	89	143		<u>60 61 63 64 66 70</u>	J jet S submersible
purple Gray state	143	202	-	E OTHER CASING (if used) A diameter depth (feet) H inch from to	27 27
and one					PUMP INSTALLED DRILLER INSTALLED PUMP YES NO (CIRCLE) (YES or NO)
				Б	IF DRILLER INSTALLS PUMP, THIS SECTION MUST BE COMPLETED FOR ALL WELLS.
				screen type SCREEN RECORD	TYPE OF PUMP INSTALLED PLACE (A,C,J,P,R,S,T,O) 29
And shares				insert STEEL BRASS OPEN	IN BOX 29. CAPACITY:
				below PL OT	(to nearest gallon) 31 35
					PUMP HORSE POWER
NUMBER OF UNSUCCESSFUL WELLS:				DEPTH (nearest ft.)	PUMP COLUMN LENGTH (nearest ft.)
WELL HYDROFRACTURE	D	yes Y	No.	$E \frac{1}{8} \frac{1}{9} \frac{1}{11} \frac{1}{15} \frac{1}{17} \frac{21}{21}$	CASHIG HEIGHT (circle appropriate box and enter casing height)
CIRCLE APPROPRIATE LETTER A WELL WAS ABANDONED AND SEALED				H ² 23 24 26 30 32 36	LAND SURFACE
E ELECTRIC LOG OBTAINED				C <u>3</u> R <u>38 39 41 45 47 51</u>	
P TEST WELL CONVERTED TO PRODUCTION					LATITUDE 3 9. 3.55.781
I HEREBY CERTIFY THAT THIS WELL HAS BEEN CONSTRUCTED IN ACCORDANCE WITH COMAR 26.04.04 "WELL CONSTRUCTION" AND IN CONFORMANCE WITH ALL CONDITIONS STATED IN THE ABOVE CAPTIONED PERMIT, AND THAT THE INFORMATION PRESENTED HEREIN IS ACCURATE AND COMPLETE TO THE BEST OF MY KNOWLEDGE.				DIAMETER OF SCREEN (NEAREST INCH)	LONGITUDE 7 1. 105.850 (DEFAULT COORD. WGS 84)
DRILLERS LIC. NO. 1 MWD.040_1				GRAVEL PACK	Pursuant to \$10-624 of the State Govt. Article of the Maryand Code personal info. requested on this form is used in processing this form pursuant
DRILLERS SIGNATURE 7. Autertag				IF WELL DAILLED WAS FLOWING WELL INSERT F IN BOX 68 68	to COMAR 26.04.04. Failure to provide the info. may result in this form not being processed. You
(MUST MATCH SIGNATURE ON APPLICATION)				MDE USE ONLY (NOT TO BE FILLED IN BY DRILLER)	have the right to inspect, amend, or correct this form. The Maryland Department of the
LIC. NO. I LIC DIDZ I				T (E.R.O.S.) WQ	Environment is subject to the Maryland Public Information Act. This form may be made available on the Internet via MDE's website and is
SITE SUPERVISOR (sign. of driller or journeyman				70 72 74 75 76	subject to inspection or copying, in whole or in part, by the pulic and other governmental
responsible for sitework if	different from	n permitte	88)	TELESCOPE LOG CASING INDICATOR OTHER DATA	agencies, if not protected by federal or state law.


-

COUNTY

EMERGENCY/TEMP NO. IF ANY SEQUENCE NO. STATE PERMIT NUMBER STATE OF MARYLAND (MDE USE ONLY) APPLICATION FOR PERMIT TO DRILL WELL 10-15-0199 please type 70 70 fill in this form completely Date Received (APA). LOCATION OF WELL 13183 B 3 1/11/16 OWNER INFORMATION Howard DD YY 13 MM 8 COUNTY 21 GENTLE GIANTS HORSE RESCUE Gentle Giants Horse Res 15 Last Name Owner First Name 34 23 SUBDIVISION 12 **17250 OLD FREDERIKC ROAD** 36 Street or RFD LOT 55 46 MT. AIRY, MD 21771 Mt Airy 57 Town 70 State 72 Zip 76 NEAREST TOWN 71 52 DRILLER INFORMATION WD George F. Easterday 040 M License No. B 4 Driller's Name 76 81 L. Franklin Easterday, Inc. 600 Beetz Road SOURCES OF DRILLING WATER wells 1. Firm Name 11 STREET ADDRESS 30 9265 Brown Church Rd., Mt. Airy, Md. 21771 2. NORTH ON WHICH SIDE OF ROAD (CIRCLE APPROPRIATE BOX) Ν 3. Addres 1-5-Ko SOUTH 12/11/2015 34 1000 37 Signature Date WELL INFORMATION B 2 5 DISTANCE FROM ROAD Ft. APPROX. PUMPING RATE 2 ENTER FT OR MI 38 39 (GAL. PER MIN.) 8 12 500 2 BLK: 20 PARCEL 246 AVERAGE DAILY QUANTITY NEEDED (GAL. PER DAY) TAX MAP: _ 14 20 NOT TO BE FILLED IN BY DRILLER HEALTH DEPARTMENT APPROVAL USE FOR WATER (CIRCLE APPROPRIATE BOX) DOMESTIC POTABLE SUPPLY & RESIDENTIAL D IRRIGATION Howard F FARMING (LIVESTOCK WATERING & AGRICULTURAL COUNTY NO. **IRRIGATION**) COUNTY NAME STATE SIGNATURE INDUSTRIAL, COMMERCIAL, DEWATERING T 22 INSERT S . P PUBLIC WATER SUPPLY WELL DATE ISSUED TEST, OBSERVATION, MONITORING T 12/16 CO SIGNATURE 48 0 **OPEN LOOP GEOTHERMAL** DD YY C CLOSED LOOP GEOTHERMAL PROPOSED LOCATION OF WELL ON LOT SHOW PERMANENT STRUCTURES SUCH AS BUILDINGS, SEPTIC SYSTEM, 300 APPROXIMATE DEPTH OF WELL J FEET 28 ROADS AND/OR LANDMARKS AND INDICATE NOT LESS THAN TWO DISTANCE MEASUREMENTS TO WELL NEAREST APPROXIMATE DIAMETER OF WELL _____6 INCH METHOD OF DRILLING (circle one) BORED (or Augered) JETTED Jetted & DRIVEN 30 AIR-ROTary AIR-PERcussion **ROTARY** (Hydraulic Rotary) 37 CABLE **REVerse-ROTary DRive-POINT** other redevich REPLACEMENT OR DEEPENED WELLS (CIRCLE APPROPRIATE BOX) will be THIS WELL WILL NOT REPLACE AN EXISTING WELL used THIS WELL WILL REPLACE A WELL THAT WILL BE Y I 70 ABANDONED AND SEALED ter THIS WELL WILL REPLACE A WELL THAT WILL BE USED AS A STANDBY-CONTACT LOCAL APPROVING AUTHORITY FOR POLICY ON STANDBY WELLS 39 S STANDBY D THIS WELL WILL DEEPEN AN EXISTING WELL PERMIT NUMBER OF WELL TO BE REPLACED OR DEEPENED (IF AVAILABLE) 41 52 EVEL NO. Not to be filled in by driller (MDE OR COUNTY USE ONLY) APPROP. PERMIT NUMBER PERMIT No. 70 71 72 73 74 75 76 77 78 79 SPECIAL CONDITIONS æ NOTE APPROVING AUTHORITIES SHOULD USE SEPARATE SHEET IF NEEDED

MDE/WMA/PER.071

12/7/15 600 Beetz Road

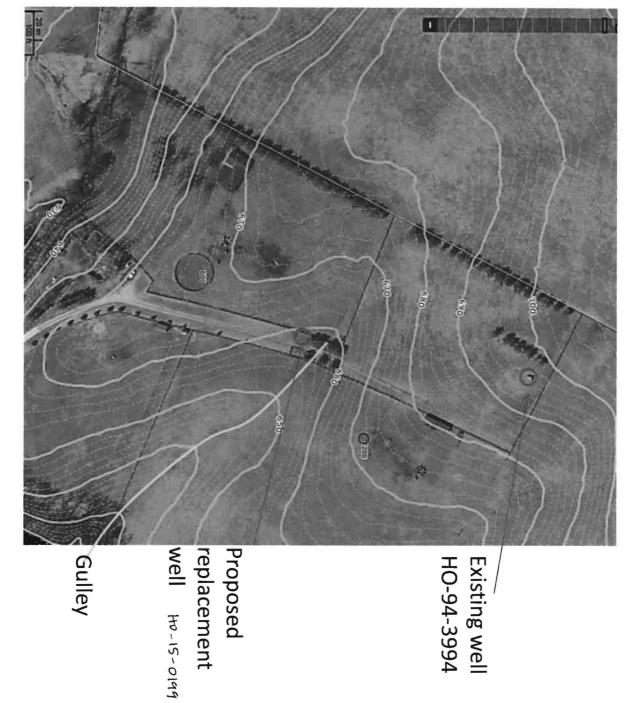

To Beetz Road