

C1 33099

SEQUENCE NO.
(MDE USE ONLY)STATE OF MARYLAND
WELL COMPLETION REPORT
FILL IN THIS FORM COMPLETELY
PLEASE TYPETHIS REPORT MUST BE SUBMITTED WITHIN
45 DAYS AFTER WELL IS COMPLETED.COUNTY
NUMBER1 2 3 6
(THIS NUMBER IS TO BE PUNCHED
IN COLS. 3-6 ON ALL CARDS)

ST/CO USE ONLY

DATE Received

MM DD YY
8 20 13

DATE WELL COMPLETED

MM DD YY
04 26 15

Depth of Well

22 250 26
(TO NEAREST FOOT)PERMIT NO.
FROM "PERMIT TO DRILL WELL"H0-15-0050
28 29 30 31 32 33 34 35 36 37

OWNER

WELL SITE ADDRESS

SUBDIVISION

SECTION

LOT 3

WELL LOG

Not required for driven wells

STATE THE KIND OF FORMATIONS PENETRATED, THEIR
COLOR, DEPTH, THICKNESS AND IF WATER BEARINGDESCRIPTION (Use
additional sheets if needed)

FEET

FROM

TO

check
if water
bearing

Topsoil 0 1

Silt, Lt. Brown 1 75

Rock Sch. 2 75 250

Lt. Gray

12 bags x $\frac{26 \text{ gal}}{\text{bag}} = 312 \text{ gal} \div 250 = 1.248 \text{ bags/ft.}$

Is well 2 closed 1/4"

Geotexture loops at 250'

1 in each well location.

NUMBER OF UNSUCCESSFUL WELLS: 0

WELL HYDROFRACTURED

yes

Y

no

N

CIRCLE APPROPRIATE LETTER

A A WELL WAS ABANDONED AND SEALED
WHEN THIS WELL WAS COMPLETED

E ELECTRIC LOG OBTAINED

P TEST WELL CONVERTED TO PRODUCTION
WELLI HEREBY CERTIFY THAT THIS WELL HAS BEEN CONSTRUCTED IN
ACCORDANCE WITH COMAR 26.04.04 "WELL CONSTRUCTION" AND
IN CONFORMANCE WITH ALL CONDITIONS STATED IN THE ABOVE
CAPTIONED PERMIT, AND THAT THE INFORMATION PRESENTED
HEREIN IS ACCURATE AND COMPLETE TO THE BEST OF MY
KNOWLEDGE.

DRILLERS LIC. NO. 1 MWD 572

DRILLERS SIGNATURE
(MUST MATCH SIGNATURE ON APPLICATION)

LIC. NO. 1 D

SITE SUPERVISOR (sign. of driller or journeyman
responsible for sitework if different from permittee)

GROUTING RECORD

yes

no

WELL HAS BEEN GROUTED
(Circle Appropriate Box)

Y

N

TYPE OF GROUTING MATERIAL (Circle one)

CEMENT CM

BENTONITE CLAY BC

NO. OF BAGS 12 NO. OF POUNDS 312

GALLONS OF WATER 278

DEPTH OF GROUT SEAL (to nearest foot)

from 0 ft. to 250 ft.
(enter 0 if from surface)

CASING RECORD

casing
types
insert
appropriate
code
belowST
STEELCO
CONCRETEPL
PLASTICOT
OTHERMAIN
CASING
TYPENominal diameter
top (main) casing
(nearest inch)Total depth
of main casing
(nearest foot)

60 61 63 64 66 70

E
A
C
H
C
A
S
I
N
G

OTHER CASING (if used)

diameter
inchdepth (feet)
from to

SCREEN RECORD

screen type
or open holeST
STEELBR
BRASSHO
OPEN
HOLEPL
BRONZEOT
OTHER(insert
appropriate
code
below)

C 2

DEPTH (nearest ft.)

1 2

E 1 8 9 11 15 17 21

A 2 23 24 26 30 32 36

H 3 38 39 41 45 47 51

S 4 49 50 51

C 5 52 53 54 55 56 57 58 59 60 61 62 63 64 65 66 67 68 69 70

R 71 72 73 74 75 76 77 78 79 80 81 82 83 84 85 86 87 88 89 90 91 92 93 94 95 96 97 98 99 100

E 101 102 103 200

SLOT SIZE 1 2 3

DIAMETER OF SCREEN (NEAREST INCH)

56 60

from to

GRAVEL PACK

IF WELL DRILLED

WAS FLOWING WELL

INSERT F IN BOX 68

MDE USE ONLY
(NOT TO BE FILLED IN BY DRILLER)

T

(E.R.O.S.)

W Q

70

72

74 75 76

TELESCOPE
CASINGLOG
INDICATOR

OTHER DATA

C 3

PUMPING TEST

HOURS PUMPED (nearest hour)

N/A

PUMPING RATE (gal. per min.)

N/A

METHOD USED TO
MEASURE PUMPING RATE

WATER LEVEL (distance from land surface)

BEFORE PUMPING

17 20 ft.

WHEN PUMPING

22 25 ft.

TYPE OF PUMP USED (for test)

A air

P piston

T turbine

C centrifugal

R rotary

O other
(describe
below)

J jet

S submersible

PUMP INSTALLED

DRILLER INSTALLED PUMP
(CIRCLE) (YES OR NO)

YES NO

IF DRILLER INSTALLS PUMP, THIS SECTION
MUST BE COMPLETED FOR ALL WELLS.TYPE OF PUMP INSTALLED
PLACE (A,C,J,P,R,S,T,O)
IN BOX 29.CAPACITY:
GALLONS PER MINUTE
(to nearest gallon)

31 35

PUMP HORSE POWER

37 41

PUMP COLUMN LENGTH
(nearest ft.)

43 47

CASING HEIGHT (circle appropriate box
and enter casing height)

+ above

LAND SURFACE


- below

-3 (nearest
foot)LATITUDE 39.273451
LONGITUDE 77.023555
(DEFAULT COORD. WGS 84)

NOTES:


| | | | | |
|--|-------|--------------------------------|---|---|
| B 1 | 36527 | SEQUENCE NO. (MDE USE ONLY) | STATE OF MARYLAND APPLICATION FOR PERMIT TO DRILL WELL 555822 please type | STATE PERMIT NUMBER Ho-15-0050 fill in this form completely |
| <div style="display: flex; justify-content: space-between;"> <div style="width:48%;"> <p>OWNER INFORMATION</p> <p>Date Received (APA) 04-22-13</p> <p>8 MM DD YY 13</p> <p>15 Last Name Goodman/Hopkins Owner Natalie/Korn First Name 34</p> <p>36 3700 Daisy Rd. Street or RFD 55</p> <p>57 Woodbine MD 21797 Town 70 State 72 Zip 76</p> <p>DRILLER INFORMATION</p> <p>Driller's Name Samuel A. Connelly MW D 572 76 License No. 81</p> <p>Firm Name Connelly & Associates, Inc.</p> <p>Address 260 Interstate Ct. Frederick MD 21704</p> <p>Signature Samuel A. Connelly Date 4/21/15</p> </div> <div style="width:48%;"> <p>LOCATION OF WELL</p> <p>8 COUNTY Howard 21</p> <p>23 SUBDIVISION Jennings Chapel 42</p> <p>SECTION 44 46 LOT 3 48 50</p> <p>52 NEAREST TOWN Woodbine 71</p> </div> </div> | | | | |
| <div style="display: flex; justify-content: space-between;"> <div style="width:48%;"> <p>WELL INFORMATION</p> <p>1 2 APPROX. PUMPING RATE (GAL. PER MIN.) 8 12</p> <p>AVERAGE DAILY QUANTITY NEEDED (GAL. PER DAY) 14 20</p> <p>USE FOR WATER (CIRCLE APPROPRIATE BOX)</p> <p><input type="checkbox"/> DOMESTIC POTABLE SUPPLY & RESIDENTIAL IRRIGATION</p> <p><input type="checkbox"/> FARMING (LIVESTOCK WATERING & AGRICULTURAL IRRIGATION)</p> <p><input type="checkbox"/> INDUSTRIAL, COMMERCIAL, DEWATERING</p> <p><input type="checkbox"/> PUBLIC WATER SUPPLY WELL</p> <p><input type="checkbox"/> TEST, OBSERVATION, MONITORING</p> <p><input type="checkbox"/> OPEN LOOP GEOTHERMAL</p> <p><input checked="" type="checkbox"/> CLOSED LOOP GEOTHERMAL</p> <p>22 2 bores</p> </div> <div style="width:48%;"> <p>NOT TO BE FILLED IN BY DRILLER HEALTH DEPARTMENT APPROVAL</p> <p>Howard 13 A 13331</p> <p>COUNTY NAME COUNTY NO.</p> <p>STATE SIGNATURE INSERT S 41</p> <p>DATE ISSUED 4/27/15 CO SIGNATURE S. L. C. EXP. DATE 4/27/16</p> <p>43 MM DD YY 48</p> </div> </div> | | | | |
| <p>APPROXIMATE DEPTH OF WELL 250 FEET</p> <p>24 28</p> <p>APPROXIMATE DIAMETER OF WELL 5 INCH</p> <p>NEAREST INCH</p> <p>METHOD OF DRILLING (circle one)</p> <p>BORED (or Augered) JETTED Jetted & DRIVEN</p> <p>30 AIR-ROTary AIR-PERCussion ROTARY (Hydraulic Rotary)</p> <p>37 CABLE REVERSE-ROTary Drive-POINT</p> <p>other</p> <p>REPLACEMENT OR DEEPEMED WELLS (CIRCLE APPROPRIATE BOX)</p> <p><input checked="" type="checkbox"/> THIS WELL WILL NOT REPLACE AN EXISTING WELL</p> <p><input type="checkbox"/> THIS WELL WILL REPLACE A WELL THAT WILL BE ABANDONED AND SEALED</p> <p>39 <input type="checkbox"/> THIS WELL WILL REPLACE A WELL THAT WILL BE USED AS A STANDBY-CONTACT LOCAL APPROVING AUTHORITY FOR POLICY ON STANDBY WELLS</p> <p><input type="checkbox"/> THIS WELL WILL DEEPEM AN EXISTING WELL</p> <p>PERMIT NUMBER OF WELL TO BE REPLACED OR DEEPEMED (IF AVAILABLE) 41 52</p> <p>Not to be filled in by driller (MDE OR COUNTY USE ONLY)</p> <p>APPROP. PERMIT NUMBER - - - - - G - - - - -</p> <p>PERMIT No. Ho-15-0050</p> <p>70 71 72 73 74 75 76 77 78 79</p> <p>SPECIAL CONDITIONS</p> <p>NOTE APPROVING AUTHORITIES SHOULD USE SEPARATE SHEET IF NEEDED</p> | | | | |
| <p>PROPOSED LOCATION OF WELL ON LOT</p> <p>SHOW PERMANENT STRUCTURES SUCH AS BUILDINGS, SEPTIC SYSTEM, ROADS AND/OR LANDMARKS AND INDICATE NOT LESS THAN TWO DISTANCE MEASUREMENTS TO WELL</p> | | | | |

3700 Daisy Rd.

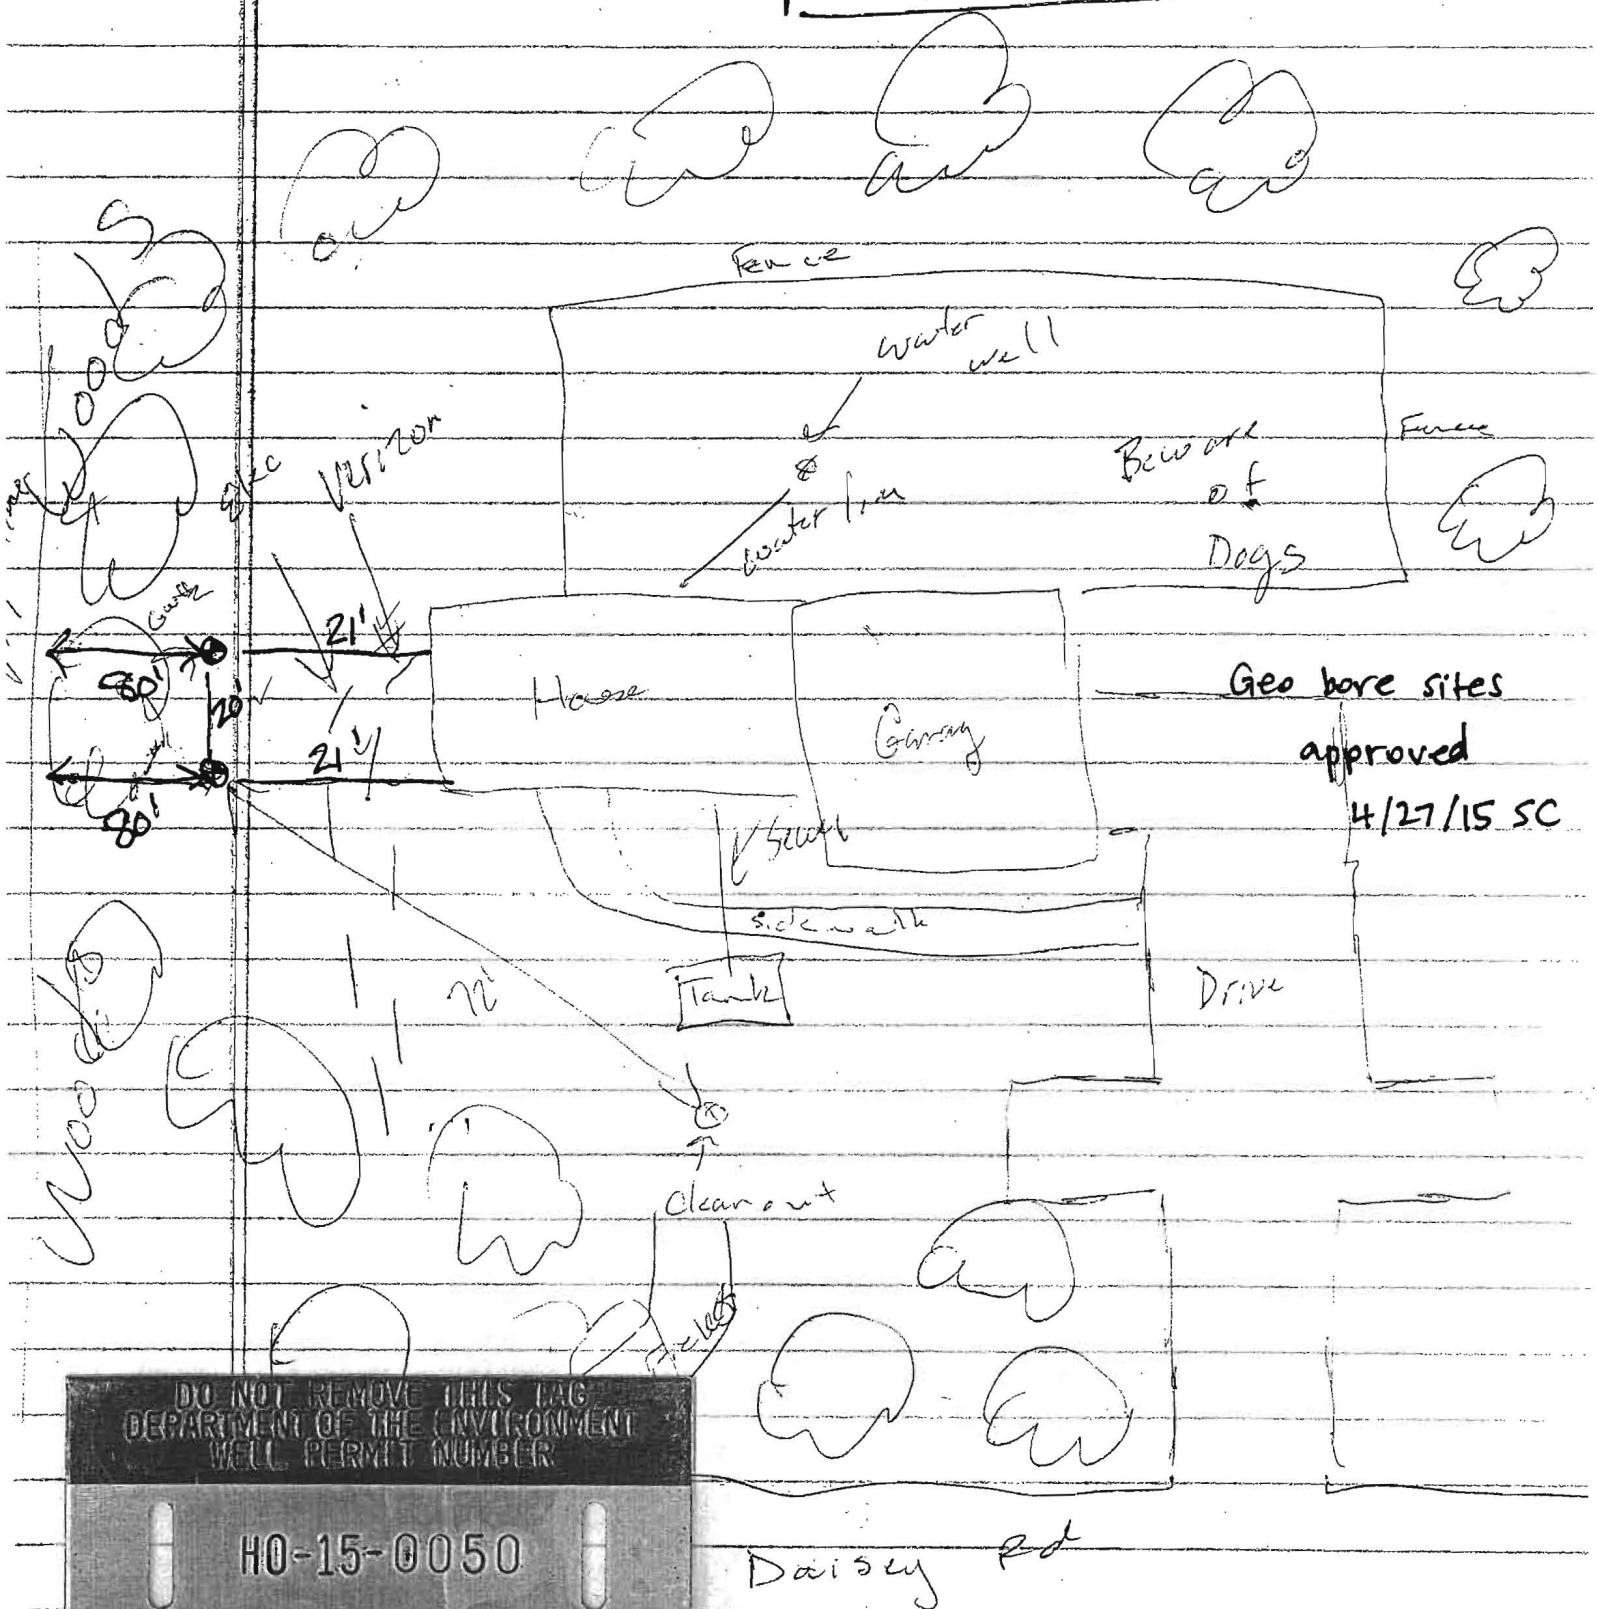

North →

Geothermal Closed Loop - 3700 Daisy Rd.

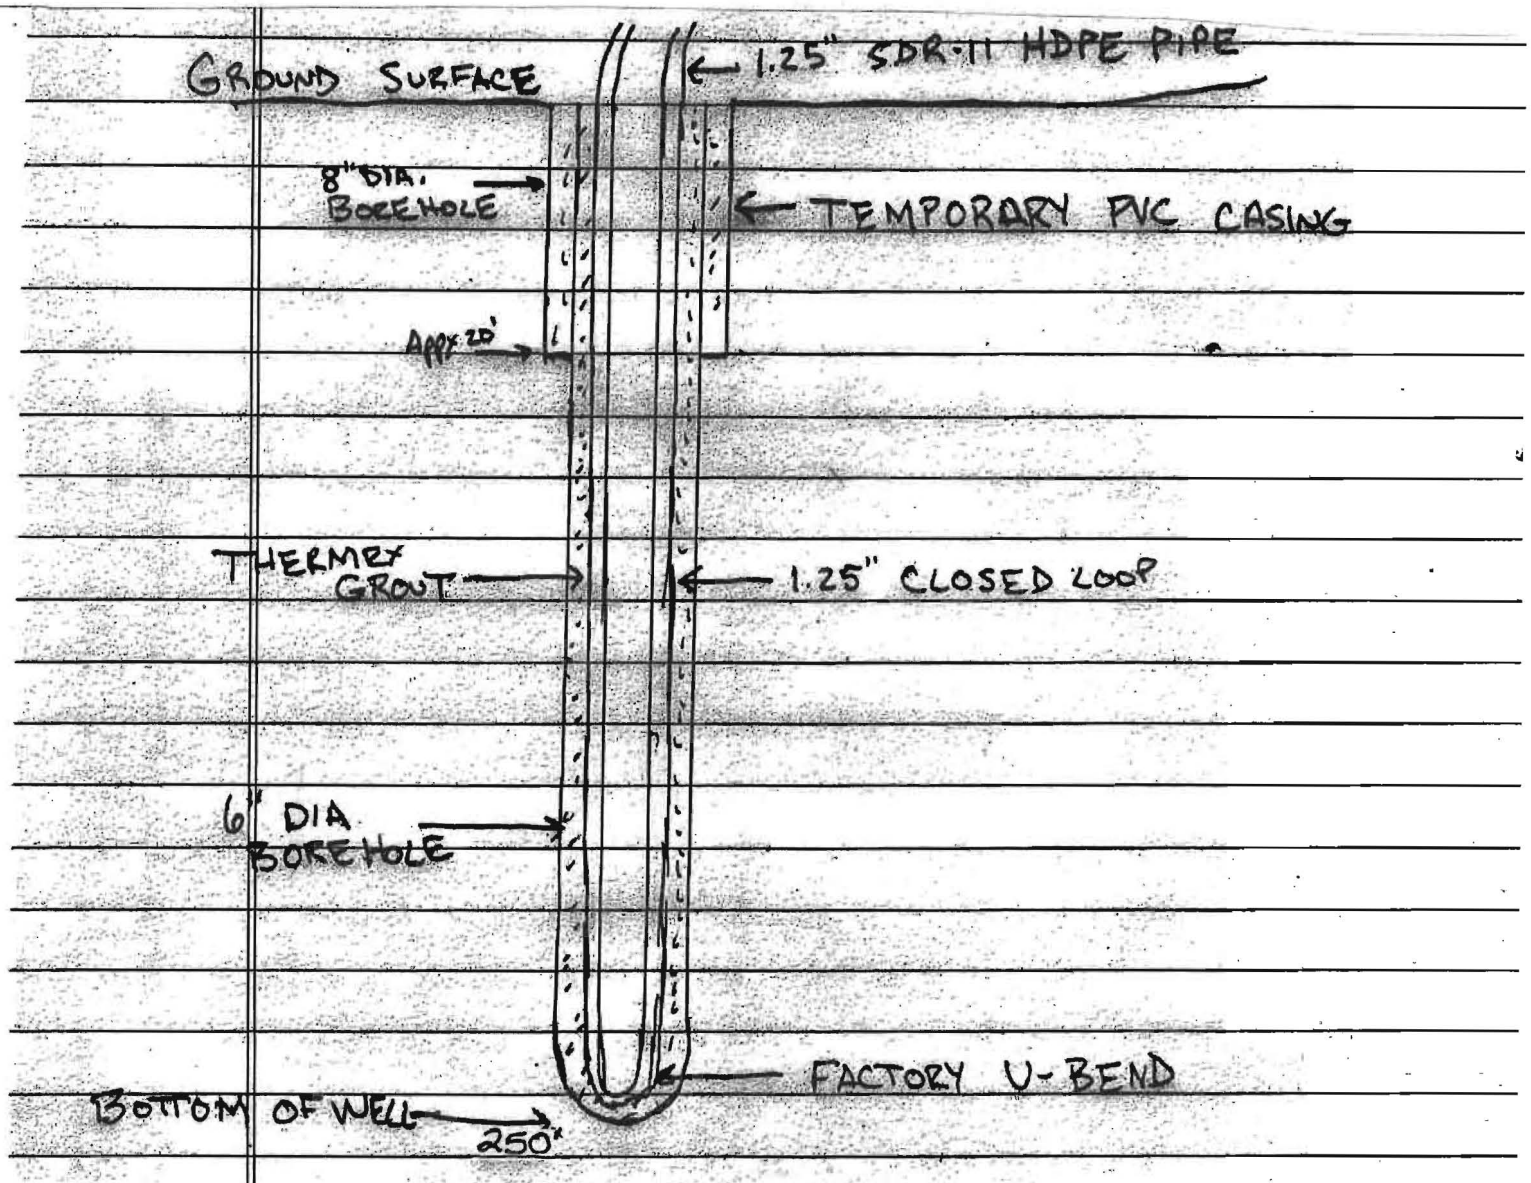

Grout information for this property is as follows:


Thermex grout mixture of 50 lb. grout to 17 gallons water, placed in the well using the tremie method, from bottom to top.



HOME LAND
SEPTIC
CONSULTING, LLC

HOME LAND SEPTIC CONSULTING LLC
PHONE (443) 995-5385
WWW.MDWELLANDSEPTIC.COM
INFO@MDWELLANDSEPTIC.COM

Sketch of System

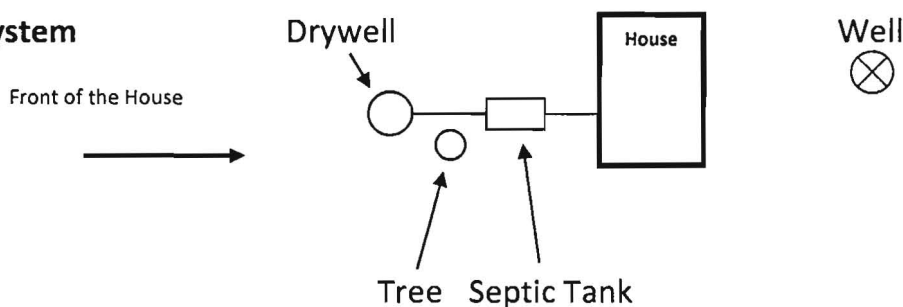

- This is a subjective and visual inspection only, based upon many unknown and unseen factors.
- A 'Satisfactory' evaluation does not mean the system will meet the local approving authority's criteria for determining compliance with state code: COMAR 26.04.02.02 D(4).
- The condition of the Sewage Disposal System is reported as and only as the day of the inspection.
- **This report does not WARRANT nor GUARANTEE** continued functional Sewage Disposal Systems operations.
- If house has been unoccupied this report may not be accurate. Little or no use of the septic system could have allowed problems to temporarily clear themselves.
- If the general ground condition is wet, this report may not be accurate, as ground moisture may cover or hide actual septic effluent on the service.
- In the above cases, it is recommended that the septic system be reevaluated in 2 to 4 months.
- Payment and/or use of this evaluation signifies understanding and acceptances of the above clauses, as well as any noted faults with the system.

Representative's Signature:

Date: 6/19/2014

Amount: \$525 (All testing) Check Number: 1009 Date Paid: 6/19/2014