

1/28/66

PERMIT

4-20/66
approved
1/28/66
very

SEWAGE DISPOSAL SYSTEM

P 10406

A 05882

MARYLAND STATE DEPARTMENT OF HEALTH

HOWARD COUNTY

ELLICOTT CITY

DISTRICT 4

DATE 6/28/65

INDEXED

Alonso Powell IS PERMITTED TO INSTALL ☒ ALTER

ADDRESS Daisy Rd., Woodhine, Md. PHONE

A SEWAGE DISPOSAL SYSTEM LOCATED AT

SUBDIVISION ROAD Daisy Rd. LOT

PROPERTY OWNER Alonso Powell

ADDRESS

SPECIFICATIONS - 3 bedrooms

DRAIN FIELD DEPTH FEET, BOTTOM AREA SQ. FT.

SEEPAGE PITS ABSORBENT SIDE-WALL AREA SQ. FT.

SEPTIC TANK CAPACITY 750 GALLONS

FOR GARBAGE GRINDER, INCREASE DISPOSAL AREA 22% & TANK CAPACITY 50%.


OTHER Dry well - 300 sq. ft. absorbent sidewall area to begin below the inlet pipe.
Place dry well in area that passed percolation test (about 63 ft. from front of House).

PLANS APPROVED BY Donald W. Monaghan DATE 10/16/62

FILL SEPTIC TANK AND DISTRIBUTION BOX WITH WATER BEFORE CALLING FOR AN INSPECTION. COVER NO WORK UNTIL INSPECTED AND APPROVED.

NEITHER THE HOWARD COUNTY COMMISSIONERS NOR THE HEALTH DEPARTMENT IS RESPONSIBLE FOR THE SUCCESSFUL OPERATION OF ANY SYSTEM.

A05882

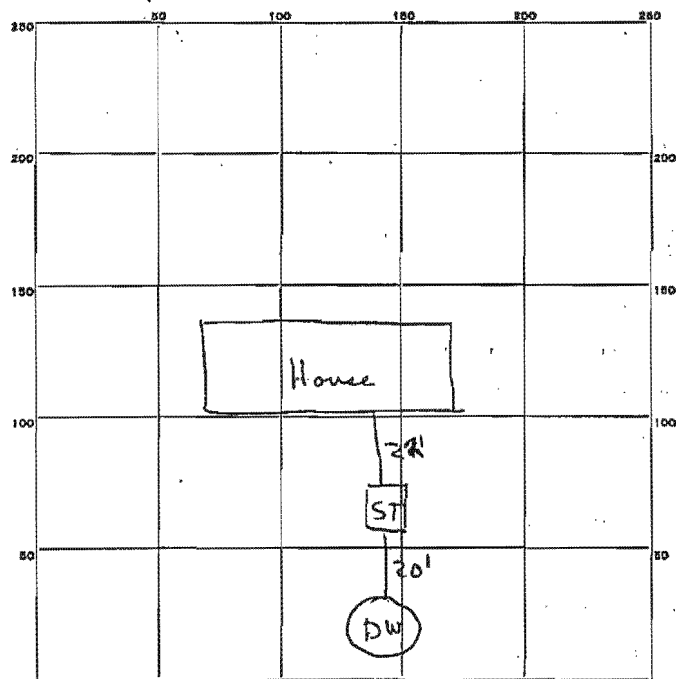

INDICATE NORTH - NAME ADJOINING ROADWAY AS BASE LINE.

PERMIT CARD OK

Daisy Rd.

SEPTIC TANK, LEVEL OK

CLEANOUTS OK

DISTRIBUTION BOX, LEVEL _____

TILE FIELD, DEPTH _____ FT. TRENCH WIDTH _____ FT.

GRAVEL DEPTH _____ IN. TOTAL LENGTH _____ FT.

NUMBER OF TRENCHES _____ TOTAL BOTTOM AREA _____

SEEPAGE PITS, INSIDE DIAMETER 12 FT. DEPTH BELOW INLET 10 FT.

ABSORBENT AREA 300 SQ. FT.

REMARKS 1/18/66 - Incomplete - gravel not around dugwell - P.F.

DATE SYSTEM APPROVED 1-28-66 INSPECTOR W. Manning