



7.23.98
 Proposed garage addition
 will have no impact on
 well & septic as
 shown *km*

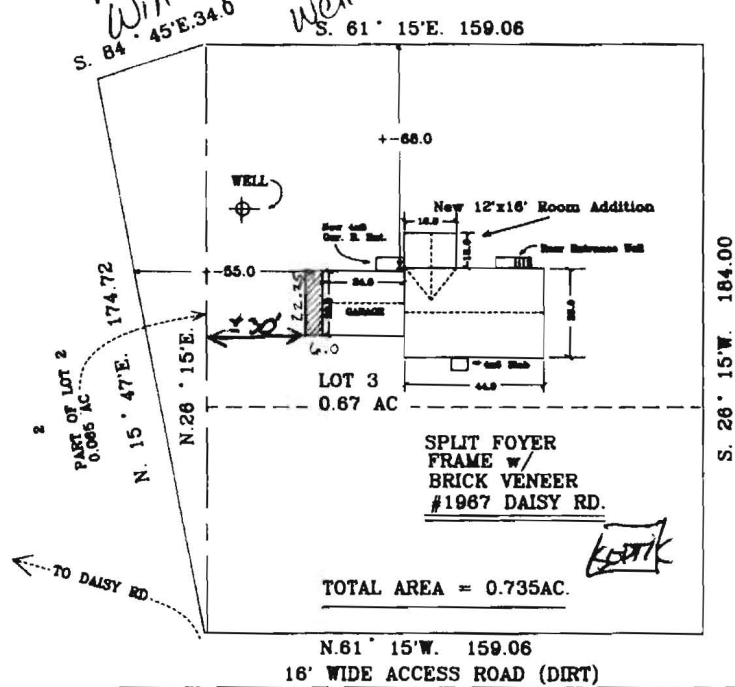


HOUSE LOCATION SURVEY
 PART OF LOT 2 &
 LOT 3
 UNRECORDED PLAT OF
 WARFIELDS SUBDIVISION
 HOWARD COUNTY, MD
 FRANCIS IDA WISE, ET. AL., PROPERTY

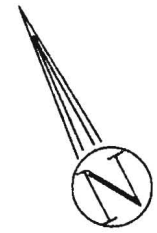

SURVEYOR'S CERTIFICATE		REFERENCES		FRANCIS J. TACIK PROFESSIONAL LAND SURVEYOR LAND PLANNING CONSULTANT	
I HEREBY CERTIFY THAT THE POSITION OF ALL THE EXISTING IMPROVEMENTS ON THE ABOVE DESCRIBED PROPERTY HAS BEEN CAREFULLY ESTABLISHED BY A TRANSIT-TAPE SURVEY AND THAT UNLESS OTHERWISE SHOWN, THERE ARE NO ENCRDACHMENTS.		PLAT BK.		CRU 770-3642 - ROCKVILLE CRU 632-8886 - FREDERICK ROUTE 6 FREDERICK, MARYLAND 21704	
		PLAT NO.			
<i>Francis J. Tacik</i> ----- FRANCIS J. TACIK PROFESSIONAL LAND SURVEYOR REGISTERED LAND SURVEYOR MARYLAND #9164		LIBER. 437		DATE OF SURVEYS	SCALE: 1"=40'
		FOLIO. 659		WALL CHECK:	DRAWN BY: J
				HSE. LOC. 2-3-75	
				BOUNDARY:	JOB NO. 1675

RECEIVED
HOWARD COUNTY HEALTH DEPT.
ENVIRONMENTAL HEALTH

1998 JL 21 PM 4:58

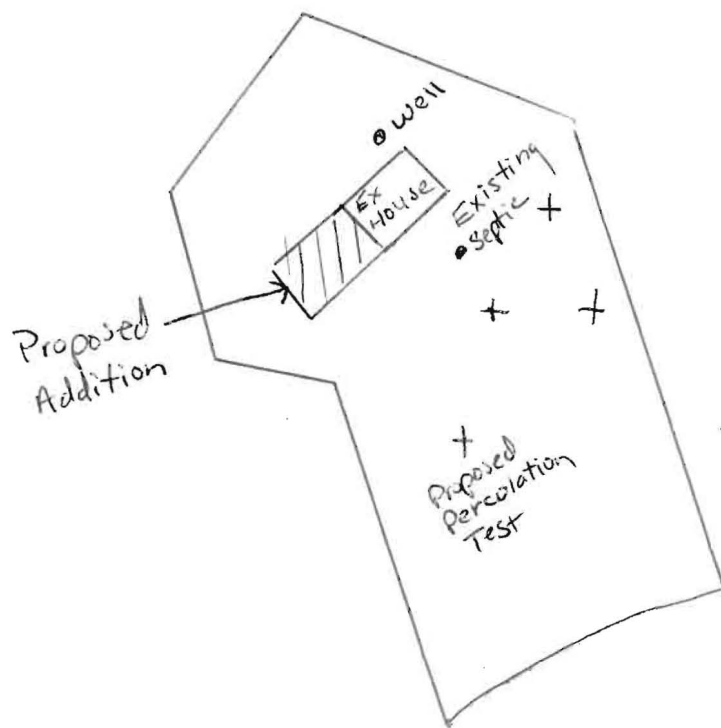

0 50
ft.

Perc. Test Proposal test
for 1979 Daisy Rd, Woodbine

Sheila Suarez 11/9/07
Sheila Suarez