

04-313585

## PERMIT

SEWAGE DISPOSAL SYSTEM

MARYLAND STATE DEPARTMENT OF HEALTH\*

HOWARD COUNTY

ELLICOTT CITY

DISTRICT 4th

INDEXED

DATE 4/25/78File  
P 27942  
A 25885Westminster Lawn ServiceIS PERMITTED TO INSTALL X ALTERADDRESS Westminster, Md.PHONE 876-1400SUBDIVISION (Warfields Subdivision) ROAD 1967 Daisy Road LOT 3PROPERTY OWNER Lawrence W. StantonADDRESS 1967 Daisy Road, Woodbine, Md.SPECIFICATIONS 3 bedroomsSEPTIC TANK CAPACITY 1000 GALLONS

DRAIN FIELD \_\_\_\_\_ DEPTH \_\_\_\_\_ FEET, BOTTOM AREA \_\_\_\_\_ SQ. FT.

DEEP TRENCH \_\_\_\_\_ DEPTH \_\_\_\_\_ FEET, BOTTOM AREA \_\_\_\_\_ SQ. FT.

SEEPAGE PITS \_\_\_\_\_ ABSORBENT SIDE-WALL AREA 576 SQ. FT. total absorbent areaINLET PIPE 4 FT. BELOW ORIGINAL GRADE. MAXIMUM DEPTH 12 FT. BELOW ORIGINAL GRADEEFFECTIVE DEPTH AT 5 FT. BELOW ORIGINAL GRADE.

LOCATE DISPOSAL AREA \_\_\_\_\_ FT. FROM \_\_\_\_\_ LOT LINE AND \_\_\_\_\_ FT. FROM \_\_\_\_\_ LOT LINE AS SEEN WHEN

FACING LOT FROM

Locate dry well as per approved  
~~Place the dry well 75 ft. from the old house and 60 ft. from the back lot line as~~  
plan attached.  
~~seen when facing the lot from the right of way. OK to add ditch off dry well if~~  
necessary. Stone in ditch to be between 5 ft. & 12 ft.

BLDG. PERMIT SIGNED  
 AND RETURNED 7-23-78  
Serial # 372113102  
when visiting garage

PLANS APPROVED BY Raymond Hodges DATE 6/8/77

COVER NO WORK UNTIL INSPECTED AND APPROVED.

NEITHER THE HOWARD COUNTY COUNCIL NOR THE HEALTH DEPARTMENT IS RESPONSIBLE FOR THE SUCCESSFUL OPERATION OF ANY SYSTEM.

NOTE: IF TRENCH IS USED CALL FOR INSPECTION BEFORE PLACING GRAVEL IN TRENCH.

NOTE: NO DRY WELL SHALL EXCEED 15 FOOT IN DIAMETER.

NOTE: ALL PIPE FROM HOUSE TO DISPOSAL AREA MUST BE CAST IRON.

PERMIT VOID AFTER THREE YEARS.


NOTE: INSTALL STAND PIPE ON SEPTIC TANK AND DRY WELL. STAND PIPES MUST BE 6 INCHES IN DIAMETER. CAST IRON, CONCRETE OR TERRA

COTTA ACCEPTED.

\*INSTALLER IS RESPONSIBLE FOR OBTAINING FINAL APPROVAL ON THIS PERMIT.

BLDG. PERMIT SIGNED  
 AND RETURNED 9/26/91  
Serial # 34450  
addition - sun room

A 25885

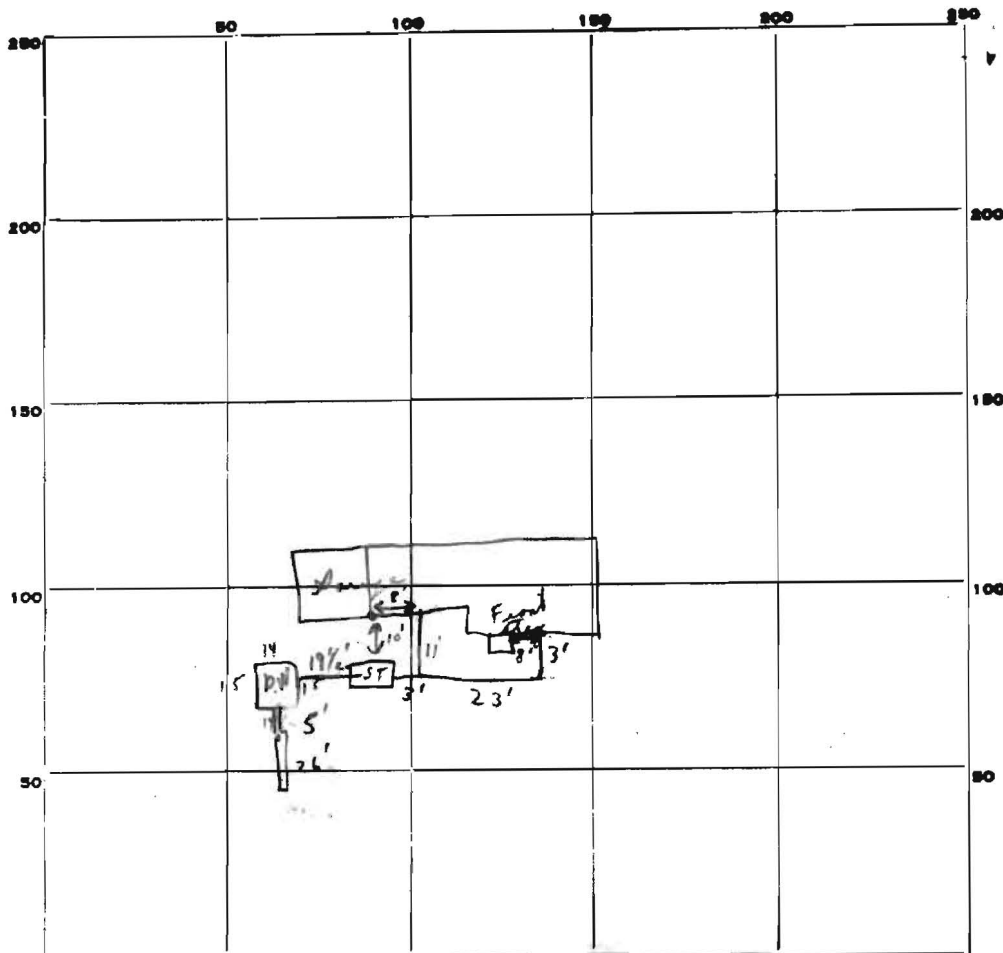

PERMIT CARD

SEPTIC TANK, LEVEL

DISTRIBUTION BOX, LEVEL

Trench FIELD, DEPTH 12 FT. TRENCH WIDTH - 12" gravel in trench at time of check & paper on 2 1/2' of gravel

GRAVEL DEPTH 7 1/2" IN. TOTAL LENGTH 26 FT. ①

NUMBER OF TRENCHES 1 TOTAL BOTTOM AREA -

SEEPAGE PITS, INSIDE DIAMETER 58.5 FT. DEPTH BELOW INLET 8 FT. ②

ABSORBENT AREA + - SQ. FT.

REMARKS 5/26/78 Discussed with Mr. Visk. Always call off before installing gravel-stone in trench. C.B.D.

DATE SYSTEM APPROVED

5/26/78 Inspector C. B. Thresh above