



<b>B 1</b> <span style="font-size: 24pt; font-weight: bold;">37581</span> <small>1 2 3 6</small>	SEQUENCE NO. (MDE USE ONLY)  <div style="border: 1px solid black; padding: 2px; display: inline-block;">546358</div>	<b>STATE OF MARYLAND</b> <b>APPLICATION FOR PERMIT TO DRILL WELL</b> please type	STATE PERMIT NUMBER <div style="border: 1px solid black; padding: 2px; display: inline-block;">HO-14-0023</div> <small>fill in this form completely</small>
---	---	--	---

Date Received (APA) <div style="border: 1px solid black; padding: 2px; display: inline-block;">051214</div> <small>8 MM DD YY 13</small> <b>OWNER INFORMATION</b> <div style="border: 1px solid black; padding: 2px; display: inline-block;">Laurie Marylesa + Robert</div> <small>15 Last Name Owner First Name 34</small> <div style="border: 1px solid black; padding: 2px; display: inline-block;">2425 Daisy Rd</div> <small>36 Street or RFD 55</small> <div style="border: 1px solid black; padding: 2px; display: inline-block;">Woodbine Md 21797</div> <small>57 Town 70 State 72 Zip 76</small>	<b>B 3</b> <b>LOCATION OF WELL</b> <span style="font-size: 24pt; font-weight: bold;">HO-14-0023</span> <div style="border: 1px solid black; padding: 2px; display: inline-block;">Howard</div> <small>8 COUNTY 21</small> <div style="border: 1px solid black; padding: 2px; display: inline-block;">23</div> <small>23 SUBDIVISION 42</small> <div style="border: 1px solid black; padding: 2px; display: inline-block;">SECTION 44 46 LOT 48 50</div> <div style="border: 1px solid black; padding: 2px; display: inline-block;">Lisbon</div> <small>52 NEAREST TOWN 71</small>
---	--

<b>DRILLER INFORMATION</b> <div style="border: 1px solid black; padding: 2px; display: inline-block;">Joseph L Mayne</div> <span style="font-size: 24pt; font-weight: bold;">MSD024</span> <small>Driller's Name 76 License No. 81</small> <div style="border: 1px solid black; padding: 2px; display: inline-block;">Joseph L Mayne Well Drilling</div> <small>Firm Name</small> <div style="border: 1px solid black; padding: 2px; display: inline-block;">5512 Ridgely Rd Mt Airy 21771</div> <small>Address</small> <div style="border: 1px solid black; padding: 2px; display: inline-block;">Joseph L Mayne 5-9-2014</div> <small>Signature Date</small>	<b>B 4</b> <b>SOURCES OF DRILLING WATER</b> 1. well 2. 3. <div style="border: 1px solid black; padding: 2px; display: inline-block;">2425 Daisy Rd</div> <small>11 STREET ADDRESS 30</small> <div style="border: 1px solid black; padding: 2px; display: inline-block;">ON WHICH SIDE OF ROAD (CIRCLE APPROPRIATE BOX)</div> <div style="display: flex; justify-content: space-around; align-items: center;"> <div style="text-align: center;"> <small>NORTH</small>  <div style="border: 1px solid black; padding: 2px; display: inline-block;">N</div>  <small>WEST</small>  <div style="border: 1px solid black; padding: 2px; display: inline-block;">W</div>  <small>SOUTH</small>  <div style="border: 1px solid black; padding: 2px; display: inline-block;">S</div>  <small>EAST</small>  <div style="border: 1px solid black; padding: 2px; display: inline-block;">E</div> </div> <div style="text-align: center;"> <small>34 550 37</small>  <small>DISTANCE FROM ROAD</small>  <small>ENTER FT OR MI</small> <span style="font-size: 24pt; font-weight: bold;">54</span> <small>38 39</small> </div> </div> <div style="border: 1px solid black; padding: 2px; display: inline-block;">TAX MAP: 14 BLK: 7 PARCEL 174</div>
--	---

<b>B 2</b> <b>WELL INFORMATION</b> <small>1 2</small> APPROX. PUMPING RATE <span style="font-size: 24pt; font-weight: bold;">5</span> <small>(GAL. PER MIN.) 8 12</small> AVERAGE DAILY QUANTITY NEEDED <span style="font-size: 24pt; font-weight: bold;">500</span> <small>(GAL. PER DAY) 14 20</small>	<b>USE FOR WATER (CIRCLE APPROPRIATE BOX)</b> <div style="border: 1px solid black; padding: 2px; display: inline-block;">D</div> DOMESTIC POTABLE SUPPLY & RESIDENTIAL IRRIGATION <div style="border: 1px solid black; padding: 2px; display: inline-block;">F</div> FARMING (LIVESTOCK WATERING & AGRICULTURAL IRRIGATION) <div style="border: 1px solid black; padding: 2px; display: inline-block;">I</div> INDUSTRIAL, COMMERCIAL, DEWATERING <div style="border: 1px solid black; padding: 2px; display: inline-block;">P</div> PUBLIC WATER SUPPLY WELL <div style="border: 1px solid black; padding: 2px; display: inline-block;">T</div> TEST, OBSERVATION, MONITORING <div style="border: 1px solid black; padding: 2px; display: inline-block;">O</div> OPEN LOOP GEOTHERMAL <div style="border: 1px solid black; padding: 2px; display: inline-block;">C</div> CLOSED LOOP GEOTHERMAL
---	---

APPROXIMATE DEPTH OF WELL <span style="font-size: 24pt; font-weight: bold;">300</span> FEET <small>24 28</small> APPROXIMATE DIAMETER OF WELL <span style="font-size: 24pt; font-weight: bold;">6</span> INCH <small>NEAREST INCH</small>	<b>NOT TO BE FILLED IN BY DRILLER HEALTH DEPARTMENT APPROVAL</b> <div style="border: 1px solid black; padding: 2px; display: inline-block;">Howard</div> <span style="font-size: 24pt; font-weight: bold;">(13)</span> <span style="font-size: 24pt; font-weight: bold;">A21795</span> <small>COUNTY NAME COUNTY NO.</small> STATE SIGNATURE _____ INSERT S → _____ <small>DATE ISSUED 41</small> <div style="border: 1px solid black; padding: 2px; display: inline-block;">6/4/2014</div> <span style="font-size: 24pt; font-weight: bold;">Brian Baber</span> <span style="font-size: 24pt; font-weight: bold;">6/4/2015</span> <small>43 MM DD YY 48 CO SIGNATURE EXP. DATE</small>
--	---


<b>METHOD OF DRILLING (circle one)</b> BORED (or Augered) <span style="border: 1px solid black; padding: 2px; display: inline-block;">JETTET</span> Jettet & DRIVEN <small>30 AIR-ROTARY AIR-PERCussion ROTARY (Hydraulic Rotary)</small> <small>37 CABLE REVerse-ROTary Drive-POINT</small> other _____	<b>PROPOSED LOCATION OF WELL ON LOT</b> SHOW PERMANENT STRUCTURES SUCH AS BUILDINGS, SEPTIC SYSTEM, ROADS AND/OR LANDMARKS AND INDICATE NOT LESS THAN TWO DISTANCE MEASUREMENTS TO WELL <div style="border: 1px solid black; padding: 2px; display: inline-block;">Lisbon 481504</div> <div style="border: 1px solid black; padding: 2px; display: inline-block;">A E Mullins Rd</div> <div style="border: 1px solid black; padding: 2px; display: inline-block;">Daisy Rd</div> <div style="border: 1px solid black; padding: 2px; display: inline-block;">Well</div> <div style="text-align: center;"> <small>N</small>  <div style="border: 1px solid black; padding: 2px; display: inline-block;">↑</div> </div>
--	--

<b>REPLACEMENT OR DEEPEMED WELLS (CIRCLE APPROPRIATE BOX)</b> <div style="border: 1px solid black; padding: 2px; display: inline-block;">N</div> THIS WELL WILL NOT REPLACE AN EXISTING WELL <div style="border: 1px solid black; padding: 2px; display: inline-block;">Y</div> THIS WELL WILL REPLACE A WELL THAT WILL BE ABANDONED AND SEALED <div style="border: 1px solid black; padding: 2px; display: inline-block;">S</div> THIS WELL WILL REPLACE A WELL THAT WILL BE USED AS A STANDBY-CONTACT LOCAL APPROVING AUTHORITY FOR POLICY ON STANDBY WELLS <div style="border: 1px solid black; padding: 2px; display: inline-block;">D</div> THIS WELL WILL DEEPEN AN EXISTING WELL PERMIT NUMBER OF WELL TO BE REPLACED OR DEEPEMED (IF AVAILABLE) 41 _____ 52	<b>Not to be filled in by driller (MDE OR COUNTY USE ONLY)</b> APPROP. PERMIT NUMBER _____ <span style="font-size: 24pt; font-weight: bold;">G</span> _____ PERMIT No. <span style="font-size: 24pt; font-weight: bold;">HO-14-0023</span> <small>70 71 72 73 74 75 76 77 78 79</small>
--	--

<b>SPECIAL CONDITIONS</b> <small>NOTE APPROVING AUTHORITIES SHOULD USE SEPARATE SHEET IF NEEDED</small>	<div style="border: 1px solid black; padding: 2px; display: inline-block;">HO-14-0023</div>
--	---



7178 Columbia Gateway Drive, Columbia, MD 21046  
(410) 313-2640 Fax (410) 313-2648  
TDD (410) 313-2323 Toll Free 1-866-313-6300  
website: www.hchealth.org

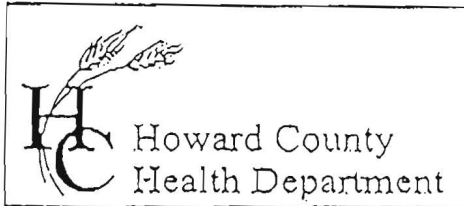Penny E. Borenstein, M.D., M.P.H., Health Officer

TO ALL INTERESTED PARTIES

- When submitting a well permit application for a proposed well for new construction, please indicate one of the following:

Well Site Location:

Subdivision/Property Name      Lot#      2425 Daisy Rd  
Road Name

- ☐ The well site has been staked by \_\_\_\_\_  
(professional land surveyor or company employing professional land surveyors)  
on \_\_\_\_\_ (date) and does not require a site inspection.

- ☒ The well driller, builder or property owner will call the Health Department to schedule a time to meet in the field to verify the proposed well site location.

This sheet, along with two copies of an acceptable well site plan, must be attached to the green well permit application.

Revised 3/11/05

*Robert + Mary Lisa Lewis*  
*C-443-742-8926*


*Staked by Joseph L. Mayne well driller*  
*5-8-2014*

*Well for barn.*



Property Map

*Well for Barn*

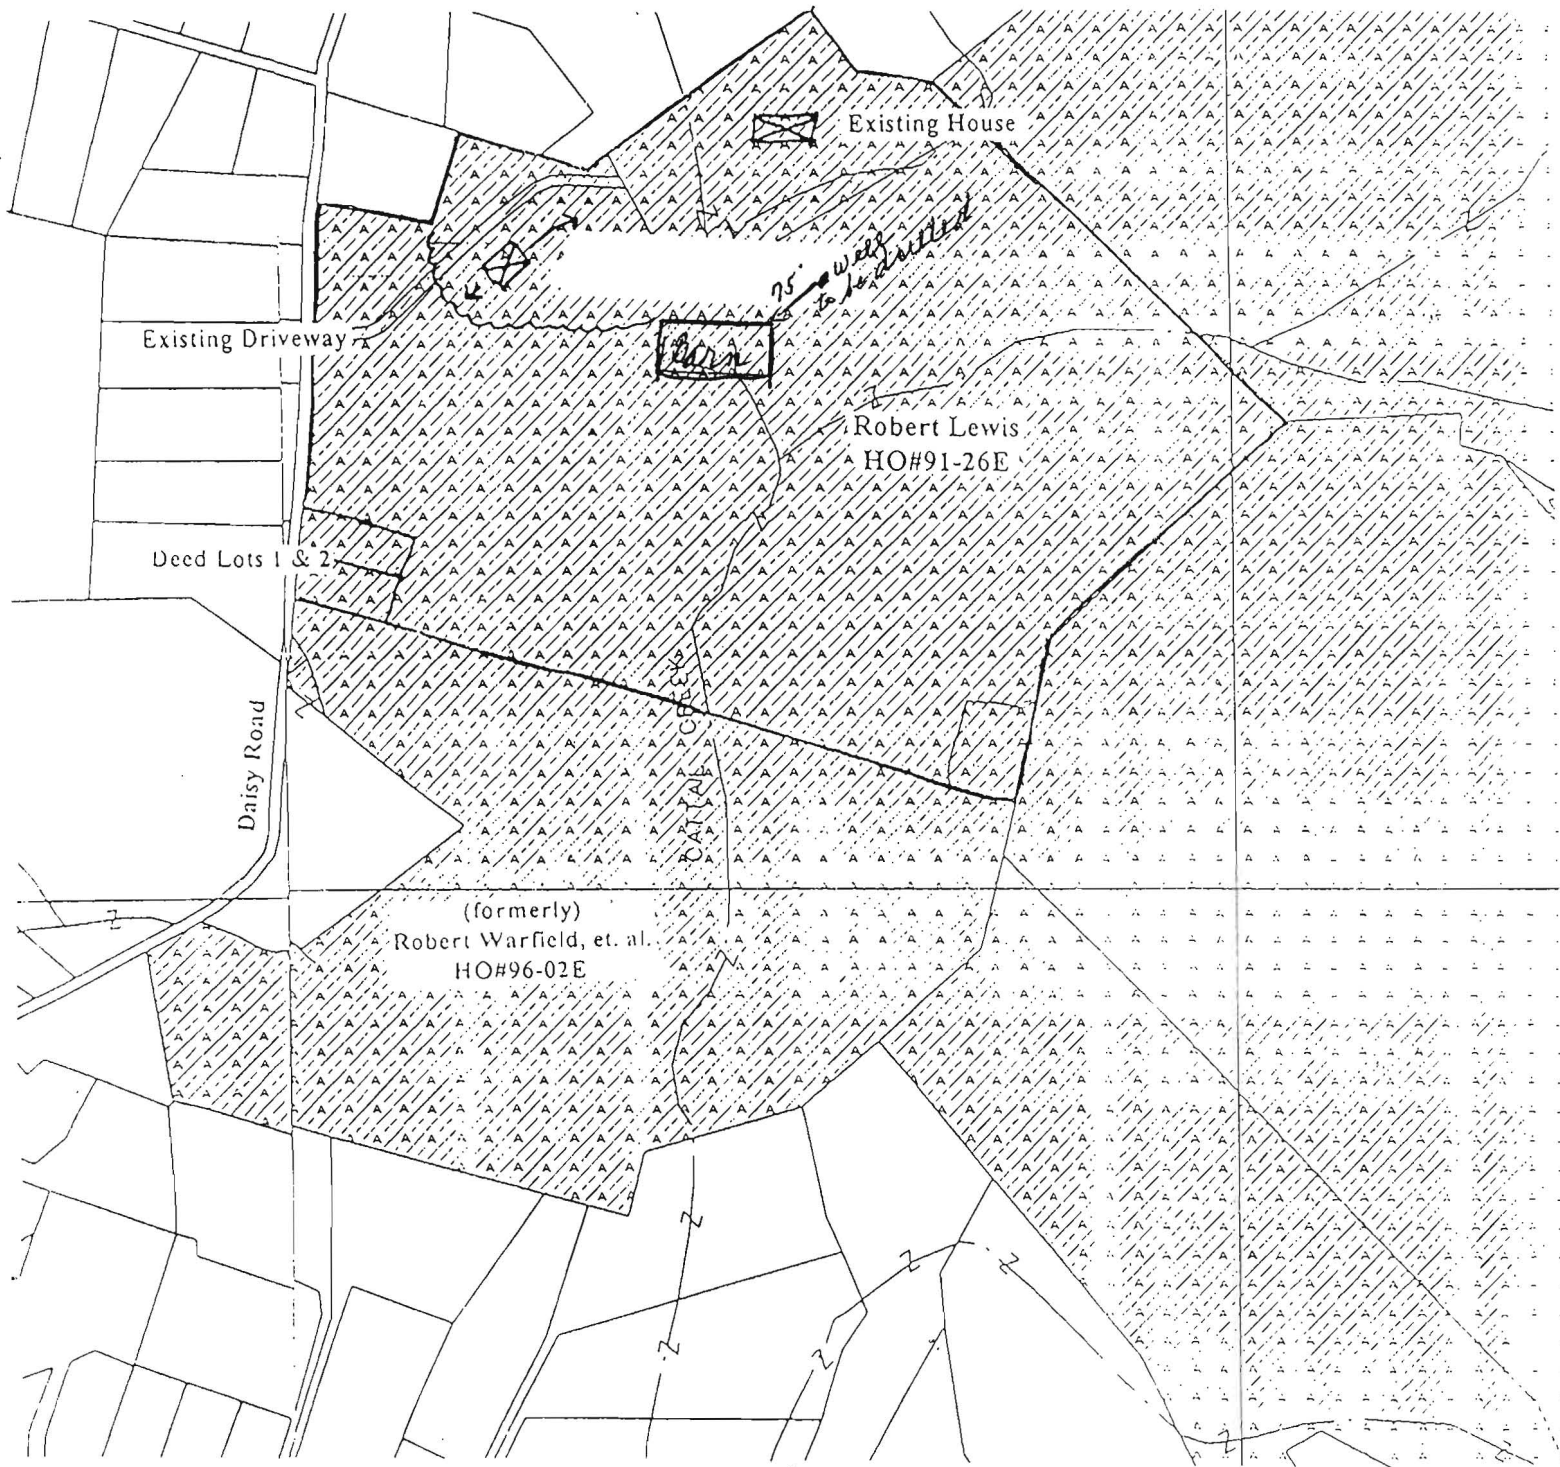

Daisy Rd

# 481503

Tel. Pole

~142'

Driveway

~118'

Telephon Pole

#481504

Proposed  
Barn Site

House

Staked Well  
@ site for Future  
Barn