



Howard County
Health Department

Bureau of Environmental Health

8930 Stanford Boulevard, Columbia, MD 21045

Main: 410-313-2640 | Fax: 410-313-2648

TDD 410-313-2323 | Toll Free 1-866-313-6300

www.hchealth.org

Facebook: www.facebook.com/hocohealth

Maura J. Rossman, M.D., Health Officer

RECEIPT DATE: 4/25/16

ONSITE SEWAGE DISPOSAL SYSTEM

P 558092

APPROVAL DATE: 5/10/16 SEC

PERMIT:

REPAIR

A

PROPERTY ADDRESS: 16835 Colton Court

SUBDIVISION:

LOT:

TAX ID: 04-324447

CONTRACTOR: Fogle's Septic Clean Inc.

EMAIL: kevin@foglesinc.com

CONTRACTOR ADDRESS: 580 Obrecht Road, Sykesville, MD 21784

PHONE: 410-795-5670

PROPERTY OWNER: Deb Manning

EMAIL:

OWNER ADDRESS: 16835 Colton Court, Woodbine, MD 21797

PHONE: 443-266-7192

SEPTIC TANK SIZE (GALLONS):

PUMP CHAMBER CAPACITY (GALLONS):

PUMP SIZE:

NUMBER OF BEDROOMS: 4

HOUSE SQ. FT.

APPLICATION RATE:

DISTRIBUTION SYSTEM: GRAVITY FED ☐

LOW PRESSURE DOSED ☐

TRENCHES:	LINEAR FEET REQUIRED:	INLET DEPTH:
	TRENCH WIDTH:	MAXIMUM BOTTOM DEPTH:
	MINIMUM SPACE BETWEEN TRENCHES:	EFFECTIVE AREA BEGINNING DEPTH:
LOCATION:	TO BE STAKED BY SANITARIAN DURING PRE-CONSTRUCTION INSPECTION.	
NOTES:	Install 1500-gal (minimum) tank, 2-compartment + slotted. Keep tank 20' off house.	

ISSUED BY: Sarah Collins

ISSUE DATE: 4/28/16

EXPIRATION DATE: 4/28/17

NOTE: CONTRACTOR MUST SCHEDULE A PRE-CONSTRUCTION INSPECTION PRIOR TO BEGINNING ANY INSTALLATION

NOTE: CONTRACTOR MUST SCHEDULE AN INSPECTION AND GAIN APPROVAL OF ALL COMPONENTS PRIOR TO COVERING

NOTE: STONE MUST BE APPROVED BY HEALTH DEPARTMENT AND GRAVEL TICKET MUST BE AVAILABLE FOR REVIEW.

NOTE: WATERTIGHT SEPTIC TANKS REQUIRED

NOTE: ALL PARTS OF SEPTIC SYSTEM SHALL BE AT LEAST 100 FEET DOWNGRADIENT FROM ANY WATER WELL

NOTE: MANHOLE RISERS REQUIRED ON ALL SEPTIC TANKS AND PUMP CHAMBERS

NOTE: AN ELECTRICAL PERMIT IS REQUIRED FOR INSTALLATION OF ANY ELECTRICAL COMPONENTS OF THE SYSTEM

☐ ELECTRICAL PERMIT ISSUED E

NOTE: THE HCHD DOES NOT WARRANTY ANY SYSTEM AND CANNOT GUARANTEE THE PERFORMANCE OF THIS SYSTEM AS DESIGNED. BY ACCEPTING THIS PERMIT, THE OWNER AND/OR APPLICANT ACKNOWLEDGE THAT THE SPECIFICATIONS DETAILED IN THIS DESIGN ARE ONE POSSIBLE OPTION AND THAT THE HCHD WILL REVIEW OTHER PROPOSALS. YOU HAVE THE OPTION TO SEEK THE ADVICE OF A QUALIFIED DESIGN CONSULTANT OR PROFESSIONAL ENGINEER FOR FURTHER GUIDANCE.


NOTE: MDE RECOMMENDS SEPTIC TANKS, BAT, AND OTHER PRETREATMENT UNITS BE PUMPED AT A FREQUENCY ADEQUATE TO ENSURE THAT SOLIDS ARE NOT DISCHARGED TO THE DISPOSAL AREA

NEITHER THE HOWARD COUNTY COUNCIL NOR THE HEALTH DEPARTMENT IS RESPONSIBLE FOR THE SUCCESSFUL OPERATION OF ANY SYSTEM.

PERMITTEE RESPONSIBLE FOR OBTAINING FINAL APPROVAL ON THIS PERMIT.

CALL 410-313-1771 TO SCHEDULE INSPECTIONS.

NOT TO SCALE

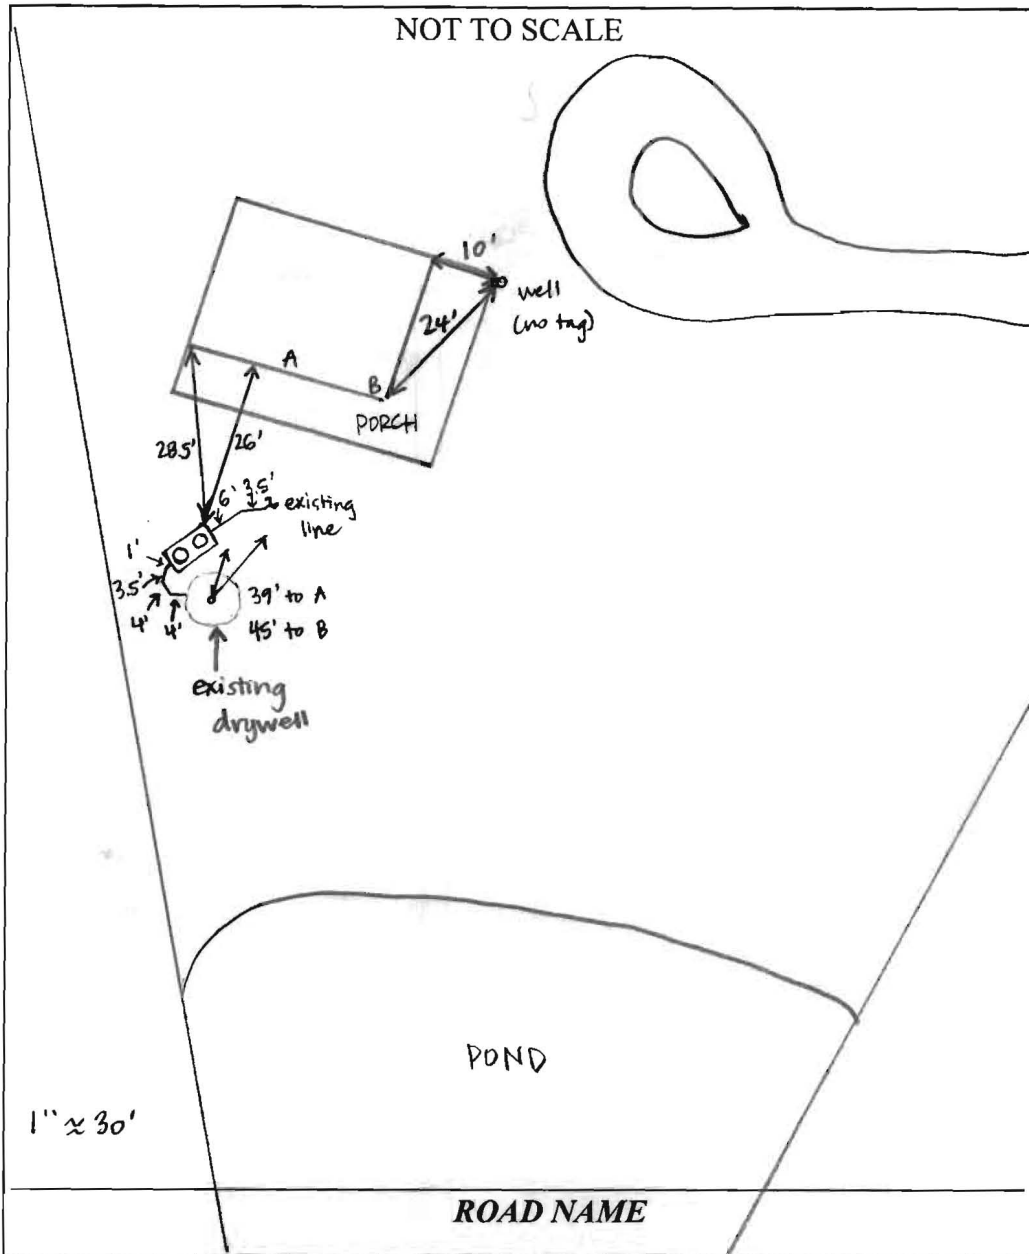

TRENCH/DRAINFIELD DATA

WIDTH INLET BOTTOM

NUMBER OF TRENCHES
TOTAL LENGTH
ABSORPTION AREA
DISTRIBUTION BOX LEVEL
DISTRIBUTION BOX BAFFLE
DISTRIBUTION BOX PORT

SEPTIC TANK DATA

SEPTIC TANK I LEVEL
MANUFACTURER BABYLON
CAPACITY 1500 GAL
SEAM LOC TOP
TANK LID DEPTH 1-2'
BAFFLES 6" inlet, 4" outlet
BAFFLE FILTER NONE
MANHOLE LOC FRONT + REAR
6" PORT LOC NONE
WATERTIGHT TEST NO
SLOTTED YES
DATE ON LID 2-6-16

PUMP/SEPTIC TANK LEVEL

MANUFACTURER
CAPACITY _____ GAL
SEAM LOC
TANK LID DEPTH
BAFFLES
BAFFLE FILTER
MANHOLE LOC
6" PORT LOC
WATERTIGHT TEST
SLOTTED
DATE ON LID

PRE-CONSTRUCTION:

INSTALLATION: 5/9/16 1500-gal 2-compartment tank installed, NOT slotted. On site while Fogle's cutting slot as per Babylon's specs for 1500-gal. 2-compartment slotted tank (slot 24" off bottom, 4" tall, 4' wide). No lid on dry well - possibly collapsed + filled in with stone previously. No liquid found with 4' probe. Fogle's running a new perforated pipe across top + marking center with 4" stand pipe. Slot ~ halfway cut during site visit. (SC) 5/10/16 Slot cut in tank to specs described above. Center T turned 90° + capped. Tank tied into stone pit, 7.5' diameter + has 4" stand pipe to mark. (SC)

FINAL INSPECTOR Sarah Collins DATE OF APPROVAL 5/10/16