

MARYLAND DEPARTMENT OF THE ENVIRONMENT, WATER MANAGEMENT ADMINISTRATION  
1800 Washington Blvd., Baltimore, Maryland 21230 (410) 537-3784

WATER WELL ABANDONMENT-SEALING REPORT FORM

SUBMIT COPIES OF COMPLETED FORM TO:

- \* COUNTY ENVIRONMENTAL AGENCY (contact MDE, WMA if address needed)
- \* WELL OWNER
- \* MDE, WATER MANAGEMENT ADMINISTRATION, WELL PROGRAM

DATE WELL ABANDONED: 6/30/16 (month/day/year)

\* Connected to public water

\* PERMIT NUMBER OF ABANDONED WELL (if any) \_\_\_\_\_

\* PERMIT NUMBER OF REPLACEMENT WELL: \_\_\_\_\_

\* PERSON ABANDONING WELL: Andrew Houseman


WELL DRILLER'S LICENSE NUMBER: 224

CIRCLE: MWD / MSD / MGD

\* OWNER'S NAME: Jim Cathcart

SITE LOCATION MAP

\* WELL LOCATION:  
COUNTY: Howard  
NEAREST TOWN: Ellicott City  
TAX MAP 0030 BLOCK 0005 PARCEL 0218  
SUBDIVISION: Columbia Hills  
SECTION: \_\_\_\_\_ LOT: 37  
STREET ADDRESS: 4617 S. Leisure Ct

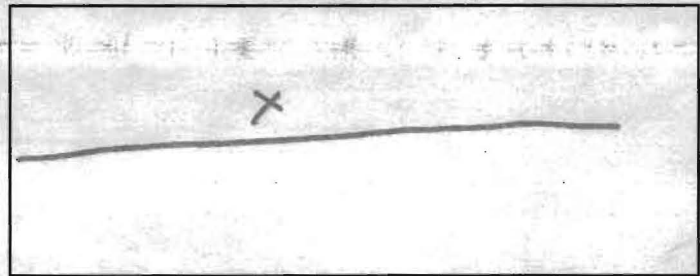

LATITUDE 3 9.245256

LONGITUDE 7 6.826461

LOG OF SEALING MATERIAL

MATERIAL	FEET	
	FROM	TO
<u>Benotone</u>	<u>-3</u>	<u>80</u>
VOLUME OF MATERIAL USED		
<u>28 bags</u>		

\* TYPE OF WELL BEING ABANDONED:

DRILLED \_\_\_\_\_ JETTED \_\_\_\_\_  
\_\_\_\_\_ BORED \_\_\_\_\_ HAND DUG \_\_\_\_\_  
\_\_\_\_\_ OTHER (specify) \_\_\_\_\_

\* USE CODE:

DOMESTIC \_\_\_\_\_ MUNICIPAL/PUBLIC \_\_\_\_\_  
\_\_\_\_\_ IRRIGATION \_\_\_\_\_ INDUSTRIAL \_\_\_\_\_  
\_\_\_\_\_ TEST/OBSERVATION \_\_\_\_\_ GEOTHERMAL \_\_\_\_\_

\* TYPE OF CASING:

STEEL \_\_\_\_\_ PLASTIC \_\_\_\_\_  
\_\_\_\_\_ CONCRETE \_\_\_\_\_ OTHER (specify) \_\_\_\_\_

SIZE OF CASING: 6 INCHES IN DIAMETER

DEPTH OF WELL: 80 FEET DEEP

WAS ANY CASING REMOVED? YES NO

If yes, length removed, in feet: \_\_\_\_\_

WAS CASING RIPPED OR PERFORATED? YES NO

SIGNATURE-MASTER WELL DRILLER OR SUPERVISING SANITARIAN LICENSE#

224

MWD / MSD / MGS

CIRCLE ONE

7-7-16

DATE

COUNTY

Pursuant to § 10-624 of the State Govt. Article of the Maryland Code, personal info requested on this form is used in processing this form pursuant to COMAR 26.04.04. Failure to provide the info may result in this form not being processed. You have the right to inspect, amend, or correct this form. The Maryland Department of the Environment is subject to the Maryland Public Information Act. This form may be made available on the Internet via MDE's website and is subject to inspection or copying, in whole or in part, by the public and other governmental agencies, if not protected by federal or State Law.