

MARYLAND DEPARTMENT OF THE ENVIRONMENT, WATER MANAGEMENT ADMINISTRATION
1800 Washington Blvd., Baltimore, Maryland 21230 (410) 537-3784

WATER WELL ABANDONMENT-SEALING REPORT FORM

SUBMIT COPIES OF COMPLETED FORM TO:

- * COUNTY ENVIRONMENTAL AGENCY (contact MDE, WMA if address needed)
- * WELL OWNER
- * MDE, WATER MANAGEMENT ADMINISTRATION, WELL PROGRAM

DATE WELL ABANDONED: 8-9-2016 (month/day/year)

* PERMIT NUMBER OF ABANDONED WELL (if any)

* PERMIT NUMBER OF REPLACEMENT WELL:


* PERSON ABANDONING WELL: Joseph R. Mayne WELL DRILLER'S LICENSE NUMBER: MSD024

CIRCLE: MWD / MSD / MGD

* OWNER'S NAME: Stef R. and Barbara A. Malicki

SITE LOCATION MAP

* WELL LOCATION:
COUNTY: Howard
NEAREST TOWN: Sykesville
TAX MAP BLOCK PARCEL
SUBDIVISION:
SECTION: LOT:
STREET ADDRESS: 644 Sideling Ct

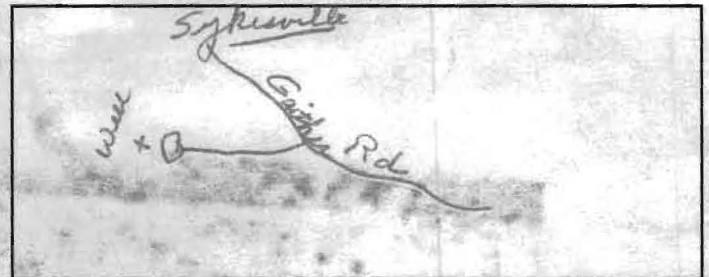

LATITUDE 3 9.35594

LONGITUDE 7 6.99498

LOG OF SEALING MATERIAL

MATERIAL	FEET	
	FROM	TO
<u>Gravel + cement mixed</u>	<u>0</u>	<u>180</u>

* TYPE OF WELL BEING ABANDONED:

 DRILLED JETTED
 BORED HAND DUG
 OTHER (specify)

* USE CODE:

 DOMESTIC MUNICIPAL/PUBLIC
 IRRIGATION INDUSTRIAL
 TEST/OBSERVATION GEOTHERMAL

* TYPE OF CASING:

 STEEL PLASTIC
 CONCRETE OTHER (specify)

VOLUME OF MATERIAL USED

18 bags cement 500 lbs gravel
1692 lbs cement

SIZE OF CASING: 6 INCHES IN DIAMETER

DEPTH OF WELL: 180 FEET DEEP

VAS ANY CASING REMOVED? ✓ YES NO

If yes, length removed, in feet: 2'

VAS CASING RIPPED OR PERFORATED? YES ✓ NO

Pursuant to § 10-624 of the State Govt. Article of the Maryland Code, personal info requested on this form is used in processing this form pursuant to COMAR 26.04.04. Failure to provide the info may result in this form not being processed. You have the right to inspect, amend, or correct this form. The Maryland Department of the Environment is subject to the Maryland Public Information Act. This form may be made available on the Internet via MDE's website and is subject to inspection or copying, in whole or in part, by the public and other governmental agencies, if not protected by federal or State Law.

SIGNATURE MASTER WELL DRILLER OR SUPERVISING SANITARIAN Joseph R. Mayne LICENSE# MSD024

MWD / MSD / MGS

CIRCLE ONE

DATE 8-10-2016

COUNTY