

MARYLAND DEPARTMENT OF THE ENVIRONMENT, WATER MANAGEMENT ADMINISTRATION
1800 Washington Blvd., Baltimore, Maryland 21230 (410) 537-3784

WATER WELL ABANDONMENT-SEALING REPORT FORM

SUBMIT COPIES OF COMPLETED FORM TO:

- * COUNTY ENVIRONMENT AGENCY (contact MDE, WMA if address needed)
- * WELL OWNER
- * MDE, WATER MANAGEMENT ADMINISTRATION, WELL PROGRAM

DATE WELL ABANDONED: 8/23/10 (month/day/year)

* PERMIT NUMBER OF ABANDONED WELL (if any)

* PERMIT NUMBER OF REPLACEMENT WELL

* PERSON ABANDONING WELL: Jason Miller


WELL DRILLERS LICENSE NUMBER: MGD 110

CIRCLE: MWD/MSD/MGD

* OWNER'S NAME: South Side Oil, LLC

SITE LOCATION MAP

* WELL LOCATION:
COUNTY: Howard MD
NEAREST TOWN: Elkridge MD
TAX MAP 37 BLOCK PARCEL 687
SUBDIVISION:
SECTION: LOT: A8
NEAREST ROAD: 6070 W. Marshalee Dr.

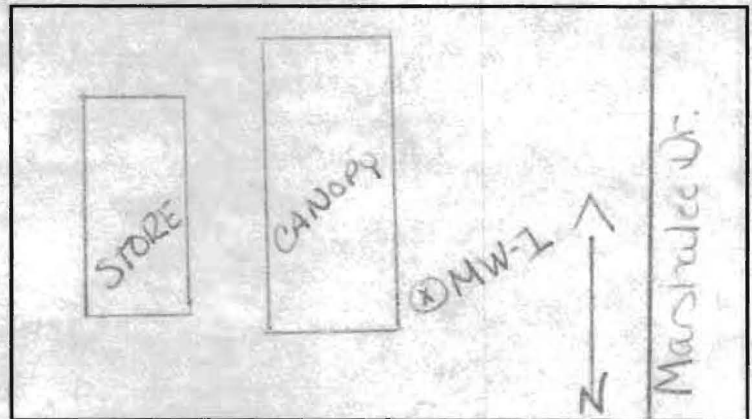

* TYPE OF WELL BEING ABANDONED:

 DRILLED JETTED
X BORED/AUGERED HAND DUG
 OTHER (specify)

* USE CODE:

 DOMESTIC MUNICIPAL/PUBLIC
 IRRIGATION INDUSTRIAL
X TEST/OBSERVATION GEOTHERMAL

* TYPE OF CASING:

 STEEL X PLASTIC
 CONCRETE OTHER (specify)

* SIZE OF CASING: 2 INCHES IN DIAMETER

* DEPTH OF WELL: 29 FEET DEEP

* WAS ANY CASING REMOVED? YES X NO
if yes, length removed, in feet:

* WAS CASING RIPPED OR PERFORATED? YES X NO

LOG OF SEALING MATERIAL

MATERIAL	FEET	
	FROM	TO
Cement Bentonite/ grout	0	29
VOLUME OF MATERIAL USED		
1.45 cu. ft.		

SIGNATURE-MASTER WELL DRILLER OR SUPERVISING SANITARIAN

LICENSE #

MWD/MSD/MGD

CIRCLE ONE

DATE

DENV 828 JULY 1997

2) COUNTY ENVIRONMENTAL AGENCY