

MARYLAND DEPARTMENT OF THE ENVIRONMENT, WATER MANAGEMENT ADMINISTRATION
2500 BROENING HIGHWAY, BALTIMORE, MARYLAND 21224, (410) 631-3784

WATER WELL ABANDONMENT-SEALING REPORT FORM

SUBMIT COPIES OF COMPLETED FORM TO:

- * COUNTY ENVIRONMENT AGENCY (contact MDE, WMA if address needed)
- * WELL OWNER
- * MDE, WATER MANAGEMENT ADMINISTRATION, WELL PROGRAM

DATE WELL ABANDONED: 02-23-07 (month/day/year)

* PERMIT NUMBER OF ABANDONED WELL (if any)

* PERMIT NUMBER OF REPLACEMENT WELL

* PERSON ABANDONING WELL: R. Sues

* OWNER'S NAME: Howard County

* WELL LOCATION:

COUNTY: HOWARD County
NEAREST TOWN: SYKESVILLE
TAX MAP 4 BLOCK 15 PARCEL 42
SUBDIVISION: N/A
SECTION: N/A LOT: N/A

MARYLAND GRID COORDINATES

E 800
BOX NUMBER
N 550

* TYPE OF WELL BEING ABANDONED:

☒ DRILLED ☐ JETTED
☐ BORED/AUGURED ☐ HAND DUG
☐ OTHER (specify) _____

* USE CODE:

☐ DOMESTIC ☐ MUNICIPAL/PUBLIC
☐ IRRIGATION ☐ INDUSTRIAL
☒ TEST/OBSERVATION

* TYPE OF CASING:

☐ STEEL ☒ PLASTIC
☐ CONCRETE ☐ OTHER (specify) _____

* SIZE OF CASING: 4 INCHES IN DIAMETER

* DEPTH OF WELL: 15 FEET DEEP

* WAS ANY CASING REMOVED? ☒ YES ☐ NO
if yes, length removed, in feet: 5 feet

* WAS CASING RIPPED OR PERFORATED? ☒ YES ☐ NO

SIGNATURE-MASTER WELL DRILLER OR SUPERVISING SANITARIAN

028
LICENSE #

MWD (MSD) MGD
CIRCLE ONE


2-23-07
DATE

DENV 828

JULY 1993

H 0 - 8 8 - 2 2 2 0

WELL DRILLERS LICENSE NUMBER: 028
CIRCLE: MWD/MSR/MGD

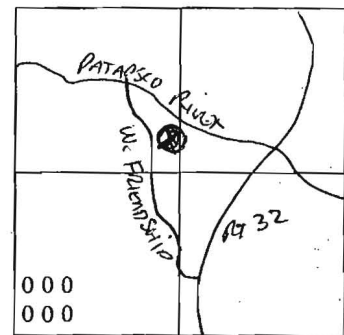

SHOW WELL LOCATION
BY X WITHIN BOX

LOG OF SEALING MATERIAL

MATERIAL	FEET	
	FROM	TO
4 bags (90 lbs/ Portland cement w/10% bentonite	20 feet	