

MARYLAND DEPARTMENT OF THE ENVIRONMENT, WATER MANAGEMENT ADMINISTRATION

1800 Washington Blvd., Baltimore, Maryland 21230 (410) 537-3784

WATER WELL ABANDONMENT-SEALING REPORT FORM

SUBMIT COPIES OF COMPLETED FORM TO:

- * COUNTY ENVIRONMENT AGENCY (contact MDE, WMA if address needed)
- * WELL OWNER
- * MDE, WATER MANAGEMENT ADMINISTRATION, WELL PROGRAM

DATE WELL ABANDONED: 10/21/10 (month/day/year)

OK
9/14/16 SC

* PERMIT NUMBER OF ABANDONED WELL (if any) _____

* PERMIT NUMBER OF REPLACEMENT WELL _____

* PERSON ABANDONING WELL: Marshall H. Harte


WELL DRILLERS LICENSE NUMBER: 106

CIRCLE: MWD/MSD/MGD

* OWNER'S NAME: Fred Reel

SITE LOCATION MAP

* WELL LOCATION:
COUNTY: Hawkins
NEAREST TOWN: Elkridge
TAX MAP 43 BLOCK 4 PARCEL 33
SUBDIVISION: Elkridge
SECTION: _____ LOT: _____
NEAREST ROAD: 1561 Washington Blvd

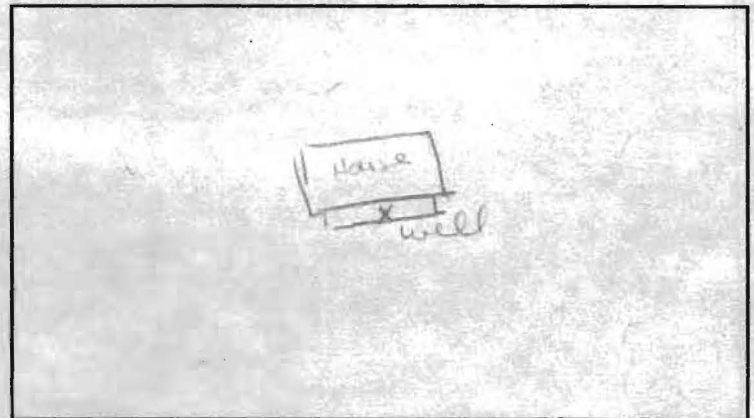

* TYPE OF WELL BEING ABANDONED:

_____ DRILLED _____ JETTED
_____ BORED/AUGERED ☒ HAND DUG
_____ OTHER (specify) _____

* USE CODE:

☒ DOMESTIC _____ MUNICIPAL/PUBLIC
_____ IRRIGATION _____ INDUSTRIAL
_____ TEST/OBSERVATION _____ GEOTHERMAL

* TYPE OF CASING:

☒ STEEL _____ PLASTIC
☒ CONCRETE _____ OTHER (specify) _____

* SIZE OF CASING: 36 INCHES IN DIAMETER

* DEPTH OF WELL: 30 FEET DEEP

* WAS ANY CASING REMOVED? 1 YES _____ NO
if yes, length removed, in feet: 3

* WAS CASING RIPPED OR PERFORATED? _____ YES _____ NO

LOG OF SEALING MATERIAL

MATERIAL	FEET	
	FROM	TO
Clean Fill	30	6
Portland Cement	6	3
Clean Fill	3	1
Cement	1	0
VOLUME OF MATERIAL USED		
1 yd tons		

SIGNATURE-MASTER WELL DRILLER OR SUPERVISING SANITARIAN

LICENSE #

MWD/MSD/MGD 11-4-10

DATE

DENV 828 JULY 1997

2) COUNTY ENVIRONMENTAL AGENCY