

WATER WELL ABANDONMENT-SEALING REPORT FORM

SUBMIT COPIES OF COMPLETED FORM TO:

- * COUNTY ENVIRONMENT AGENCY (contact MDE, WMA if address needed)
- * WELL OWNER
- * MDE, WATER MANAGEMENT ADMINISTRATION, WELL PROGRAM

DATE WELL ABANDONED: 02-22-07 (month/day/year)

* PERMIT NUMBER OF ABANDONED WELL (if any)

* PERMIT NUMBER OF REPLACEMENT WELL

* PERSON ABANDONING WELL: R SIES SR

WELL DRILLERS LICENSE NUMBER: 028

* OWNER'S NAME: HOWARD COMM


CIRCLE: MWD/MSD/MGD

* WELL LOCATION:

COUNTY: HOWARD
NEAREST TOWN: SYKESVILLE
TAX MAP 4 BLOCK — PARCEL 42
SUBDIVISION: N/A
SECTION: N/A LOT: N/A

MARYLAND GRID COORDINATES

BOX NUMBER
E 800
N 550

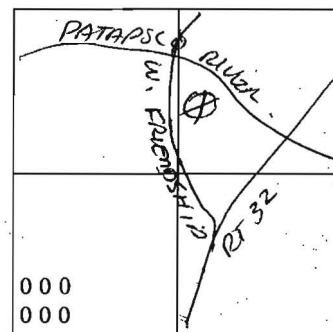

SHOW WELL LOCATION
BY X WITHIN BOX

* TYPE OF WELL BEING ABANDONED:

☒ DRILLED ☐ JETTED
☐ BORED/AUGURED ☐ HAND DUG
☐ OTHER (specify) _____

* USE CODE:

☐ DOMESTIC ☐ MUNICIPAL/PUBLIC
☐ IRRIGATION ☐ INDUSTRIAL
☐ TEST/OBSERVATION

* TYPE OF CASING:

☒ STEEL ☐ PLASTIC
☐ CONCRETE ☐ OTHER (specify) _____

* SIZE OF CASING: 6 INCHES IN DIAMETER

* DEPTH OF WELL: 160 FEET DEEP

* WAS ANY CASING REMOVED? ☐ YES ☐ NO
if yes, length removed, in feet: _____

* WAS CASING RIPPED OR PERFORATED? ☐ YES ☐ NO OPEN HOLE

LOG OF SEALING MATERIAL

MATERIAL	FEET	
	FROM	TO
26 bags (90 lbs) of Portland cement	160 Feet	

SIGNATURE-MASTER WELL DRILLER OR SUPERVISING SANITARIAN
Richard D. Sies Sr

LICENSE # 028

CIRCLE ONE MWD/MSD/MGD

DATE 2-22-07