

10/16/86
10/17/86
11AM

10/17/86
agreed
S. Abel

PERMIT

P 37P30
A 36699

SEWAGE DISPOSAL SYSTEM

MARYLAND STATE DEPARTMENT OF HEALTH

HOWARD COUNTY
BUREAU OF ENVIRONMENTAL HEALTH
~~XXXXXX~~
461-9933

INDEXED

ELLICOTT CITY
DISTRICT 3rd
DATE 10/09/86

Arnold Backhoe & Septic Services, Inc. IS PERMITTED TO INSTALL X ALTER

ADDRESS P. O. Box 15, Woodbine, Maryland 21797 PHONE 795-7873

SUBDIVISION Boswell Property ROAD 11765 ~~Route 99~~ Old Frederick Road LOT 10

PROPERTY OWNER ~~Mike Palencar~~ DONALD MOOCK

ADDRESS _____

IF GARBAGE GRINDER IS USED INCREASE SEPTIC TANK CAPACITY BY 50% AND ABSORPTION AREA BY 22%.

GARBAGE GRINDER? YES _____ NO X

SEPTIC TANK CAPACITY 1000 GALLONS NUMBER OF BEDROOMS 3

TRENCHES - 200 sq. ft. per bedroom. Trench to be 2 feet wide. Inlet 5 feet below original grade. Bottom maximum depth 10 feet below original grade. Effective area begins at 5 feet below original grade. 5 feet of stone below distribution pipe.

LOCATION - Place the distribution box 70 feet from the rear (492') lot line and 150 feet from the left (782') lot line. Run trench(s) along contour toward rear lot line.

NOTE - No trench to exceed 100 feet in length. If more than one trench used, a distribution box is required. Call for inspection of trench before and after gravel is installed. Provide 6" - 8" diameter cleanout and cap to grade or above on septic tank. OK/CW

OLD RECORDS
AND RETURNED 6/21/2000
B00124966
INGROUND POOL W/ DECK + FENCE

PLANS APPROVED BY C. Williams DATE 8/09/86

COVER NO WORK UNTIL INSPECTED AND APPROVED.

NEITHER THE HOWARD COUNTY COUNCIL NOR THE HEALTH DEPARTMENT IS RESPONSIBLE FOR THE SUCCESSFUL OPERATION OF ANY SYSTEM.

NOTE: IF TRENCH IS USED CALL FOR INSPECTION BEFORE AND AFTER PLACING GRAVEL IN TRENCH.

NOTE: NO DRY WELL SHALL EXCEED 15 FOOT IN DIAMETER. NO ABSORPTION TRENCH TO EXCEED 100 FEET IN LENGTH.

NOTE: ALL PIPE FROM HOUSE TO SEPTIC TANK MUST BE CAST IRON OR SCHEDULE 40 PVC OR ABS.

PERMIT VOID AFTER THREE YEARS.


NOTE: INSTALL STAND PIPE ON SEPTIC TANK AND DRY WELL. STAND PIPES MUST BE 6 INCHES IN DIAMETER. CAST IRON, CONCRETE OR TERRA COTTA, OR PVC OR ABS ACCEPTED. IF TOP OF SEPTIC TANK IS DEEPER THAN 3 FEET MANHOLE TO GRADE REQUIRED.

***INSTALLER IS RESPONSIBLE FOR OBTAINING FINAL APROVAL ON THIS PERMIT**

*CALL 992-2330 FOR INSPECTION OF SEPTIC SYSTEMS.

EH - 2-1082

A 36699

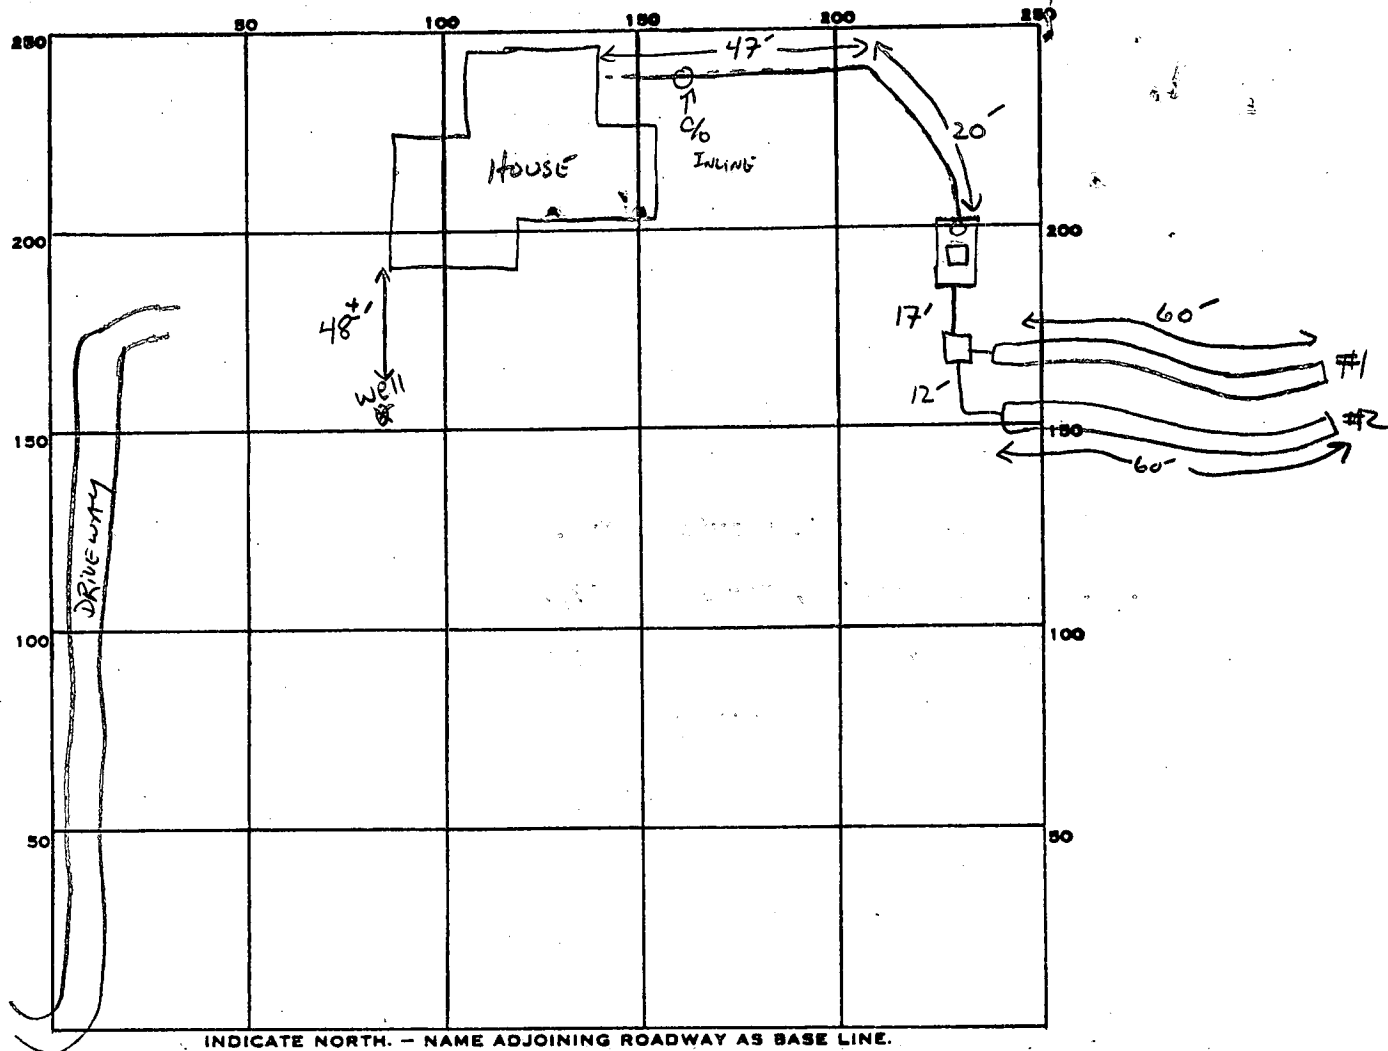

PERMIT CARD ☒

SEPTIC TANK, LEVEL ☒ 1000 GAL

MANHOLE CLEANOUTS ☒ + C/O ST C/O INLINE

DISTRIBUTION BOX, LEVEL ☒

TILE FIELD, DEPTH 10 FT. TRENCH WIDTH 2 FT. INLETS

GRAVEL DEPTH 5 FT. TOTAL LENGTH 100 - 60 FT. TOTAL 120

NUMBER OF TRENCHES 2 ONE SIDE WALL TOTAL BOTTOM AREA 600 SQ. FT.

SEEPAGE PITS, INSIDE DIAMETER — FT. DEPTH BELOW INLET — FT.

ABSORBENT AREA 600 SQ. FT.

REMARKS 10/16/86 OK TO ADD STONE TO #1 - DO NOT DO OR TO ADD STONE IF INSPECTOR RUNNING LATE. S. Abel

DATE SYSTEM APPROVED 10-17-86 INSPECTOR S. Abel

10/29/86
36699
NO 81-1430 Bowers Lot 10
Bowers Lot 10

APPLICATION FOR PITLESS ADAPTER, WELL PUMP AND PRESSURE TANK INSTALLATION

Howard County Health Department
Bureau of Environmental Health
3525-H Ellicott Mills Drive
Court House Square
Ellicott City, Md. 21043
461-9933

New Installation _____ Receipt # _____
Replacement _____ Date _____

Name of Installer D.R. BOUNDS Telephone _____

License number _____
Certified Well Pump Installer _____ Well Driller _____ Registered Plumber _____

Name of Property Owner _____ Telephone _____

Subdivision _____ Lot # _____ Well tag # _____

Site Address 11765 ROUTE 99
(WEST OF MARIOTTVILLE RD - WOODEN SIGN, DRIVEWAY TO LOG CABIN)

Pump
1. Type
a. Deep well jet _____
b. Shallow well jet _____
c. Submersible _____
2. Make _____
3. Model # _____
4. Capacity _____ GPM
5. Pump exceeds well capacity Yes _____ No _____
6. If Yes, is low pressure cutoff switch installed? Yes _____ No _____
7. What methods are used to protect the pump and electrical wiring from vibrations? Torque arrestors _____ Cable guards _____ Other _____

Motor
1. Horsepower _____
2. RPM _____
3. Voltage _____
a. 110 _____
b. 220 _____

Pitless Adapter
1. Make _____
2. Model # _____
3. Depth _____

Tank
1. Capacity _____
2. Pressure relief valve? _____

Piping
1. Type _____
2. Size _____
3. NSF and/or BOCA Code approved _____
4. Depth of supply line _____

Well data
1. Depth _____ ft.
2. Yield _____ GPM
3. Static water level _____ ft.
4. Will water supply be disinfected by installer? _____

10/29/86 - Pitless & lines 4 ft below grade J.S.

I understand that it is my responsibility to notify the Howard County Health Department when the installation is ready for inspection (otherwise this permit is null and void).

All information given above is true to the best of my knowledge.

Signature of Applicant: _____

Date: _____

Note: A sticker indicating approval/status of the installation will be placed on the well casing at the time of the inspection.

C1 00486 SEQUENCE NO. (OEP USE ONLY)

STATE OF MARYLAND
WELL COMPLETION REPORT
FILL IN THIS FORM COMPLETELY
PLEASE PRINT OR TYPETHIS REPORT MUST BE SUBMITTED WITHIN
45 DAYS AFTER WELL IS COMPLETED.COUNTY R-36699
NUMBER

DATE Received

8	9	10	11	12	13
---	---	----	----	----	----

DATE WELL COMPLETED

15	16	17	18	19	20
----	----	----	----	----	----

Depth of Well

22	23	24	25	26
----	----	----	----	----

(TO NEAREST FOOT)

PERMIT NO.
FROM "PERMIT TO DRILL WELL"

28	29	30	31	32	33	34	35	36	37
----	----	----	----	----	----	----	----	----	----

OWNER DALENCAR MIKE
STREET OR RFD last name first name TOWN WOODSTOCK
SUBDIVISION SECTION LOT 10

WELL LOG

Not required for driven wells

STATE THE KIND OF FORMATIONS
PENETRATED, THEIR COLOR, DEPTH,
THICKNESS AND IF WATER BEARING

DESCRIPTION (Use additional sheets if needed)

FEET

FROM TO

Check if water bearing

OVERBURDEN

0 6

BROWN SHALE

6 58

GRANITE

58 300

HOLE 1 (300' DRY) BACK FILLED

HOLE 2 (100' DRY) BACK FILLED

GROUTING RECORD

WELL HAS BEEN GROUTED
(Circle Appropriate Box)

yes	no
☒ Y	☐ N

TYPE OF GROUTING MATERIAL

CEMENT ☒ CM BENTONITE CLAY ☒ BC

NO. OF BAGS 12 NO. OF POUNDS 1200

GALLONS OF WATER 72

DEPTH OF GROUT SEAL (to nearest foot)

from 0 ft. to 0 ft.
(enter 0 if from surface)

CASING RECORD

casing types
insert appropriate code below

☒ ST	☒ CO
STEEL	CONCRETE
☐ PL	☐ OT
PLASTIC	OTHER

MAIN CASING TYPE Nominal diameter top (main) casing (nearest inch) Total depth of main casing (nearest foot)

☒ ST	☐ G	☐ G	☐	☐	☐
--	----------------------------	----------------------------	--------------------------	--------------------------	--------------------------

OTHER CASING (if used)

diameter inch depth (feet) from to

EACH CASING									
-------------	--	--	--	--	--	--	--	--	--

screen type or open hole
insert appropriate code below

SCREEN RECORD

☒ ST	☒ BR	☒ HO
STEEL	BRASS	OPEN HOLE
☐ PL	☐ OT	☐
PLASTIC	OTHER	

C2

1	2	3	4	5	6	7	8	9	10	11	12	13	14	15	16	17	18	19	20	21			
H		O		6		0		1		3		0		0									
8		9		11		15		17		21		23		24		26		30		32		36	
38		39		41		45		47		51													

SLOT SIZE 1 2 3

DIAMETER OF SCREEN (NEAREST INCH)

from to

GRAVEL PACK IF WELL DRILLED WAS FLOWING WELL INSERT F IN BOX 68

OEP USE ONLY (NOT TO BE FILLED IN BY DRILLER)

T	(E.R.O.S.)	WQ
☐ 70	☐ 72	☐ 74 ☐ 75 ☐ 76
TELESCOPE CASING	LOG INDICATOR	OTHER DATA

C3

PUMPING TEST

HOURS PUMPED (nearest hour) 6
PUMPING RATE (gal. per min. to nearest gal.) 143

METHOD USED TO MEASURE PUMPING RATE SUBMERSIBLE

WATER LEVEL (distance from land surface)

BEFORE PUMPING 28

WHEN PUMPING 280

TYPE OF PUMP USED (for test)

☒ A	☐ P	☐ T
air	piston	turbine
☐ C	☐ R	☐ O
centrifugal	rotary	other (describe below)
☐ J	☒ S	
jet	submersible	

PUMP INSTALLED

DRILLER WILL INSTALL PUMP YES ☒ NO
(CIRCLE) (YES or NO)
IF DRILLER INSTALLS PUMP, THIS SECTION MUST BE COMPLETED FOR ALL WELLS EXCEPT HOME USE
TYPE OF PUMP INSTALLED
PLACE (A,C,J,P,R,S,T,O) IN BOX-SEE ABOVE:CAPACITY: GALLONS PER MINUTE (to nearest gallon) 31 35
PUMP HORSE POWER 37 41
PUMP COLUMN LENGTH (nearest ft.) 43 47CASING HEIGHT (circle appropriate box and enter casing height)
+ above } LAND SURFACE
- below } (nearest foot)LOCATION OF WELL ON LOT
SHOW PERMANENT STRUCTURE SUCH AS BUILDING, SEPTIC TANKS, AND/OR LANDMARKS AND INDICATE NOT LESS THAN TWO DISTANCES (MEASUREMENTS TO WELL)

NO MAP AVAILABLE

CIRCLE APPROPRIATE LETTER
A WELL WAS ABANDONED AND SEALED
WHEN THIS WELL WAS COMPLETED

E ELECTRIC LOG OBTAINED

P TEST WELL CONVERTED TO PRODUCTION WELL

I HEREBY CERTIFY THAT THIS WELL HAS BEEN CONSTRUCTED IN ACCORDANCE WITH COMAR 10.17.13 "WELL CONSTRUCTION" AND IN CONFORMANCE WITH ALL CONDITIONS STATED IN THE ABOVE CAPTIONED PERMIT, AND THAT THE INFORMATION PRESENTED HEREIN IS ACCURATE AND COMPLETE TO THE BEST OF MY KNOWLEDGE.

DRILLERS IDENT. NO. 120

DRILLERS SIGNATURE (MUST MATCH SIGNATURE ON APPLICATION)

SITE SUPERVISOR (sign. of driller or journeyman responsible for sitework if different from permittee)

Page 1 of 2
Date 6/4/86

Review _____

FIELD DATA SHEET
HOWARD COUNTY WELL YIELD TEST

Well Permit No. HO - 81 - 1430
Location of property (road) RT 99
Subdivision _____ Lot 10 Block _____ Plat _____ Sec. _____
Well Driller Edgar Harr Owner Mike Dalemear

Depth of well 300'
Distance of measuring point (M.P.) above ground 30"
Static water level (S.W.L.) below M.P. 28'6"

I. High rate pumping -- reservoir drawdown

Time pump started 0815 Pumping rate 14.29
Total time 45 to reach pumping water level 280 ft. below M.P.

II. Recovery pump test data - observations to be recorded every 15 minutes

TIME (in 15 minute intervals)	WATER LEVEL below M.P.	PUMPING RATE time to fill 5 gallon bucket	FLOW METER READING (if used)	CALCULATED FLOW (gallons per minute)
0830	141'	25		12.0
0845	244'	30		10.0
0900	280'	55	1 GAL	1.09
0915	276'6"	55	1 GAL	1.09
0930	278'6"	38	1 GAL	1.58
0945	277'8"	47	1 GAL	1.28
1000	276'6"	47	1 GAL	1.28
1015	275'6"	47	1 GAL	1.28
1030	276'2"	44	1 GAL	1.36
1045	275'8"	44	1 GAL	1.36
1100	275'5"	44	1 GAL	1.36
1115	276'3"	41	1 GAL	1.46
1130	276'11"	41	1 GAL	1.46
1145	277'6"	41	1 GAL	1.46
1200	278'	41	1 GAL	1.46
1215	278'6"	41	1 GAL	1.46
1230	278'10"	41	1 GAL	1.46
1245	279'2"	41	1 GAL	1.46
1300	279'8"	41	1 GAL	1.46
1315	280'3"	41	1 GAL	1.46
1330	280'8"	41	1 GAL	1.46
1345	281'3"	41	1 GAL	1.46
1400	281'3"	42	1 GAL	1.43
1415	281'4"	42	1 GAL	1.43

6/5/80
8:10

Page _____ of _____
Date June 5, 1986

Review H 9735
JS

FIELD DATA SHEET
HOWARD COUNTY WELL YIELD TEST

Well Permit No. HO - 81 - 1430

Location of property (road) 11805 ROUTE 99

subdivision BOSWELL PROPERTY

Well Driller HARR

Lot	Block	Plat	Sec.
10			

Owner PALENCAR

Depth of well 300

Distance of measuring point (M.P.) above ground 22

Static water level (S.W.L.) below M.P. 28' 6"

1. High rate pumping -- reservoir drawdown

Time pump started 8:15


Pumping rate 3

Total time 45 min to reach pumping water level 280 ft. below M.P.

II. Recovery pump test data - observations to be recorded every 15 minutes

[illegible]


B 1 5804	SEQUENCE NO. (OEP USE ONLY)	STATE OF MARYLAND PERMIT TO DRILL WELL please print or type	OEP PERMIT NUMBER 70-81-1430
1 2 3 4 5 6 (THIS NUMBER IS TO BE PUNCHED IN CQLS. 3-6 ON ALL CARDS)		70 fill in this form completely 79	
Date Received 732866		B 3 LOCATION OF WELL	
OWNER INFORMATION DALENCAR MIKE		HOWARD	
2419 FOREST HILL DR		WOODSTOCK	
HARRIOTTSVILLE DR 1104		3 MI	
DRILLER INFORMATION Sandy B. Cochran		B 4 DIRECTION OF WELL FROM TOWN (CIRCLE BOX)	
G. EDGAR HARR SONS CORP.		11805 Route 99	
12047 Falls Rd Cockeysville 21030		100	
Sandy B. Cochran		3-21-86	
B 2 WELL INFORMATION		NOT TO BE FILLED IN BY DRILLER HEALTH DEPARTMENT APPROVAL	
APPROX. PUMPING RATE (GAL. PER MIN.) 5		COUNTY NAME HOWARD	
AVERAGE DAILY QUANTITY NEEDED (GAL. PER DAY) 750		COUNTY NO. R-36699	
USE FOR WATER (CIRCLE APPROPRIATE BOX)		OEP SIGNATURE J. Stenger	
☒ HOME (SINGLE OR DOUBLE HOUSEHOLD UNIT ONLY)		DATE ISSUED 04/8/86	
☐ FARMING (LIVESTOCK WATERING & AGRICULTURAL IRRIGATION)		CO SIGNATURE J. Stenger	
☐ INDUSTRIAL, COMMERCIAL, STATE AND FEDERAL GOV. OTHER (REQUIRES APPROPRIATION PERMIT)		EXP. DATE 10/18/86	
☐ PUBLIC OR PRIVATE WATER COMPANY (REQUIRES APPROPRIATION PERMIT AND STATE HEALTH DEPARTMENT APPROVAL)		NORTH GRID 570000	
☐ TEST, OBSERVATION, MONITORING (MAY REQUIRE APPROPRIATION PERMIT)		EAST GRID 0822000	
APPROXIMATE DEPTH OF WELL 200 FEET		SHOW MAJOR FEATURES OF BOX & LOCATE WELL WITH AN X	
APPROXIMATE DIAMETER OF WELL 6 INCH		SOURCES OF DRILLING WATER	
METHOD OF DRILLING (circle one)		WRITE THE BOX NUMBER FROM THE MAP HERE	
☒ BORED (or Augered)		8202	
☒ AIR-ROTARY		540	
☒ AIR-PERCUSION		DRAW A SKETCH BELOW SHOWING LOCATION OF WELL IN RELATION TO NEARBY TOWNS AND ROADS AND GIVE DISTANCE FROM WELL TO NEAREST ROAD JUNCTION	
☐ ROTARY (Hydraulic Rotary)		7/2/82	
☐ CABLE		WELL LOC	
☐ REVERSE-ROTARY		SEE OTHER	
☐ DRIVE POINT		SIDE Rk	
other _____		Route 99	
REPLACEMENT OR DEEPEMED WELLS (CIRCLE APPROPRIATE BOX)		Howard County HANDOFF	
☒ THIS WELL WILL NOT REPLACE AN EXISTING WELL		SAND HILL RD	
☐ THIS WELL WILL REPLACE A WELL THAT WILL BE ABANDONED AND SEALED		(X)	
☐ THIS WELL WILL REPLACE A WELL THAT WILL BE USED AS A STANDBY		N	
☐ THIS WELL WILL DEEPEN AN EXISTING WELL		PERMIT No. 70-81-1430	
PERMIT NUMBER OF WELL TO BE REPLACED OR DEEPEMED (IF AVAILABLE) 70-81-1430		SPECIAL CONDITIONS	
Not to be filled in by driller (OEP USE ONLY)		FORCE 7-5	
APPROP. PERMIT NUMBER GAP		WRITE INITIALS IN BOX	
SPECIAL CONDITIONS		HEALTH	

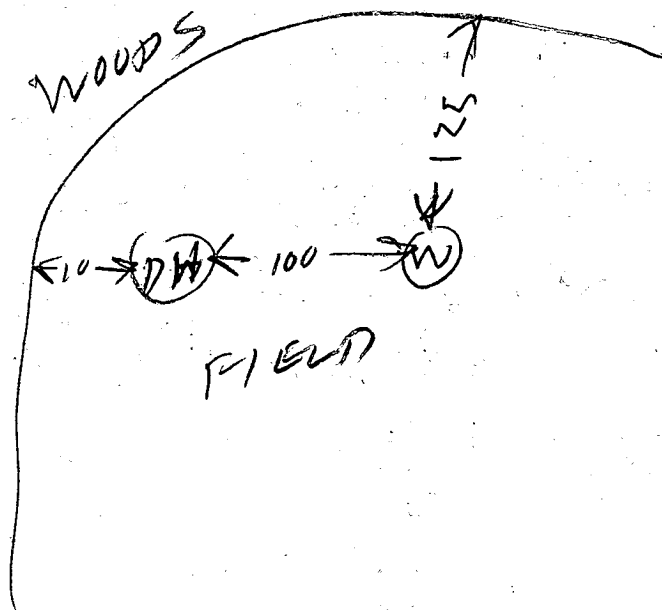

7/2/86
1023 AM

- ① 33 FT OPEN HOLE
- ② 60 FT CASING 3 FT OUT OF GROUND
- ③ ARRIVED EARLY WELL GROUVER LATE
- ④ 12 BAGS USED TODAY
- ⑤ DRY HOLE ALSO FILLED WITH 3 BAGS OF CEMENT
- ⑥ NOT ABSOLUTELY SURE ABOUT WELL LOCATION BUT PROBABLY OK

R. Hodges

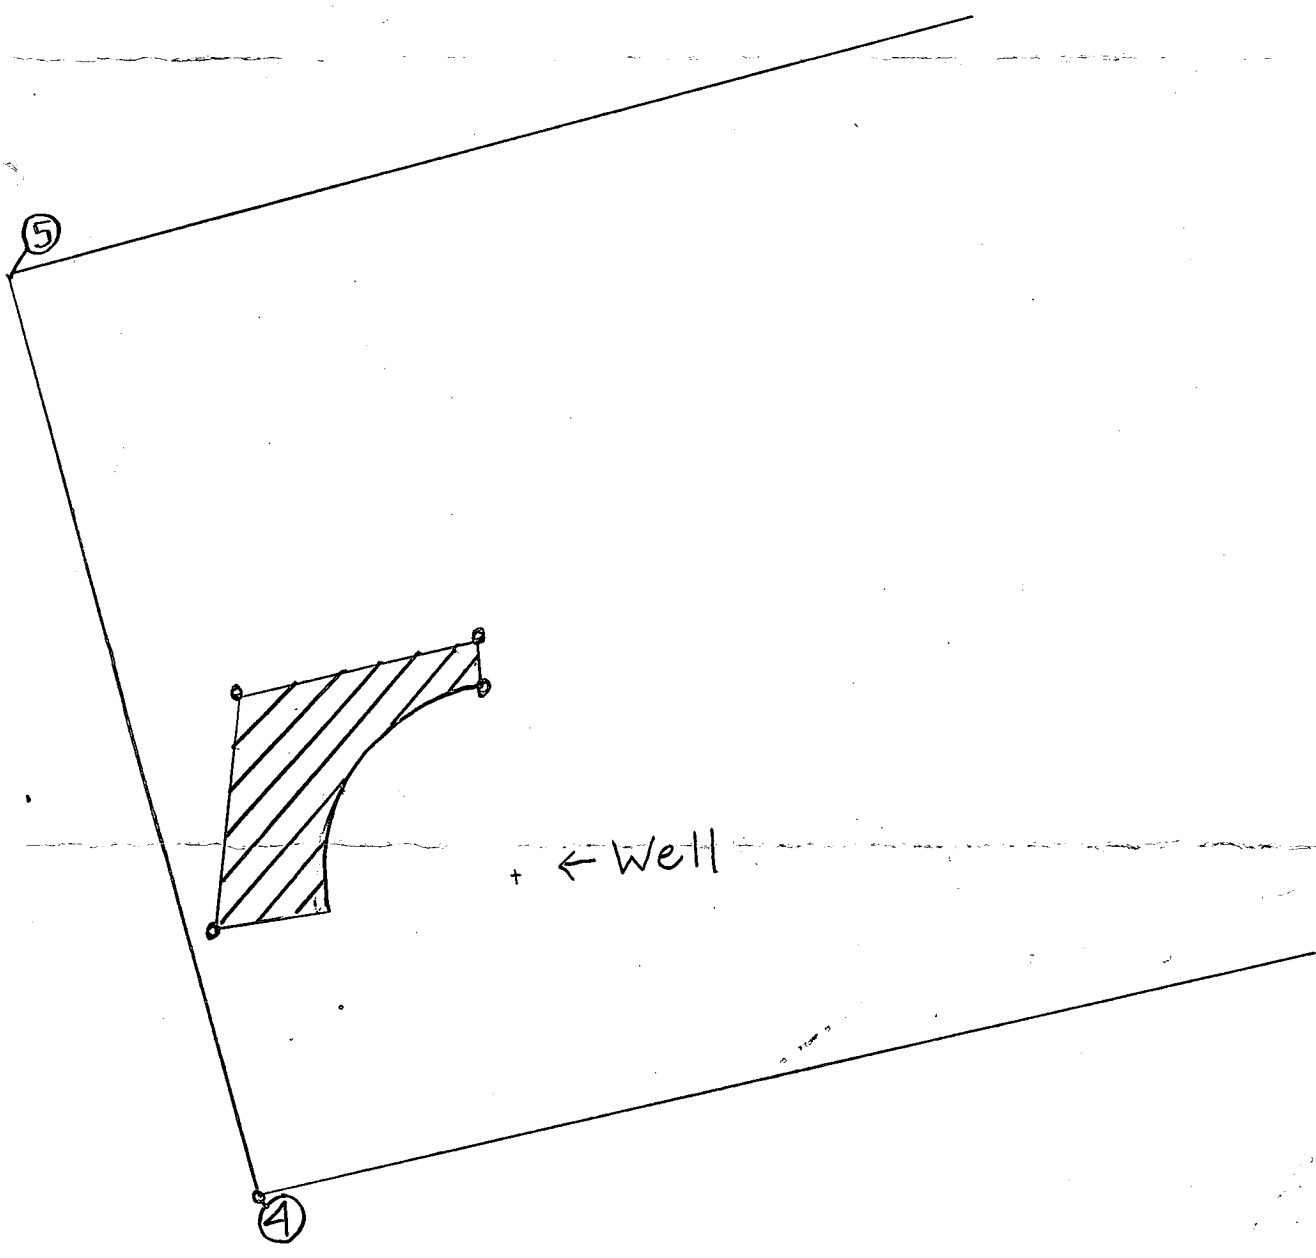

Modified Sewerage Easement
Liber 1041 Folio 188 Lot 10
Mike Palencar 7-16-86 Scale 1"=100'
11805 RT.99

COORDINATE SCHEDULE		
NO.	NORTH	EAST
1	541,786.876	822,055.121
2	541,836.061	822,407.300
3	541,863.720	822,521.673
4	540,085.714	822,411.589
5	540,097.153	821,919.289
6	540,092.914	821,949.086

CURVE DATA					
CURVE	RADIUS	LENGTH	Δ	TAN	CHO. BEARING & DIST.
1-2	1710.00	355.96	11° 55' 37"	178.63	N 82° 22' 08" E 355.33'

50' R/W RESERVATION FOR INGRESS AND EGRESS FOR LOTS 2, 8, 9, 10, 11, 12 AND 13 TO ALLOW FOR THE FUTURE TRANSFER FOR A PUBLIC STREET SHOULD AT ANY TIME LOTS 2, 8, 9, 10, 11, 12 OR 13 BE FURTHER SUBDIVIDED. AT SUCH TIME THE R/W WILL REVERT TO HOWARD COUNTY AND A PUBLIC ROAD WOULD BE REQUIRED IN ACCORDANCE WITH

SECT. 16.113 F.7 OF THE HOWARD COUNTY SUBDIVISION AND LAND DEVELOPMENT REGULATIONS

MATCH LINE - SEE SHEET 2 OF 2

N 08° 13' 25" E 804.23'

N 08° 13' 25" E 808.78'

N 08° 13' 25" E 330.00'

L=25.41'

L=35.99'

0 N 53° 13' 25" E 11.78'

PREVIOUSLY DEDICATED IN P.B. 5324

MO. RTE. 99

VEHICULAR INGRESS & EGRESS IS RESTRICTED TO ROAD 2

MO. RTE. 99

VEHICULAR INGRESS & EGRESS IS RESTRICTED TO ROAD 2

SAND HILL ROAD

HO. CO. CONTROL STA. 3620001-R

MO. RTE. 99


SHT. 1 OF 2

SHT. 2 OF 2

VICINITY MAP
SCALE 1"=1200'

GENERAL NOTES

- TAX MAP: 10, PART OF PARCEL: 22
- DEED REFERENCE: 1041/188
- COORDINATES SHOWN HEREON ARE BASED ON HOWARD COUNTY CONTROL STATIONS 3620001-R
- SUBJECT PROPERTY ZONED R, PER 10-3-77 COMPREHENSIVE ZONING PLAN
- THE LOTS SHOWN HEREON COMPLY WITH THE MINIMUM OWNERSHIP WIDTH AND LOT AREAS AS REQUIRED BY THE MARYLAND STATE DEPARTMENT OF HEALTH AND MENTAL HYGIENE
-  THIS AREA DESIGNATES A PRIVATE SEWAGE EASEMENT OF APPROXIMATELY 10,000 SQ. FT. AS REQUIRED BY THE MARYLAND STATE DEPARTMENT OF HEALTH AND MENTAL HYGIENE FOR INDIVIDUAL SEWAGE DISPOSAL IMPROVEMENTS OF ANY NATURE IN THIS

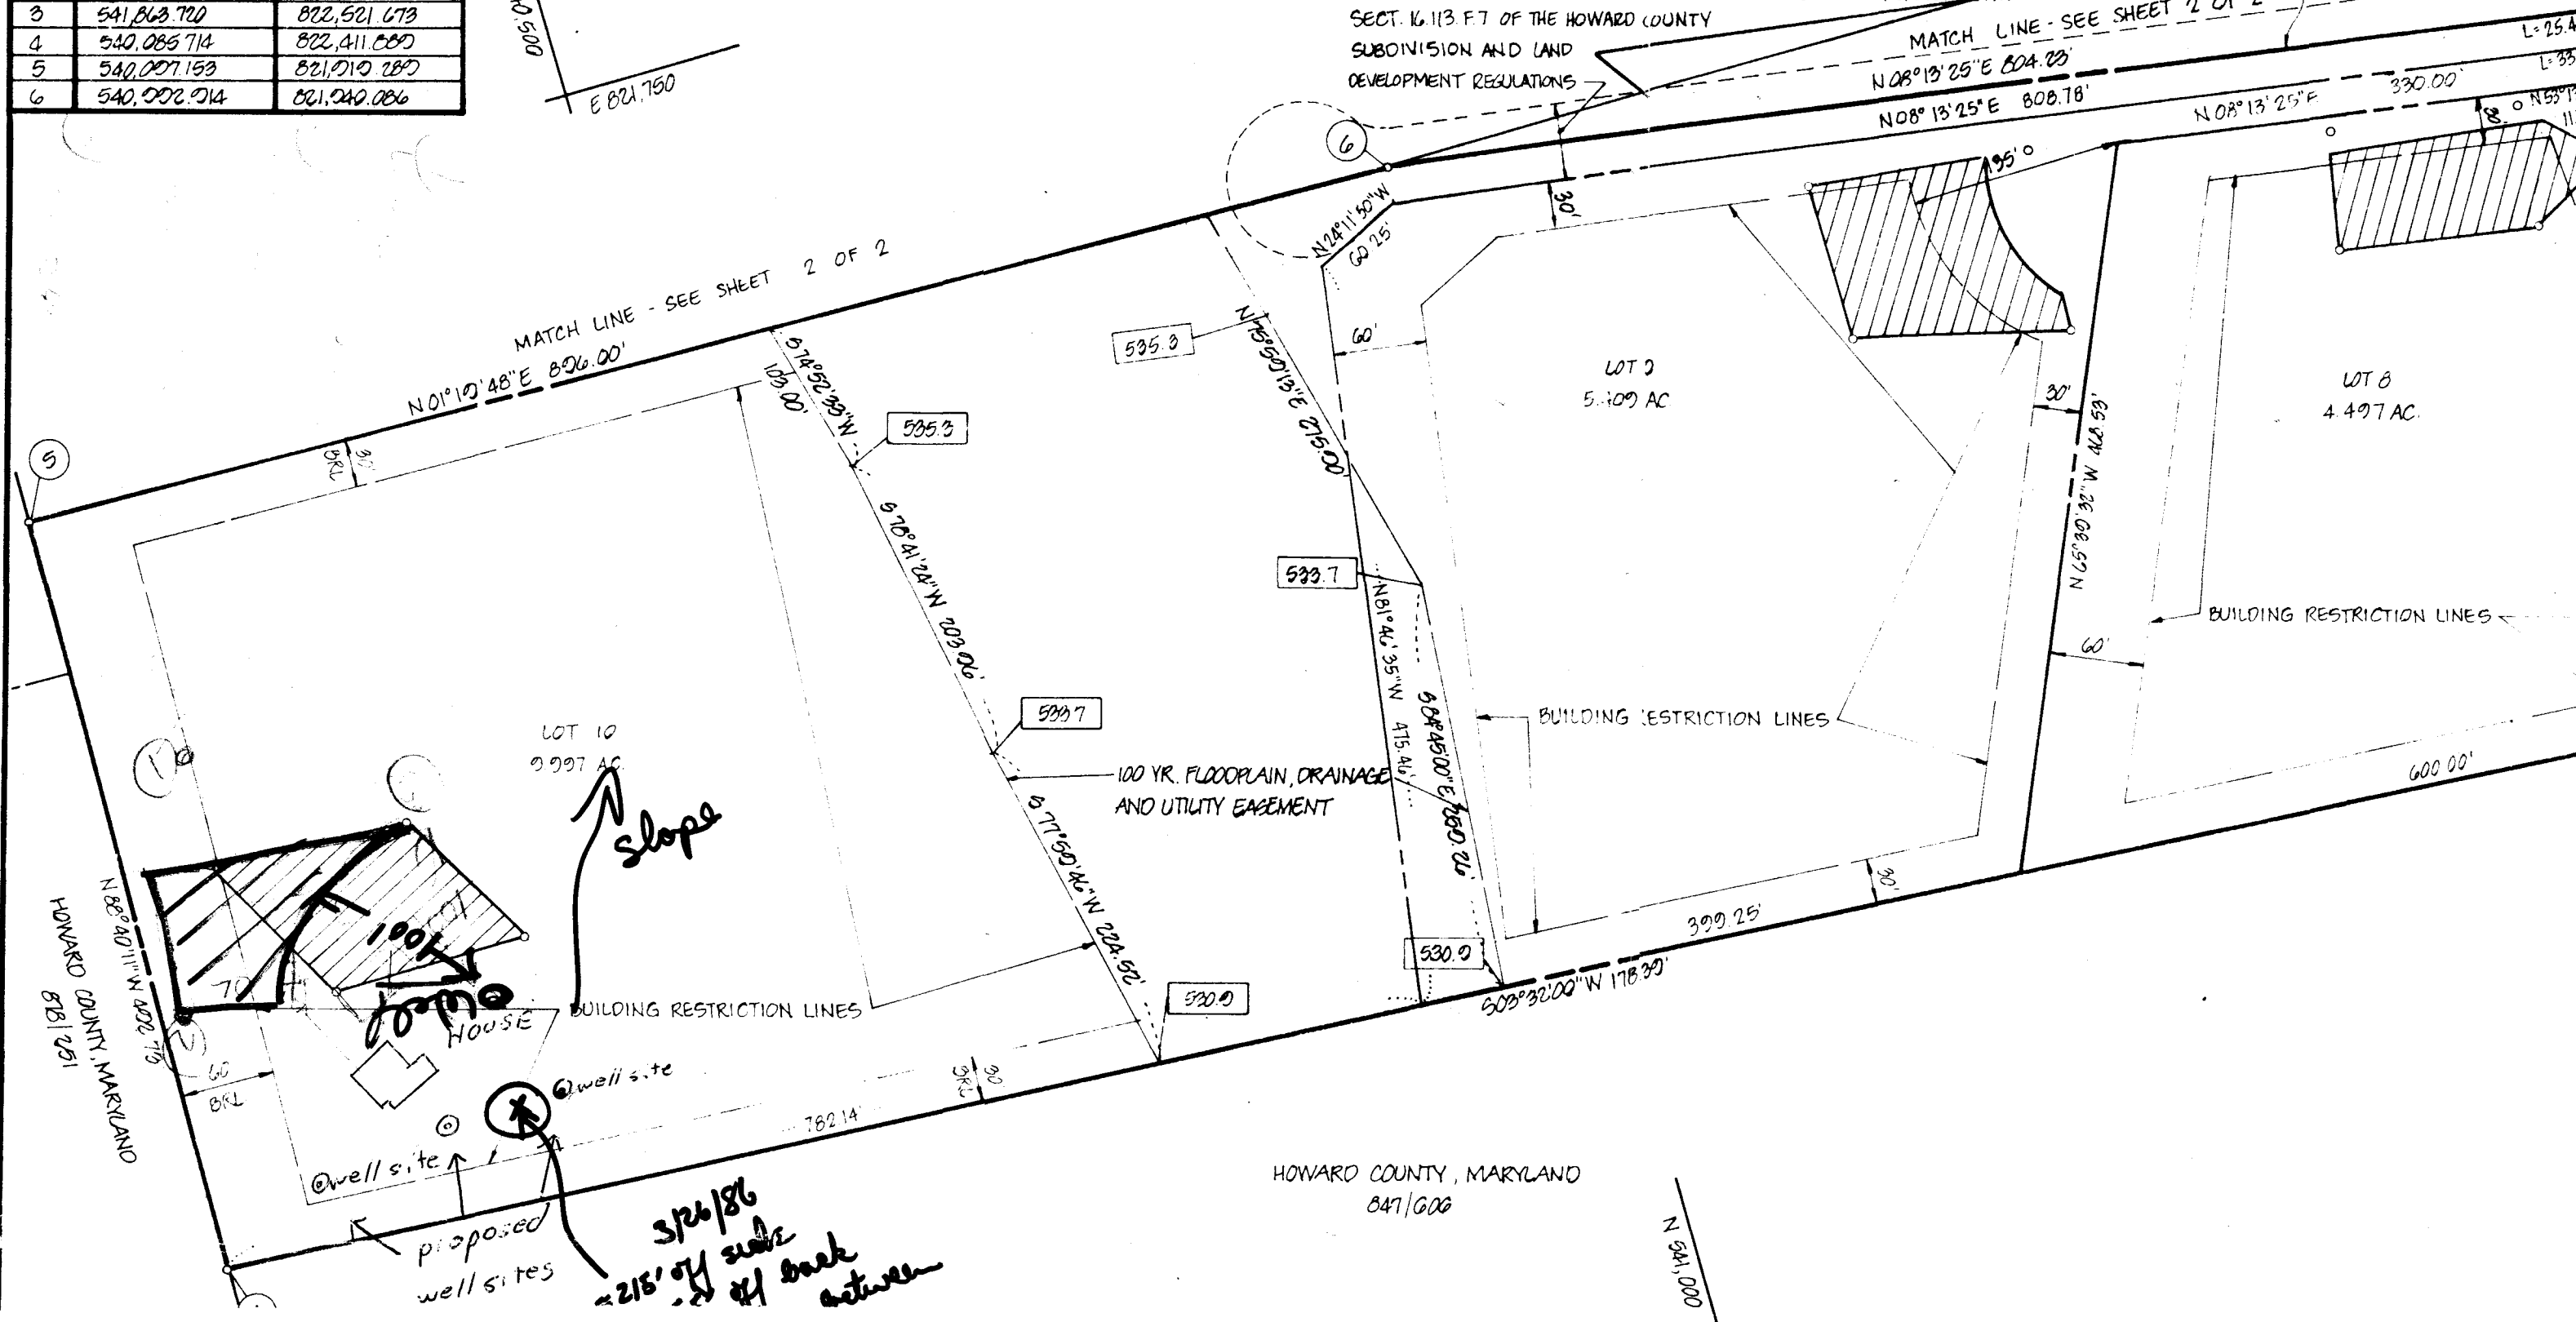


1"=200'

slope

3/26/86
215' of each
of each
between

HOWARD COUNTY, MARYLAND
847/606

N 341,000

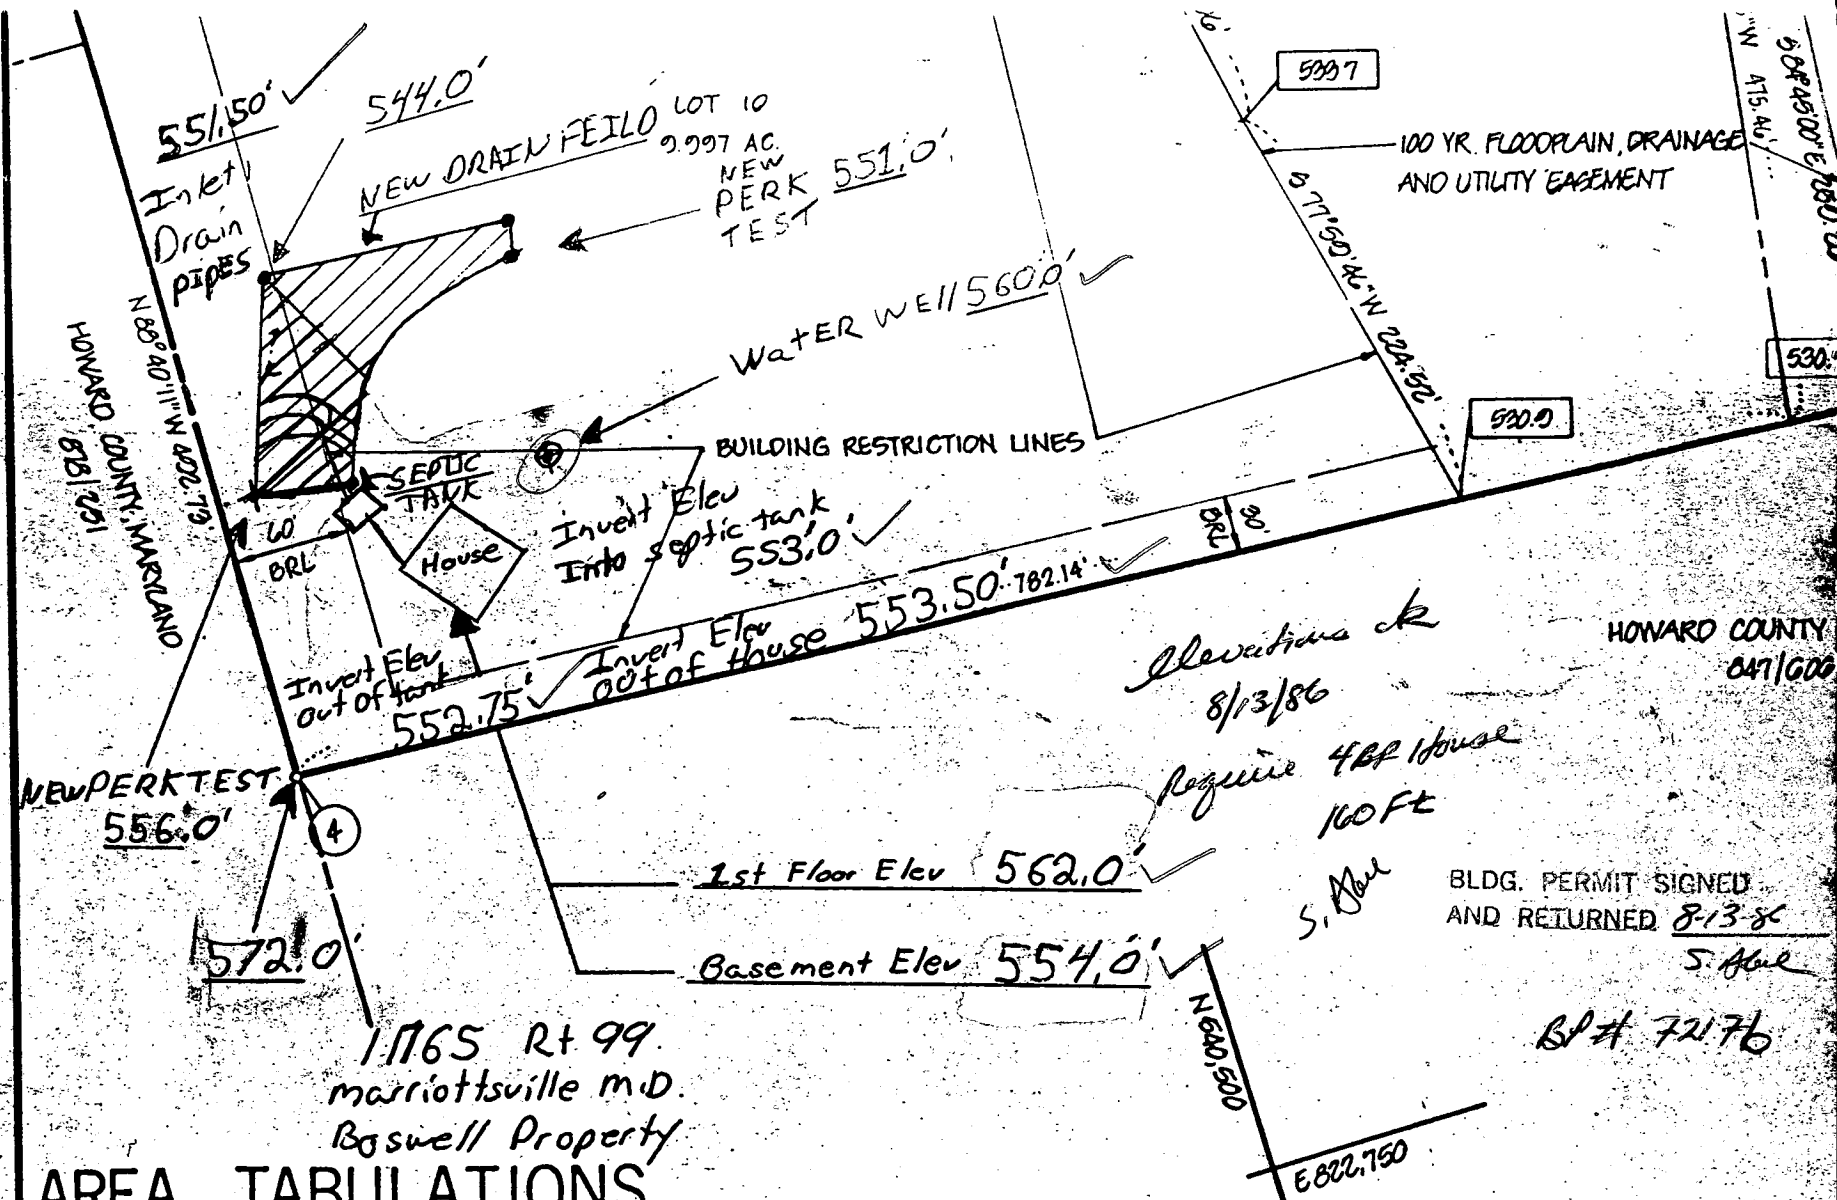

AREA TABULATIONS

TOTAL NUMBER OF LOTS AND/OR PARCELS TO BE RECORDED THIS SHEET: 3
 TOTAL AREA OF LOTS AND/OR PARCELS THIS SHEET: 19.903 AC.
 TOTAL AREA OF ROADWAYS TO BE RECORDED THIS SHEET: NONE
 TOTAL AREA OF SUBDIVISION TO BE RECORDED THIS SHEET: 19.903 AC.

TOTAL AREA TABULATIONS

TOTAL NUMBER OF LOTS AND/OR PARCELS TO BE RECORDED: 6
 TOTAL AREA OF LOTS AND/OR PARCELS TO BE RECORDED: 38.16
 TOTAL AREA OF ROADWAYS TO BE RECORDED: NONE
 TOTAL AREA OF SUBDIVISION TO BE RECORDED: 38.16 AC.

OWNERS STATEMENT

APPROVED: FOR PRIVATE WATER AND PRIVATE SEWERAGE SYSTEMS, HOWARD COUNTY HEALTH

I, MICHAEL O. BOSWELL

APPLICATION

PERCOLATION TESTING

R 36699

P

HOWARD COUNTY HEALTH DEPARTMENT
BUREAU OF ENVIRONMENTAL HEALTH
P.O. BOX 476 ELLICOTT CITY, MARYLAND 21043
TELEPHONE: 461-9933

DISTRICT

DATE

TO: THE COUNTY HEALTH OFFICER
ELLICOTT CITY, MARYLAND

I, HEREBY, APPLY FOR THE NECESSARY TEST IN ORDER TO CONSTRUCT (OR RECONSTRUCT) A SEWAGE DISPOSAL SYSTEM.

PROPERTY OWNER

MIKE PALENCAR

ADDRESS

PHONE

PROSPECTIVE BUYER

ADDRESS

PHONE

PROPERTY LOCATION:

SUBDIVISION

BOSWELL PROPERTY

LOT NO.

10

ROAD AND DESCRIPTION

11805 ROUTE 99 11765

TAX MAP

PARCEL #

BLDG. PERMIT SIGNED

AND RETURNED

8/13/86
BP# 72176

SIZE OF LOT

TYPE BLDG.

(SINGLE FAMILY DWELLING OR COMMERCIAL)

THE SYSTEM INSTALLED UNDER THIS APPLICATION IS ACCEPTABLE ONLY UNTIL PUBLIC FACILITIES BECOME AVAILABLE. I FULLY UNDERSTAND THE FEE CONNECTED WITH THE FILING OF THIS PERC TEST APPLICATION IS NON-REFUNDABLE UNDER ANY CIRCUMSTANCES. I ALSO AGREE TO COMPLY WITH ALL M.O.S.H.A. REQUIREMENTS IN TESTING THIS LOT.

(SIGNATURE OF APPLICANT)

APPROVED BY

C. Williams

FOR

TAGUCHES

DATE

JUNE 1986

REJECTED BY

FOR

DATE

HOLD PENDING FURTHER TESTS

PLAT SIGNED 6/6/86

DATE

REASONS FOR REJECTION OR HOLDING

ORIGINAL TEST RESULTS NOT LOCATED;

WELL WAS DRILLED IN INCORRECT LOCATION; LOT RETESTED
JUNE 1986 TO ESTABLISH ALTERNATE SEPTIC AREA WITHOUT
FORFEITING WELL.

THIS IS NOT A PERMIT

Q

CLAY

61

SANDY
CLAY
LOAM

13'

#3


d.

CLAY

4'

SANDY
CLAY
LOAM

12

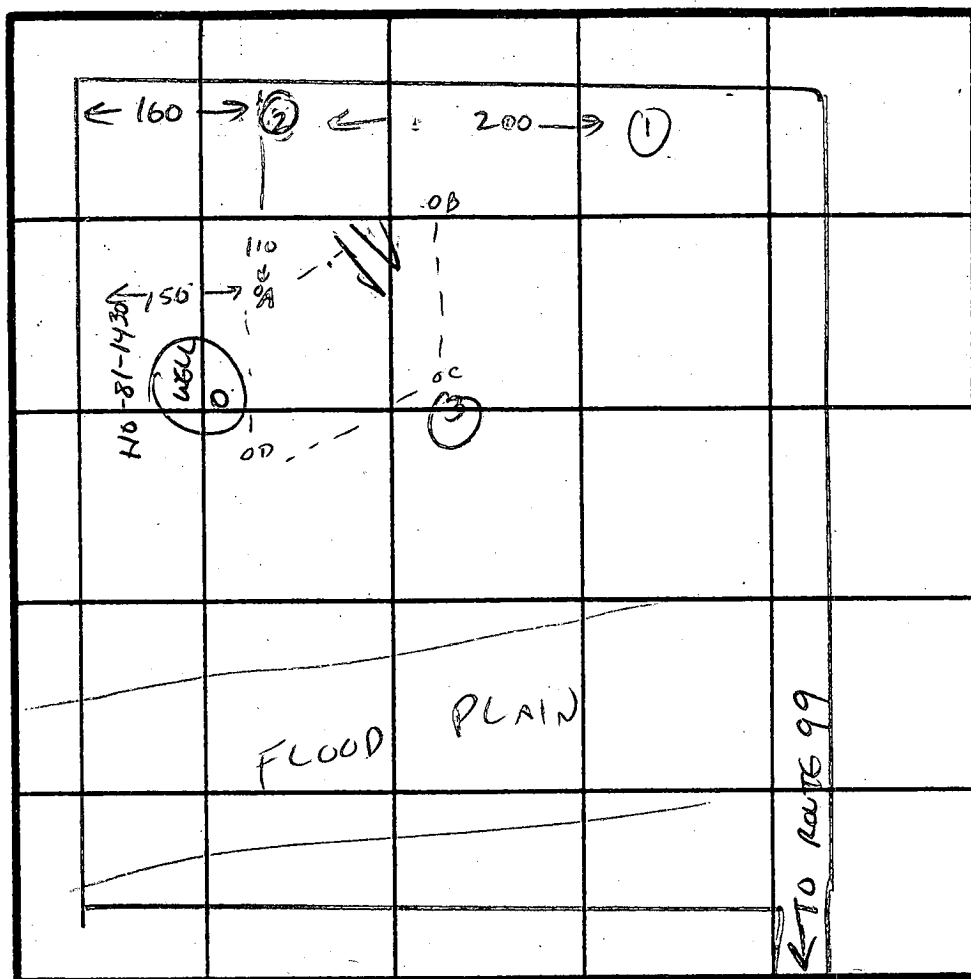

INDICATE NORTH - NAME ADJOINING ROADWAY AS BASE LINE.

DATE	TEST NO.	DEPTH	PRE-WET		TEST - 1" DROP		TIME
			START	STOP	START	STOP	
	ABCD	PREVIOUSLY	APPROVED	- DATA NOT LOCATED.			
JUNE 86	1	CLAY	TO 8'	X			
JUNE 86	2	6 10	2:15 VIS	2:25 OK	2:25	2:40	15 MIN
		13	VIS	OK LOW AM			
JUNE 86	3	4 8	2:52 VIS	2:55 OK	2:55	2:58	3 MIN
		13	VIS OK LOW AM				

REMARKS

OK TO ADJUST PERC AREA TO 100' FROM WALL.

TYPE OF SOIL

SANDY LOAM BELOW CLAY

TESTED BY

Chilham

ALSO PRESENT

SIRK, PALENCAR

TOTAL AREA OF LOTS AND/OR PARCELS TO BE RECORDED: 38

MARYLAND DEPARTMENT OF THE ENVIRONMENT, WATER MANAGEMENT ADMINISTRATION

1800 Washington Blvd., Baltimore, Maryland 21230 (410) 537-3784

WATER WELL ABANDONMENT-SEALING REPORT FORM

SUBMIT COPIES OF COMPLETED FORM TO:

- * COUNTY ENVIRONMENT AGENCY (contact MDE, WMA if address not known)
- * WELL OWNER
- * MDE, WATER MANAGEMENT ADMINISTRATION, WELL PROGRAM

DATE WELL ABANDONED: MAY 23 07 (month/day/year)

OK
9/1/16SC

* PERMIT NUMBER OF ABANDONED WELL (if any) _____

* PERMIT NUMBER OF REPLACEMENT WELL _____

* PERSON ABANDONING WELL: RONALD KYKER

WELL DRILLERS LICENSE NUMBER: MWD 296

CIRCLE: MWD/MSD/MGD

* OWNER'S NAME: DONALD MOOCK

SITE LOCATION MAP

* WELL LOCATION:

COUNTY: HOWARD


NEAREST TOWN: WEST FRIENDSHIP

TAX MAP _____ BLOCK _____ PARCEL _____

SUBDIVISION: _____

SECTION: _____ LOT: _____

NEAREST ROAD: 11765 OLD FREDERICK RD.

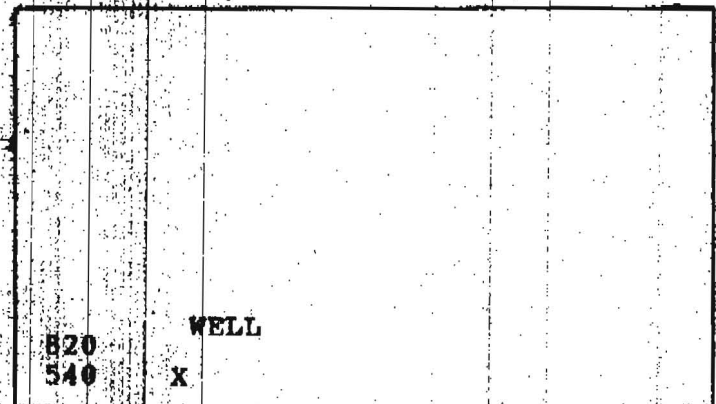

* TYPE OF WELL BEING ABANDONED:

☒ DRILLED ☐ JETTED
☐ BORED/AUGERED ☐ HAND DUG
☐ OTHER (specify) _____

* USE CODE:

☒ DOMESTIC ☐ MUNICIPAL/PUBLIC
☐ IRRIGATION ☐ INDUSTRIAL
☐ TEST/OBSERVATION ☐ GEOTHERMAL

* TYPE OF CASING:

☒ STEEL ☐ PLASTIC
☐ CONCRETE ☐ OTHER (specify) _____

* SIZE OF CASING: 6 INCHES IN DIAMETER

* DEPTH OF WELL: 346 FEET DEEP

* WAS ANY CASING REMOVED? ☐ YES ☒ NO
 if yes, length removed, in feet: _____

* WAS CASING RIPPED OR PERFORATED? ☐ YES ☒ NO

LOG OF SEALING MATERIAL

MATERIAL	-FEET-	
	FROM	TO
CONCRETE	0	346
VOLUME OF MATERIAL USED		
3 1/2 yards concrete		

SIGNATURE-MASTER WELL DRILLER OR SUPERVISING SANITARIAN

296

MWD/MSD/MGD
CIRCLE ONE

5-23-07
DATE