

Building Address:

Suite/Apt. #

Section: _

Tax Map:

Zoning: _

Existing Use:

Proposed Use: ___

Contact Name:

Email:

Applicant's Signature Jime Email Address

Title/Company

Census Tract:

Building Perm

Howard County Maryland Department of Inspections, Licenses and Permits 3430 Court House Drive

Permits: 4 www.howard

Homes INC.

Date Re	ceived:	

	Permits: 410- www.howardco	
uilding Address:	Mcl ₁ Zip Code: 21029 /WP/BA#:	Property Owner's Name: FAT & SHARON HE IN SSELL Address: 13724 Security Address: 21073 Phone: Fax: Email:
		Applicant's Name & Mailing Address (If other than stated herein)
ection: Area		Applicant's Name & Mailing Address, (If other than stated herein) Applicant's Name: Jim Sanders
ax Map: Parcel:	Grid:	Address: 1302 GROCKTAN PR.
	es:Lot Size:	City: Fldersburg State: MM. Zip Code: 21/84 Phone: 410.984.3440 Fax: Email: 7100.0ARTREE CNLINE, NOT
xisting Use: Porch		
Proposed Use: Adddien	1 to KitcheN	Contractor Company: OAKTREE HOMES INC
stimated Construction Cost: \$		Contact Person: Jim Sanders,
Description of Work: Buildin	/	Address: 1302 GROUKTON (13
1	/	City: Eld. State: Md. Zip Code: 2178H
,	for the Kitchen	License No. : Phone: 410 484 544tFax:
@ DINKING ARCH		Email: JIMP DAICTREE ONLINE, NET
Occupant or Tenant:	SHARON HENNESSY	Lindi. Bull Pallelle I Fact ONLINE
Nas tenant space previously occupied?	Wes Farch ONO	Engineer/Architect Company: STARI RydeR, JR,
	ers / DAKTREE HOMES INC	Responsible Design Prof.: AR chitect/PA
Address: 1302 GRECKTO	N DR.	Address: 1593 Hamelandar, 2E
city: Eldershuco s	State: <u>Md. Zip</u> Code: <u>21784</u>	City: Eldersburgstate: Ded Zip Code: 21784
Phone: 410,984,544D		Phone: 443, 631, 216/ Fax:
mail: Time DAKTREE		Email: Jime DAFTREE ONLINE NET.
Commercial Building Characteristics	Residential Building Characteristics	Utilities
Height:	☐ SF Dwelling ☐ SF Townhouse	Water Supply
No. of stories:	<u>Depth</u> <u>Width</u>	Public
Gross area, sq. ft./floor:	1 st floor: /2' 25' 2 nd floor:	☑ Private
Area of construction (sq. ft.):	Basement:	Sewage Disposal
Area or construction (sq. it.).	☐ Finished Basement	Public
Use group:	☐ Unfinished Basement	□′Private
	🗓 Crawl Space	Electric:
Construction type:	☐ Slab on Grade	Gas: Yes No
☐ Reinforced Concrete	No. of Bedrooms:	
☐ Structural Steel	Multi-family Dwelling	Heating System ☑ Électric □ Oil
☐ Masonry	No. of efficiency units:	
☐ Wood Frame☐ State Certified Modular	No. of 1 BR units: No. of 2 BR units:	□ Natural Gas □ Propane Gas
	No. of 3 BR units:	Other:
	Other Structure:	Sprinkler System:
	Dimensions:	☐ Yes ☐ No
> Roadside Tree Project Permit	Footings:	
□Yes ⊋Ño	Roof:	Grading Permit Number:
Roadside Tree Project Permit #	☐ State Certified Modular	
	☐ Manufactured Home	Building Shell Permit Number:
WITH ALL REGULATIONS OF HOWARD COUNTY V	NHICH ARE APPLICABLE THERETO; (4) THAT HE/SHE VINTY OFFICIALS THE RIGHT TO ENTER ONTO THIS PRO	D MAKE THIS APPLICATION; (2) THAT THE INFORMATION IS CORRECT; (3) THAT HE/SHE WILL COMPLY WILL PERFORM NO WORK ON THE ABOVE REFERENCED PROPERTY NOT SPECIFICALLY DESCRIBED IN OPERTY FOR THE PURPOSE OF INSPECTING THE WORK PERMITTED AND POSTING NOTICES. Print Name 7 / 7 / 4



PLEASE WRITE NEATLY & LEGIBLY
-FOR OFFICE USE ONLY-

Date


AGENCY	DATE	SIGNATURE OF APPROVAL
State Highways		
Building Officials		
PSZA (Zoning)		
PSZA (Engineering)		
Health	7-7-16	Drynand

DPZ SETBACK INFORMATION		
Front:		
Rear:		
Side:		
Side St.:		
All minimum setbacks met?	☐ Yes	□No
Is Entrance Permit Required?	☐ Yes	□No
Historic District?	☐ Yes	□No
Lot Coverage for New Town Z	one:	
SDP/Red-line approval date:		

Filing Fee	\$25.00
Permit Fee	\$
Tech Fee	\$
Excise Тах	\$
PSFS	\$
Guaranty Fund	\$
Add'l per Fee	\$
Total Fees	\$
Sub-Total Paid	\$
Balance Due	\$
Check	#

lender or a title insurance company or its agent in connection with contemplated transfer, financing or re-financing. The plat is not to be relied upon for the establishment or location of fences, garages, buildings, or other existing or future improvements. The plat does not provide for the accurate identification of property boundary lines, but such identification may not be required for the transfer of title or securing financing or re-financing.

- (i) The locatiown helpful does not to write the limits of the 100 year flood plain as shown on FIRM Panel No. 32
 - Date of Map: 12-4-86 Flood Zone: "C"
- (2) No property corners found or set unless otherwise noted.
- (3) The accuracy of this survey and the apparent setback distances is 2'±

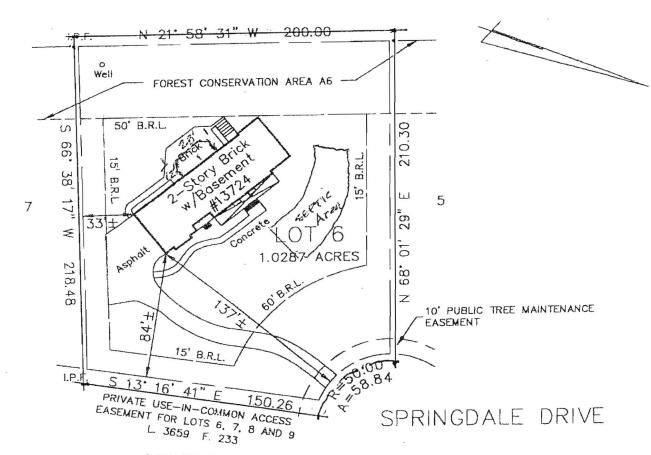

APPROVED

WALK-THRU BUILDING PERMIT

BP#

APD CAN 3

Damard DATE:

fort

approved as

LOCATION DRAWING

LOT 6

PLAT OF CORRECTION
SPRINGDALE ESTATES



SURVEYOR'S CERTIFICATE

I hereby certify that the property delineated hereon is in accordance with the plat of subdivision and/or deed of record, that the improvements were located by accepted field practices and include permanent visible structures and apparent encroachments, if any. This plat is NOT FOR DETERMINING PROPERTY LINES OR FOR CONSTRUCTION