



APPLICATION

FOR PERCOLATION TESTING AND SITE EVALUATION

TEST DATE(S) _____ TEST TIME _____

AP 520108-V

AGENCY REVIEW: _____

DATE 4/9/04

DO NOT WRITE ABOVE THIS LINE

I HEREBY APPLY FOR THE NECESSARY TESTING/EVALUATION PRIOR TO ISSUANCE OF SEWAGE DISPOSAL SYSTEM PERMIT(S) TO:

CHECK AS NEEDED:

- ☒ CONSTRUCT NEW SEPTIC SYSTEM(S)
☐ REPAIR/ADD TO AN EXISTING SEPTIC SYSTEM
☐ REPLACE AN EXISTING SEPTIC SYSTEM

CHECK AS NEEDED:

- ☒ NEW STRUCTURE(S)
☐ ADDITION TO AN EXISTING STRUCTURE
☐ REPLACE AN EXISTING STRUCTURE

CHECK ONE:

- ☒ CREATE NEW LOT(S)
☐ BUILD ON AN EXISTING LOT IN A SUBDIVISION
☐ BUILD ON AN EXISTING PARCEL OF RECORD

IS THE PROPERTY WITHIN 2500' OF ANY RESERVOIR?

- ☐ YES
☒ NO

THE TYPE OF STRUCTURE IS:

- ☒ RESIDENTIAL WITH unknown PROPOSED BEDROOMS IN THE COMPLETED STRUCTURE (NOTE UNKNOWN IF APPROPRIATE)
☐ COMMERCIAL (PROVIDE DETAIL OF NUMBERS AND TYPES OF EMPLOYEES/ CUSTOMERS ON ACCOMPANYING PLAN)
☐ INSTITUTIONAL/GOVERNMENT (PROVIDE DETAIL OF NUMBERS AND TYPES OF EMPLOYEES/USERS ON ACCOMPANYING PLAN)

PROPERTY OWNER(S) LDG Inc. Lee Plaza

DAYTIME PHONE 301-585-7000 CELL _____ FAX _____

MAILING ADDRESS 8601 Georgia Ave. Silver Spring MD 20910
STREET CITY/TOWN STATE ZIP

APPLICANT VanMar Associates Inc.

DAYTIME PHONE 301-829-2890 CELL _____ FAX _____

MAILING ADDRESS 310 South Main St. Mount Airy MD 21771
STREET CITY/TOWN STATE ZIP

APPLICANT'S ROLE: DEVELOPER BUILDER BUYER RELATIVE/FRIEND REALTOR CONSULTANT

PROPERTY LOCATION
SUBDIVISION/PROPERTY NAME Schwabe Farms LOT NO. 23

PROPERTY ADDRESS MD Route 32 West Friendship 21794
STREET TOWN/POST OFFICE

TAX MAP PAGE(S) 15 GRID 5 PARCEL(S) 12 PROPOSED LOT SIZE 1AC±

AS APPLICANT, I UNDERSTAND THE FOLLOWING: THE SYSTEM INSTALLED SUBSEQUENT TO THIS APPLICATION IS ACCEPTABLE ONLY UNTIL PUBLIC SEWERAGE IS AVAILABLE. THIS APPLICATION IS COMPLETE WHEN ALL APPLICABLE FEES AND A SUITABLE SITE PLAN HAVE BEEN RECEIVED. I ACCEPT THE RESPONSIBILITY FOR COMPLIANCE WITH ALL M.O.S.H.A. AND "MISS UTILITY" REQUIREMENTS. APPROVAL IS BASED UPON SATISFACTORY REVIEW OF A PERC CERTIFICATION PLAN.

TEST RESULTS WILL BE MAILED TO APPLICANT.

Danielle Spelt
SIGNATURE OF APPLICANT

HOWARD COUNTY HEALTH DEPARTMENT, BUREAU OF ENVIRONMENTAL HEALTH, WELL AND SEPTIC PROGRAM
3525-H ELLICOTT MILLS DRIVE, ELLICOTT CITY, MARYLAND 21043-4544 (410) 313-1771 FAX (410) 313-2648
TDD (410) 313-2323 TOLL FREE 1-877-4MD-DHMH

AP

610


Brown L	1'
Yellow/Brown micaceous Sl w/ 15% platy mica schist	9'
Brown/Yellow Sl/Sl w/ 15-20% platy mica schist	9'

611

Brown L	1'
Brown/orange Yellow micaceous Sch	5'
Brown/Yellow micaceous Sl w/ 10% cherty qtz	9 1/2'
Yellow/Brown Black s water	11'

612

Brown L	1'
Orange/Brown micaceous Sch	4 1/2'
Brown/Red Sl w/ 10% mica schist	5'
Yellow/Brown s	11'

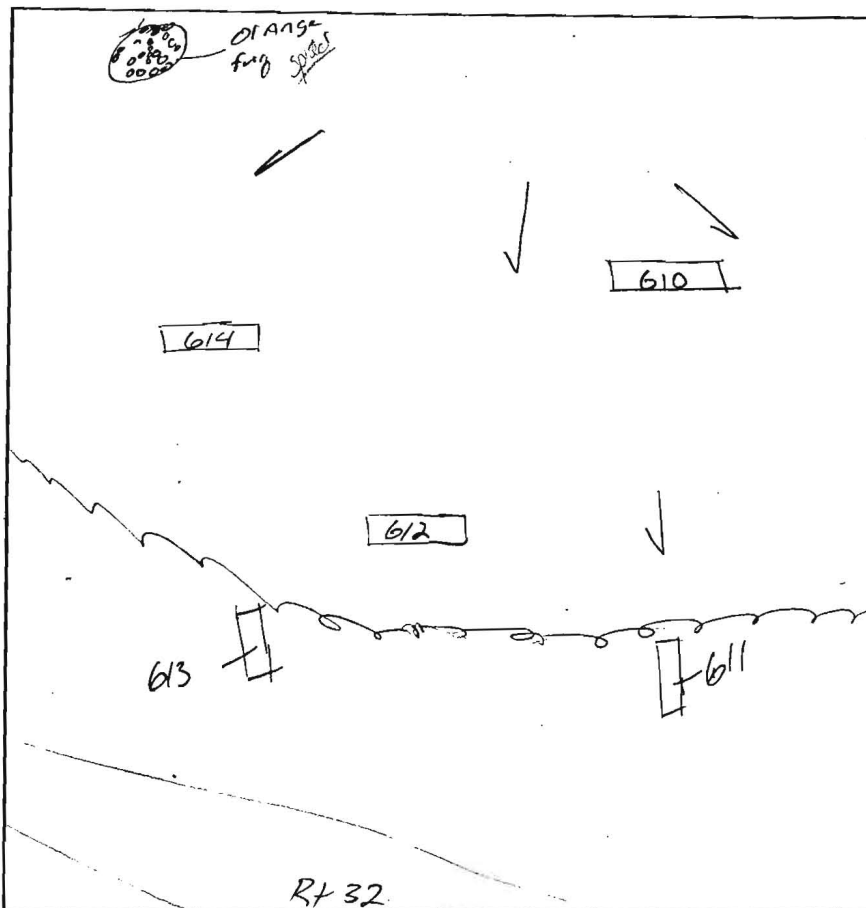

614

Brown L	1'
Red/Orange Yellow micaceous Sch	4 1/2'
Yellow/Brown micaceous Sl	10'
Yellow/Brown s w/ trace Red	12'

613

Brown L	1'
Yellow/Brown micaceous Sch	5 1/2'
Red/Orange Brown Sl	7'
Yellow/Brown micaceous w/ trace Rock	12'

DATE	TEST #	DEPTH	START	BREAK 1" DROP	STOP 2" DROP	TIME OF 2ND INCH	P/F/H
7/16/04	610	4' 9'	11:24	11:35	11:28	3 min	P
	611	3 1/2' 11'	11:32	- Pulled	- 12:03	Slow	F
	612	11'	- Visual -			OK	P
	614	4 1/2' 12'	11:38	11:41	11:45	4 min	P
	613	6' 12'	12:30	12:40	12:55	15 min	P
Retest -	611	5 1/2' 11'	3:11	- Pulled	3:30	Slow	F

REMARKS more uphill of field hole lots 22+23

SANITARIAN KJB BACKHOE Justin OTHERS Zack

TEST HOLES USED IN SDA _____ AVG. PERC TIME _____ SQ. FT/BR _____

TRENCH WIDTH _____ INLET DEPTH _____ MAX. BOT DEPTH _____ EFFECTIVE S/W _____

AP

605


Brown L	1'
Orange/Yellow Brown micas sil	4'
Orange/Yellow Gray micas sil	4'
Trace Rock -	8'
Black/gray micas & water	10'

606

Brown L	1'
Orange/Brown sil	4'
Yellow/Brown micas sil	8'
Trace Rock -	11'
Black/Yellow sil/sil water	11'

608

Rooted Brown L	1'
Brown/Orange Red micas sil w/ 10% at gravelly	3'
Brown/Orange Yellow sil w/ trace Rock	9'
Yellow/Brown sil water	10'

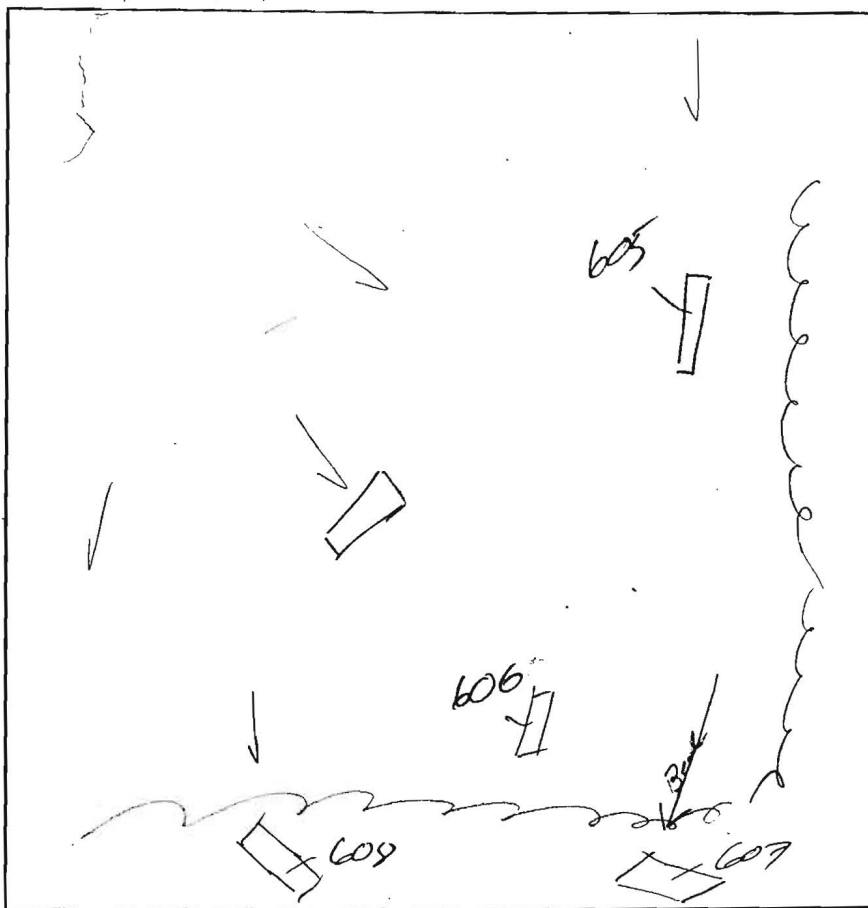

607

Rooted Brown L	1 1/2'
Black/Brown sil	2 1/2'
Dark gray micas sil	3'
Orange/gray Brown sil w/ 3d. matts	8 1/2'
Water	9'

609

Brown L	1'
Orange/Red Yellow sil	3 1/2'
Brown/Yellow micas sil	8'
Yellow/Orange sil w/ 15% flaky mica sil	11'


DATE	TEST #	DEPTH	START	BREAK 1" DROP	STOP 2" DROP	TIME OF 2ND INCH	P/F/H
7/16/64	605	4' / 10'	10:12	10:25	10:37	13min	P
	606	4' / 11'	10:40	10:54	11:20	26min	P
	608	3 1/2' / 10'	11:08	11:28	11:58	30min	P
	607	9'	- Visual -				F
	609	4' / 11'	11:15	11:17	11:19	2min	P

REMARKS 607 - high H₂O - looks like dried river bed.

SANITARIAN KJB BACKHOE Justin OTHERS Zack

TEST HOLES USED IN SDA _____ AVG. PERC TIME _____ SQ. FT/BR _____

TRENCH WIDTH _____ INLET DEPTH _____ MAX. BOT DEPTH _____ EFFECTIVE SW _____

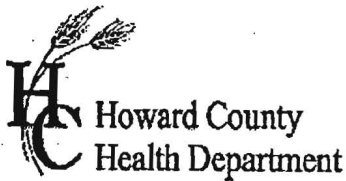

APPLICATION

FOR PERCOLATION TESTING AND SITE EVALUATION

TEST DATE(S) _____ TEST TIME _____

AP 520108-U

AGENCY REVIEW: _____

DATE 4/10/04

DO NOT WRITE ABOVE THIS LINE

I HEREBY APPLY FOR THE NECESSARY TESTING/EVALUATION PRIOR TO ISSUANCE OF SEWAGE DISPOSAL SYSTEM PERMIT(S) TO:

CHECK AS NEEDED:

- ☒ CONSTRUCT NEW SEPTIC SYSTEM(S)
☐ REPAIR/ADD TO AN EXISTING SEPTIC SYSTEM
☐ REPLACE AN EXISTING SEPTIC SYSTEM

CHECK AS NEEDED:

- ☒ NEW STRUCTURE(S)
☐ ADDITION TO AN EXISTING STRUCTURE
☐ REPLACE AN EXISTING STRUCTURE

CHECK ONE:

- ☒ CREATE NEW LOT(S)
☐ BUILD ON AN EXISTING LOT IN A SUBDIVISION
☐ BUILD ON AN EXISTING PARCEL OF RECORD

IS THE PROPERTY WITHIN 2500' OF ANY RESERVOIR?

- ☐ YES
☒ NO

THE TYPE OF STRUCTURE IS:

- ☒ RESIDENTIAL WITH UNKNOWN PROPOSED BEDROOMS IN THE COMPLETED STRUCTURE (NOTE UNKNOWN IF APPROPRIATE)
☐ COMMERCIAL (PROVIDE DETAIL OF NUMBERS AND TYPES OF EMPLOYEES/ CUSTOMERS ON ACCOMPANYING PLAN)
☐ INSTITUTIONAL/GOVERNMENT (PROVIDE DETAIL OF NUMBERS AND TYPES OF EMPLOYEES/USERS ON ACCOMPANYING PLAN)

PROPERTY OWNER(S) LDCI Inc. J Lee Plaza

DAYTIME PHONE 301-585-7000 CELL _____ FAX _____

MAILING ADDRESS 3601 Georgia Ave. Silver Spring MD 20910
STREET CITY/TOWN STATE ZIP

APPLICANT VanMar Associates Inc.

DAYTIME PHONE 301-829-2890 CELL _____ FAX _____

MAILING ADDRESS 310 South Main St. Mount Airy MD 21771
STREET CITY/TOWN STATE ZIP

APPLICANT'S ROLE: DEVELOPER BUILDER BUYER RELATIVE/FRIEND REALTOR CONSULTANT

PROPERTY LOCATION

SUBDIVISION/PROPERTY NAME Schwabe Farms LOT NO. 22

PROPERTY ADDRESS MD Route 32 West Friendship 21794
STREET TOWN/POST OFFICE

TAX MAP PAGE(S) 15 GRID 5 PARCEL(S) 12 PROPOSED LOT SIZE 1AC±

AS APPLICANT, I UNDERSTAND THE FOLLOWING: THE SYSTEM INSTALLED SUBSEQUENT TO THIS APPLICATION IS ACCEPTABLE ONLY UNTIL PUBLIC SEWERAGE IS AVAILABLE. THIS APPLICATION IS COMPLETE WHEN ALL APPLICABLE FEES AND A SUITABLE SITE PLAN HAVE BEEN RECEIVED. I ACCEPT THE RESPONSIBILITY FOR COMPLIANCE WITH ALL M.O.S.H.A. AND "MISS UTILITY" REQUIREMENTS. APPROVAL IS BASED UPON SATISFACTORY REVIEW OF A PERC CERTIFICATION PLAN.

TEST RESULTS WILL BE MAILED TO APPLICANT.

Daniel L. Stolt
SIGNATURE OF APPLICANT

HOWARD COUNTY HEALTH DEPARTMENT, BUREAU OF ENVIRONMENTAL HEALTH, WELL AND SEPTIC PROGRAM
3525-H ELLICOTT MILLS DRIVE, ELLICOTT CITY, MARYLAND 21043-4544 (410) 313-1771 FAX (410) 313-2648
TDD (410) 313-2323 TOLL FREE 1-877-4MD-DHMH

