
DRILLER: COMPLETE THIS FORM AND RETURN ALL PARTS OF THIS FORM INTACT TO THE ENVIRONMENTAL AGENCY IN THE COUNTY IN WHICH THE WELL IS TO BE DRILLED. PRESS FIRMLY FOR FIFTH COPY.

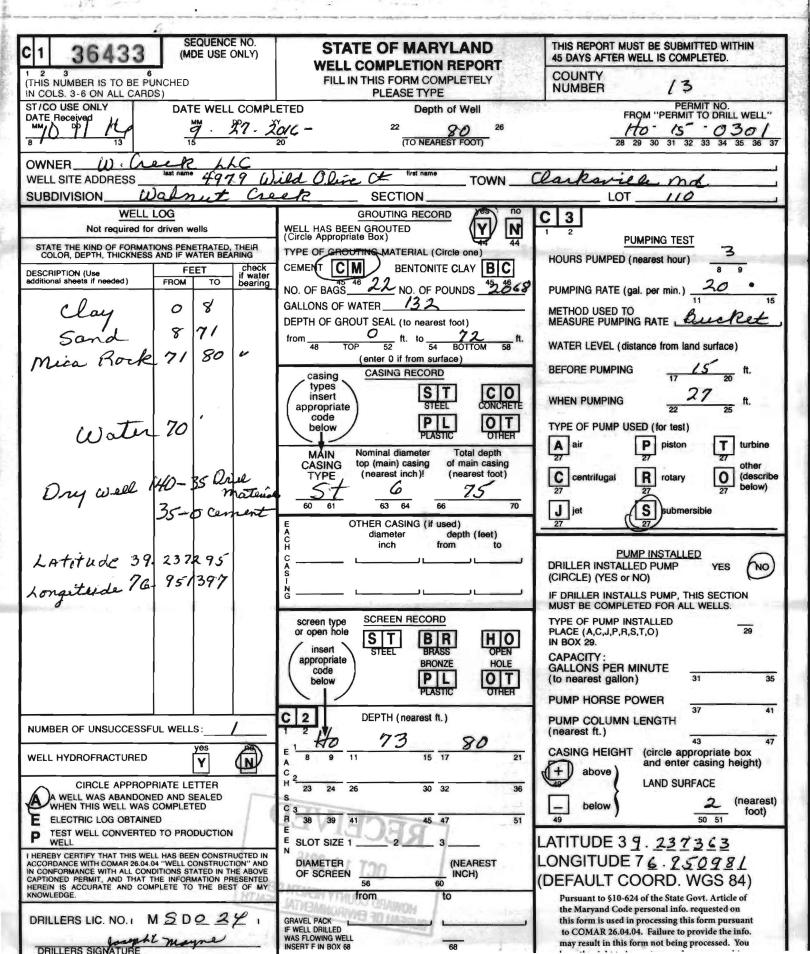

Well at 4979 Wild Olive Ct Walnut Geek took 3 more bage cement. tag Ho-15-0301. Please attach to well completion sent in 9-28-2016. Betty mayne