

C1 3999

SEQUENCE NO.
(MDE USE ONLY)STATE OF MARYLAND
WELL COMPLETION REPORT
FILL IN THIS FORM COMPLETELY
PLEASE TYPETHIS REPORT MUST BE SUBMITTED WITHIN
45 DAYS AFTER WELL IS COMPLETED.COUNTY
NUMBER1 2 3 6
(THIS NUMBER IS TO BE PUNCHED
IN COLS. 3-6 ON ALL CARDS)

ST/CO USE ONLY

DATE Received

MM DD YY

8 13

DATE WELL COMPLETED

MM DD YY

11 30 04

15 20

Depth of Well

22 26

(TO NEAREST FOOT)

PERMIT NO.
FROM "PERMIT TO DRILL WELL"

H0-81-2161

28 29 30 31 32 33 34 35 36 37

OWNER MARTIN, SALLY
STREET OR RFD 8250 OLD COLUMBIA RD TOWN FULTON
SUBDIVISION _____ SECTION _____ LOT _____

WELL LOG

Not required for driven wells

STATE THE KIND OF FORMATIONS PENETRATED, THEIR
COLOR, DEPTH, THICKNESS AND IF WATER BEARING

DESCRIPTION (Use additional sheets if needed)

FEET

FROM

TO

check if water bearing

Tannish/gray mica 265 325

Gray Sandy mica 325 505

Sandstone Tan 505 516

Gray Sandy mica 516 600

265-325

325-505

505-516

516-600

600-610

610-620

620-630

1290-1300

GROUTING RECORD

yes no

WELL HAS BEEN GROUTED
(Circle Appropriate Box)

Y N

TYPE OF GROUTING MATERIAL (Circle one)

CEMENT CM

BENTONITE CLAY BC

NO. OF BAGS 45 46

NO. OF POUNDS 45 46

GALLONS OF WATER

DEPTH OF GROUT SEAL (to nearest foot)

from 48 TOP 52 ft. to 54 BOTTOM 58 ft.

(enter 0 if from surface)

48 52 54 58

48 52 54 58

CASING RECORD

casing types insert appropriate code below

ST STEEL

CO CONCRETE

PL PLASTIC

OT OTHER

MAIN CASING TYPE

Nominal diameter top (main) casing (nearest inch)

Total depth of main casing (nearest foot)

60 61

63 64

66 70

60 61

63 64

66 70

60 61



63 64

66 70

60 61

63 64

66 70</

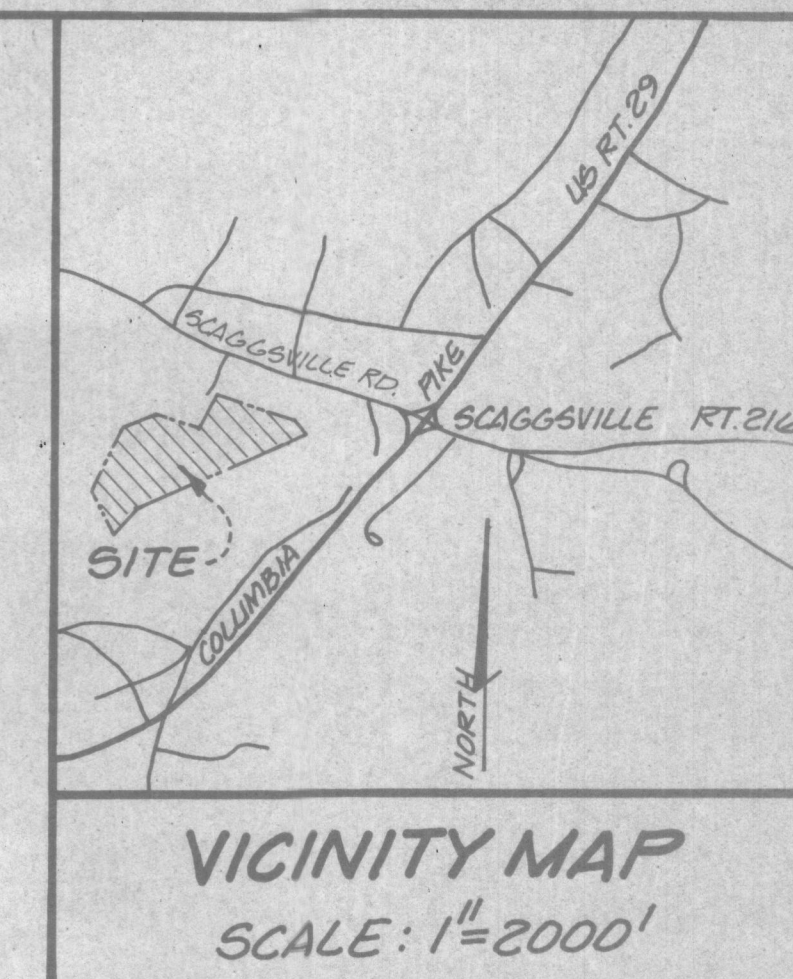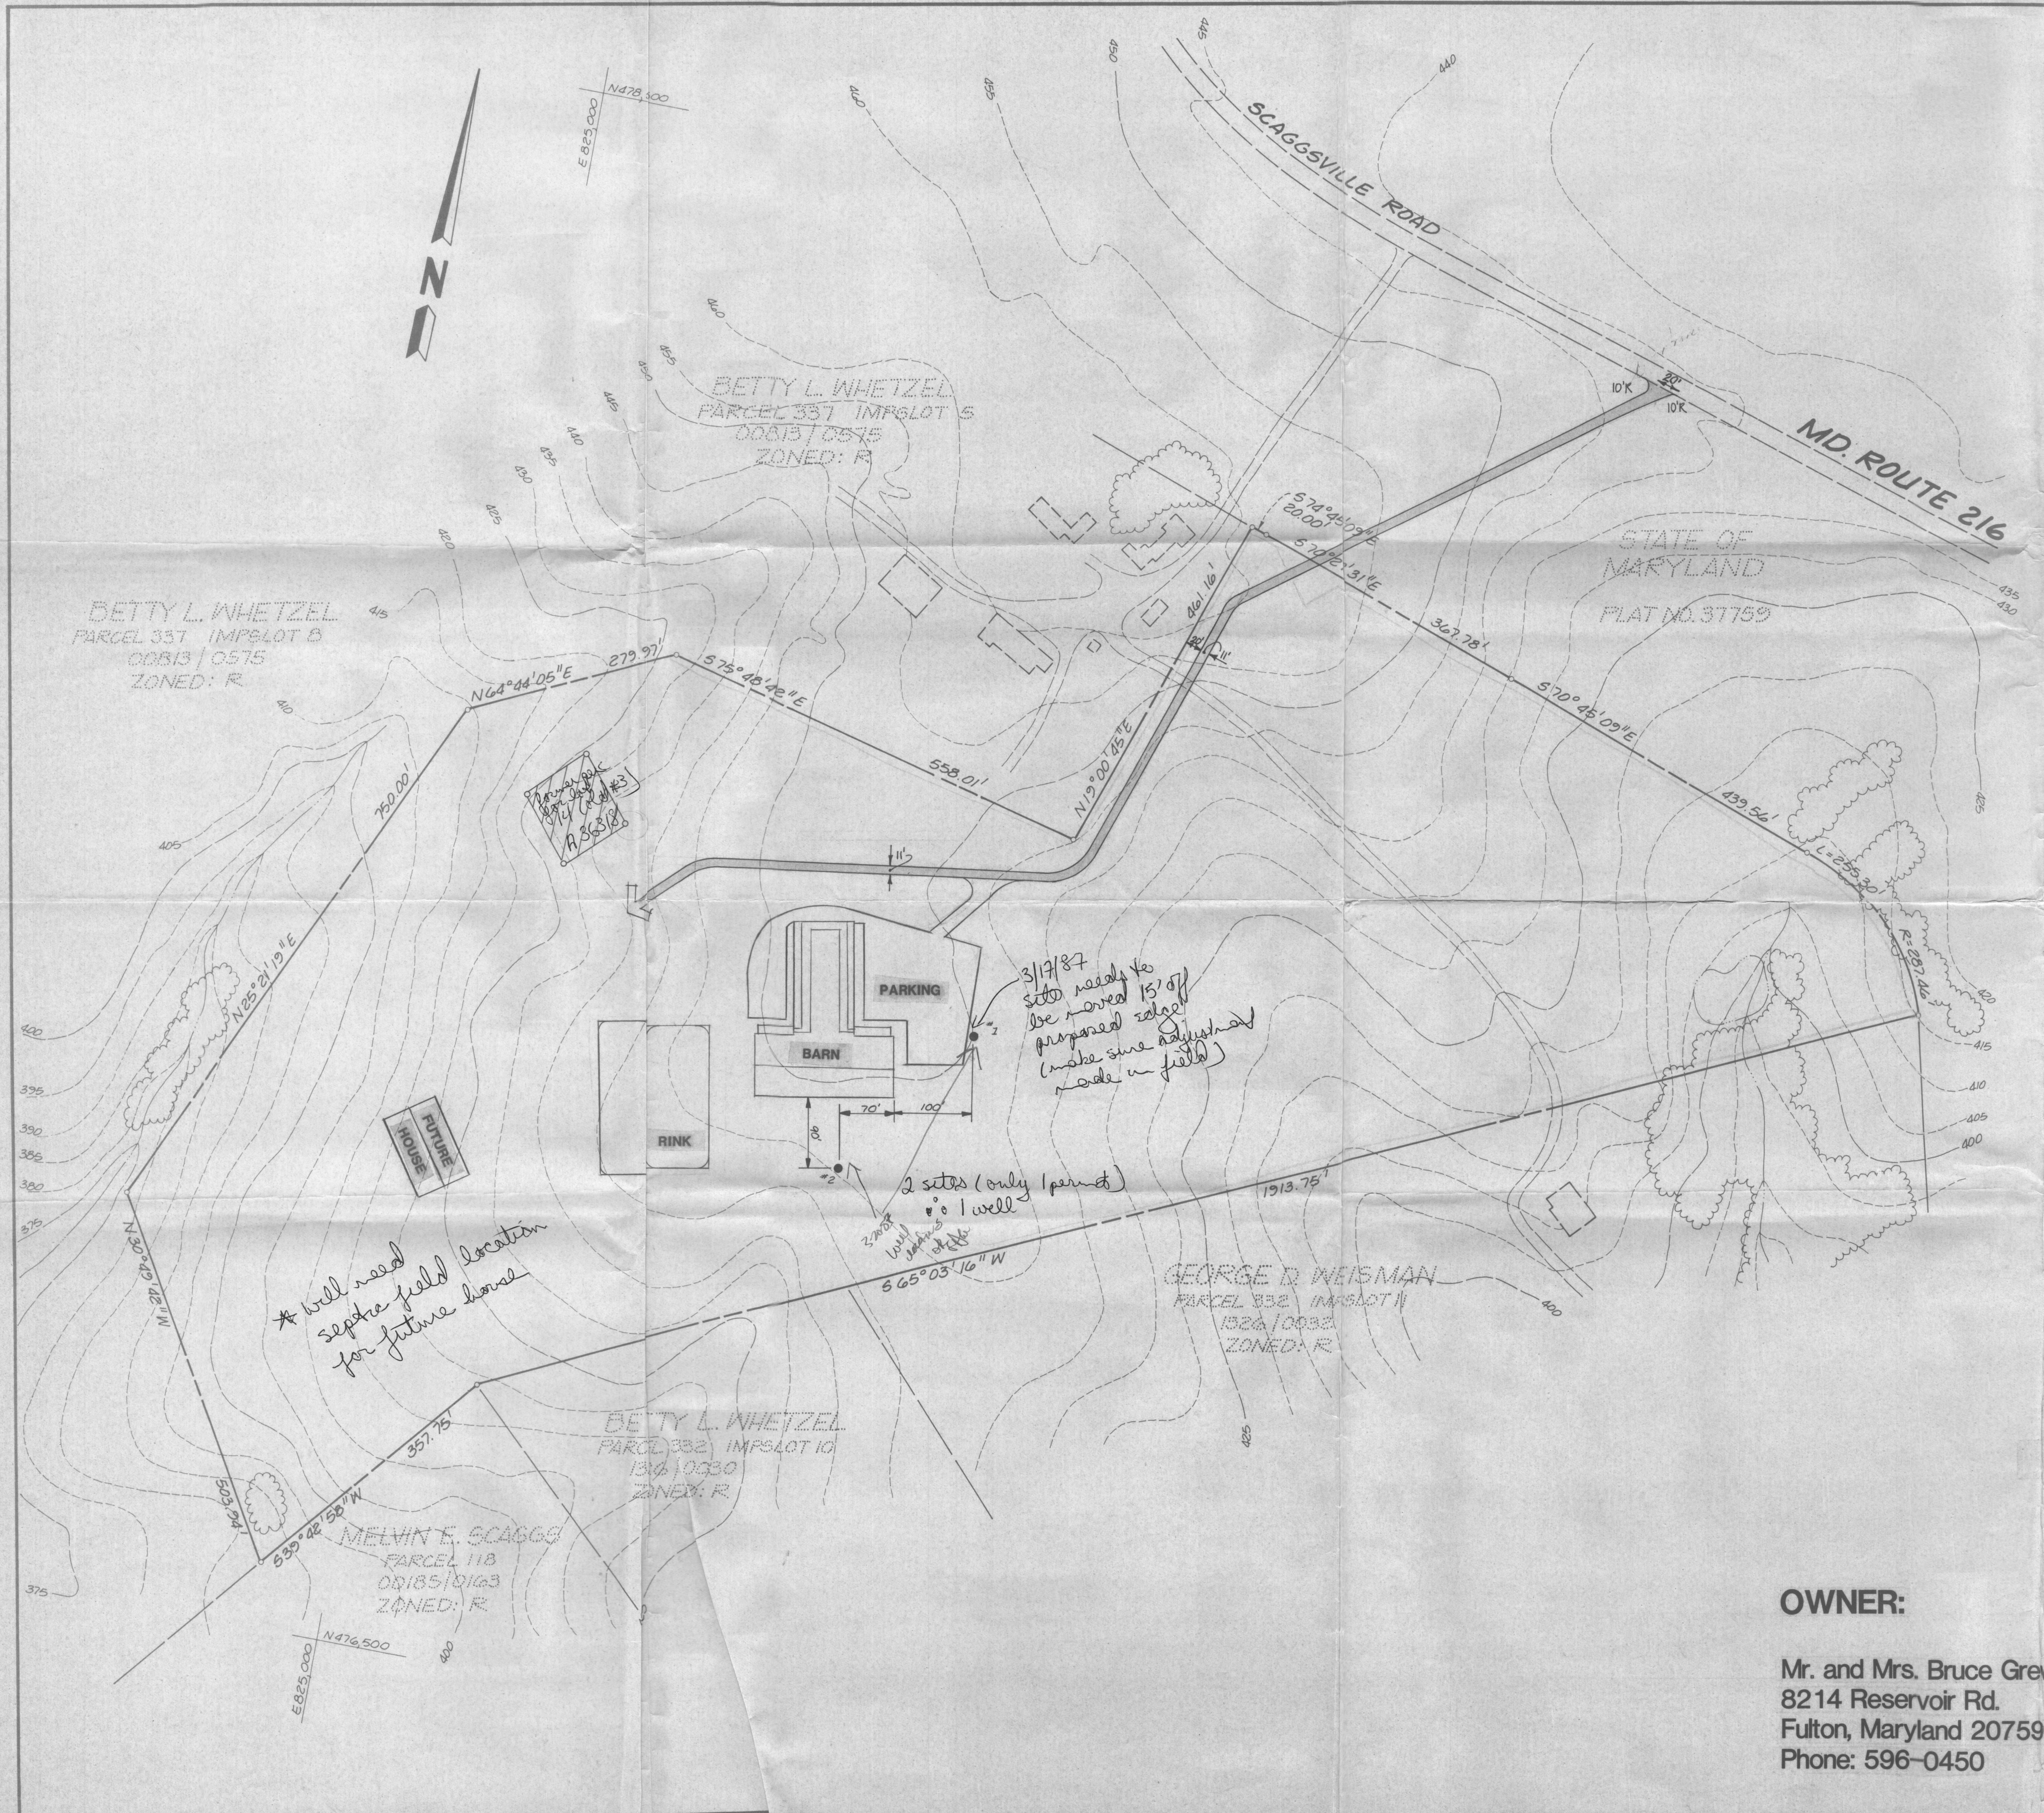

KEY:

- PERCOLATION AREA FOR BARN
- WATER WELL #1 & #2
- NOTE: PERC AREA TAKEN FROM P-86-34

GREWELL ESTATE **WELL LOCATION / DRAIN FIELD PLAN**

OWNER:

Mr. and Mrs. Bruce Grewall
8214 Reservoir Rd.
Fulton, Maryland 20759
Phone: 596-0450

KIDDE CONSULTANTS, INC.		
DATE	REVISION	BY
ENGINEERS • PLANNERS • SURVEYORS		
1100 WEST STREET, SUITE 100 • LAUREL, MD 20707		
(Wash.) (301) 953-1821 / 792-8086 (Balt.)		
SURVEYED BY		
COMPUTED BY		
DRAWN BY		
CHECKED BY		
DATE		SCALE
MARCH 10, 1987		1"=100'