

2/19/93
WOOD

Per IO -

PERMIT

SEWAGE DISPOSAL SYSTEM

DEPARTMENT OF HEALTH AND MENTAL HYGIENE

P 48896

A 36320

DISTRICT _____

HOWARD COUNTY HEALTH DEPARTMENT

BUREAU OF ENVIRONMENTAL HEALTH

~~481-9933~~ 313-2640

INDEXED

DATE 2/03/93

DATE SYSTEM APPROVED 2/5/93

INSPECTOR *B/H*

Whitworth Excavating

IS PERMITTED TO INSTALL ☒ ALTER

ADDRESS 12680 Clarksville pike, Columbia, Maryland 21029 PHONE 531-5033

SUBDIVISION St. Francis of Assisi LOT 2 ROAD 11405 Scaggsville Road

PROPERTY OWNER Sally Teague

ADDRESS _____

SEPTIC TANK CAPACITY 1500 GALLONS

NUMBER OF BEDROOMS 5

220 SQUARE FEET PER BEDROOM (Allow for two trenches 110 feet each).

LINEAR FEET OF TRENCH REQUIRED 220 (Okay for two trenches 110 feet each)

TRENCHES - Trench to be 2 feet wide. Inlet 3 feet below original grade. Bottom maximum depth 8 feet below original grade. Effective area begins at 3 feet below original grade. 5 feet of stone below distribution pipe.

LOCATION - Place the distribution box approximately 180 feet from the left-rear (503') lot line and 145 feet from the left (357') lot line. This location should be 100 feet from the closest corner of the house, and 85 feet from the closest corner of the of the swimming pool. Run trenches along contour.

NOTES - Provide 6" - 8" diameter cleanout and cap to grade or above on septic tank. *ok/cw*

PLANS APPROVED BY Raymond Hodges/C. Williams

REVISED DATE 2/03/93

COVER NO WORK UNTIL INSPECTED AND APPROVED

NEITHER THE HOWARD COUNTY COUNCIL NOR THE HEALTH DEPARTMENT IS RESPONSIBLE FOR THE SUCCESSFUL OPERATION OF ANY SYSTEM

NOTE: CLEANOUT REQUIRED EVERY 70 FEET OF SEWER LINE AND/OR AT 90° SWEEPS IN LINES FROM HOUSE TO DRAIN FIELDS, 90° ELBOWS NOT ACCEPTABLE.

NOTE: ALL PARTS OF SEPTIC SYSTEMS (I.E. TANK, DISTRIBUTION BOX TRENCHES) TO BE 100 FEET FROM WELL (UNLESS OTHERWISE SPECIFICALLY AUTHORIZED)

NOTE: IF DEEP TRENCH(ES) ARE USED CALL FOR INSPECTION BEFORE AND AFTER PLACING GRAVEL IN TRENCH(ES)

NOTE: NO DRY WELL SHALL EXCEED 15 FOOT IN DIAMETER NO ABSORPTION TRENCH TO EXCEED 100 FEET IN LENGTH

NOTE: ALL PIPE FROM HOUSE TO SEPTIC TANK MUST BE CAST IRON OR SCHEDULE 35/40 PVC OR ABS

PERMIT VOID AFTER TWO YEARS

NOTE: INSTALL STAND PIPE ON SEPTIC TANK AND DRY WELL STAND PIPES MUST BE 6 INCHES IN DIAMETER CAST IRON. CONCRETE OR TERRA COTTA OR PVA OR ABS ACCEPTED. IF TOP OF SEPTIC TANK IS DEEPER THAN 3 FEET. MANHOLE TO GRADE REQUIRED.


NOTE: DISTRIBUTION BOXES MUST HAVE BAFFLES

***INSTALLER IS RESPONSIBLE FOR OBTAINING FINAL APPROVAL ON THIS PERMIT**

HD-260(6-90)

*CALL 481-9933 FOR INSPECTION OF SEPTIC SYSTEM.

A 36320

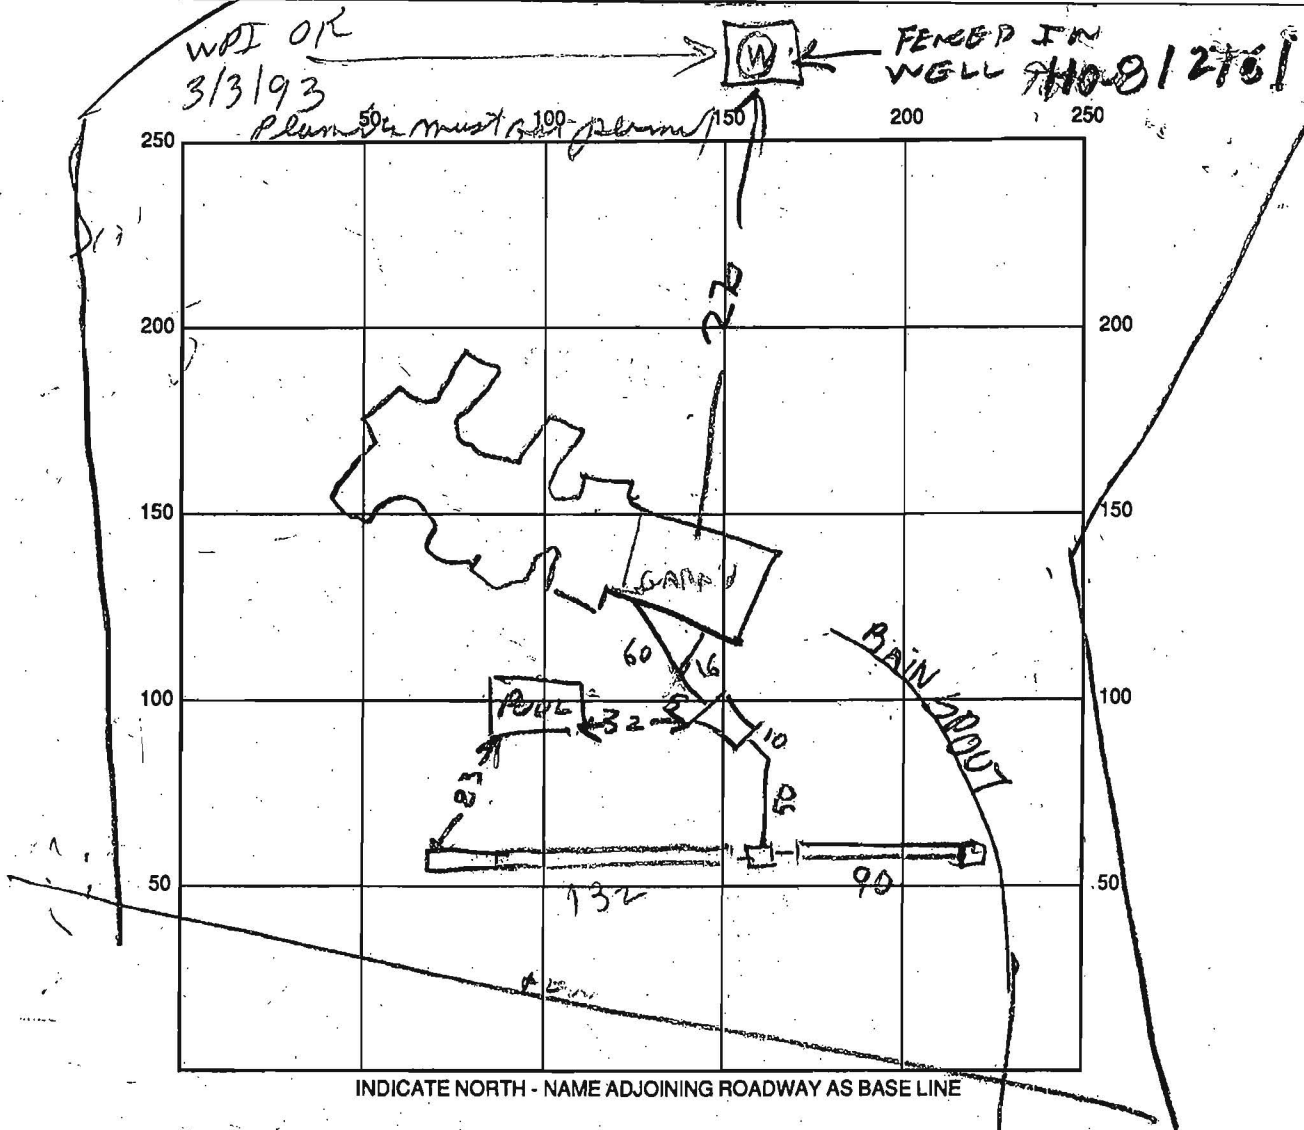

SEPTIC TANK LEVEL 2000 CLEANOUTS _____

DISTRIBUTION BOX LEVEL OK

DRAIN FIELD/TITLE DEPTH 8 FT. TRENCH WIDTH 2 FT. INLET DEPTH 3 FT.

EFFECTIVE GRAVEL DEPTH 5 FT. TOTAL LENGTH 90/132 FT.

NUMBER OF TRENCHES 2 ONE SIDEWALL/BOTTOM AREA 22 SQ. FT.

DRYWALL INSIDE DIAMETER _____ FT. EFFECTIVE DEPTH BELOW INLET 110 FT.

ABSORBENT AREA _____ SQ. FT.

REMARKS: 2/24/93 - SHORT TRENCH INTERSECTED RAIN
SPOUT. CHANGE TO ONE LONG TRENCH 130 FT LONG
& ONE SHORT TRENCH 90 FT LONG. FINISH DIGGING
TRENCHES & ADD STONE BIT
2/5/93 TRENCHES FINISHED

DATE SYSTEM APPROVED 2/5/93 INSPECTOR Raymond Hodge

976.13
229.32
744.80

ARE BASED
TE GRID SYSTEM
CONTROL

N 25° 21' 17" E

750.01'

I.B.F.

N 64° 44' 08" E

279.97'

(23)

I.B.F.

S 75° 48' 44" E

558.01'

(12)

B.R.L.

S 40° 58' 24" E
18.89'

S 19° 00' 4"

60' BUILDING RESTRICTION LINE

30' BUILDING RESTRICTION LINE

30' BUILDING RESTRICTION LINE

30' BUILDING RESTRICTION LINE

503.93'

N 30° 49' 42" W

30' BUILDING RESTRICTION LINE

S 39° 42' 58" W

357.74'

(19)

S 65° 03' 16" W

MELVIN E. SCAGGS
LIBER 185 FOLIO 163

ST FRANCIS OF ASSISSI SUBD. (2 LOTS)

F 91-172

SENT FOR SIGN. 10/28/91

FORMER SOPER PROPERTY LOT 8 FROM PRELIMINARY PLAN - (FINAL NEVER COMPLETED)


LOT 2

AREA - 19.7101 AC. +/-

USE-IN-COMMON EASEMENT - 23106 S.F. OR 0.5304 AC. +/-

NET AREA - 19.1797 AC. +/-


LOT 9


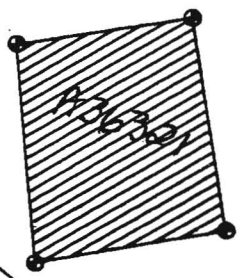


Other septic areas platished on this lot see preliminary SEIBERT 'C.W.

TOO SCAGGSVILLE RD
THRU LOT 1

LOT 3
SOPER PROPERTY
PLAT NO. 4119

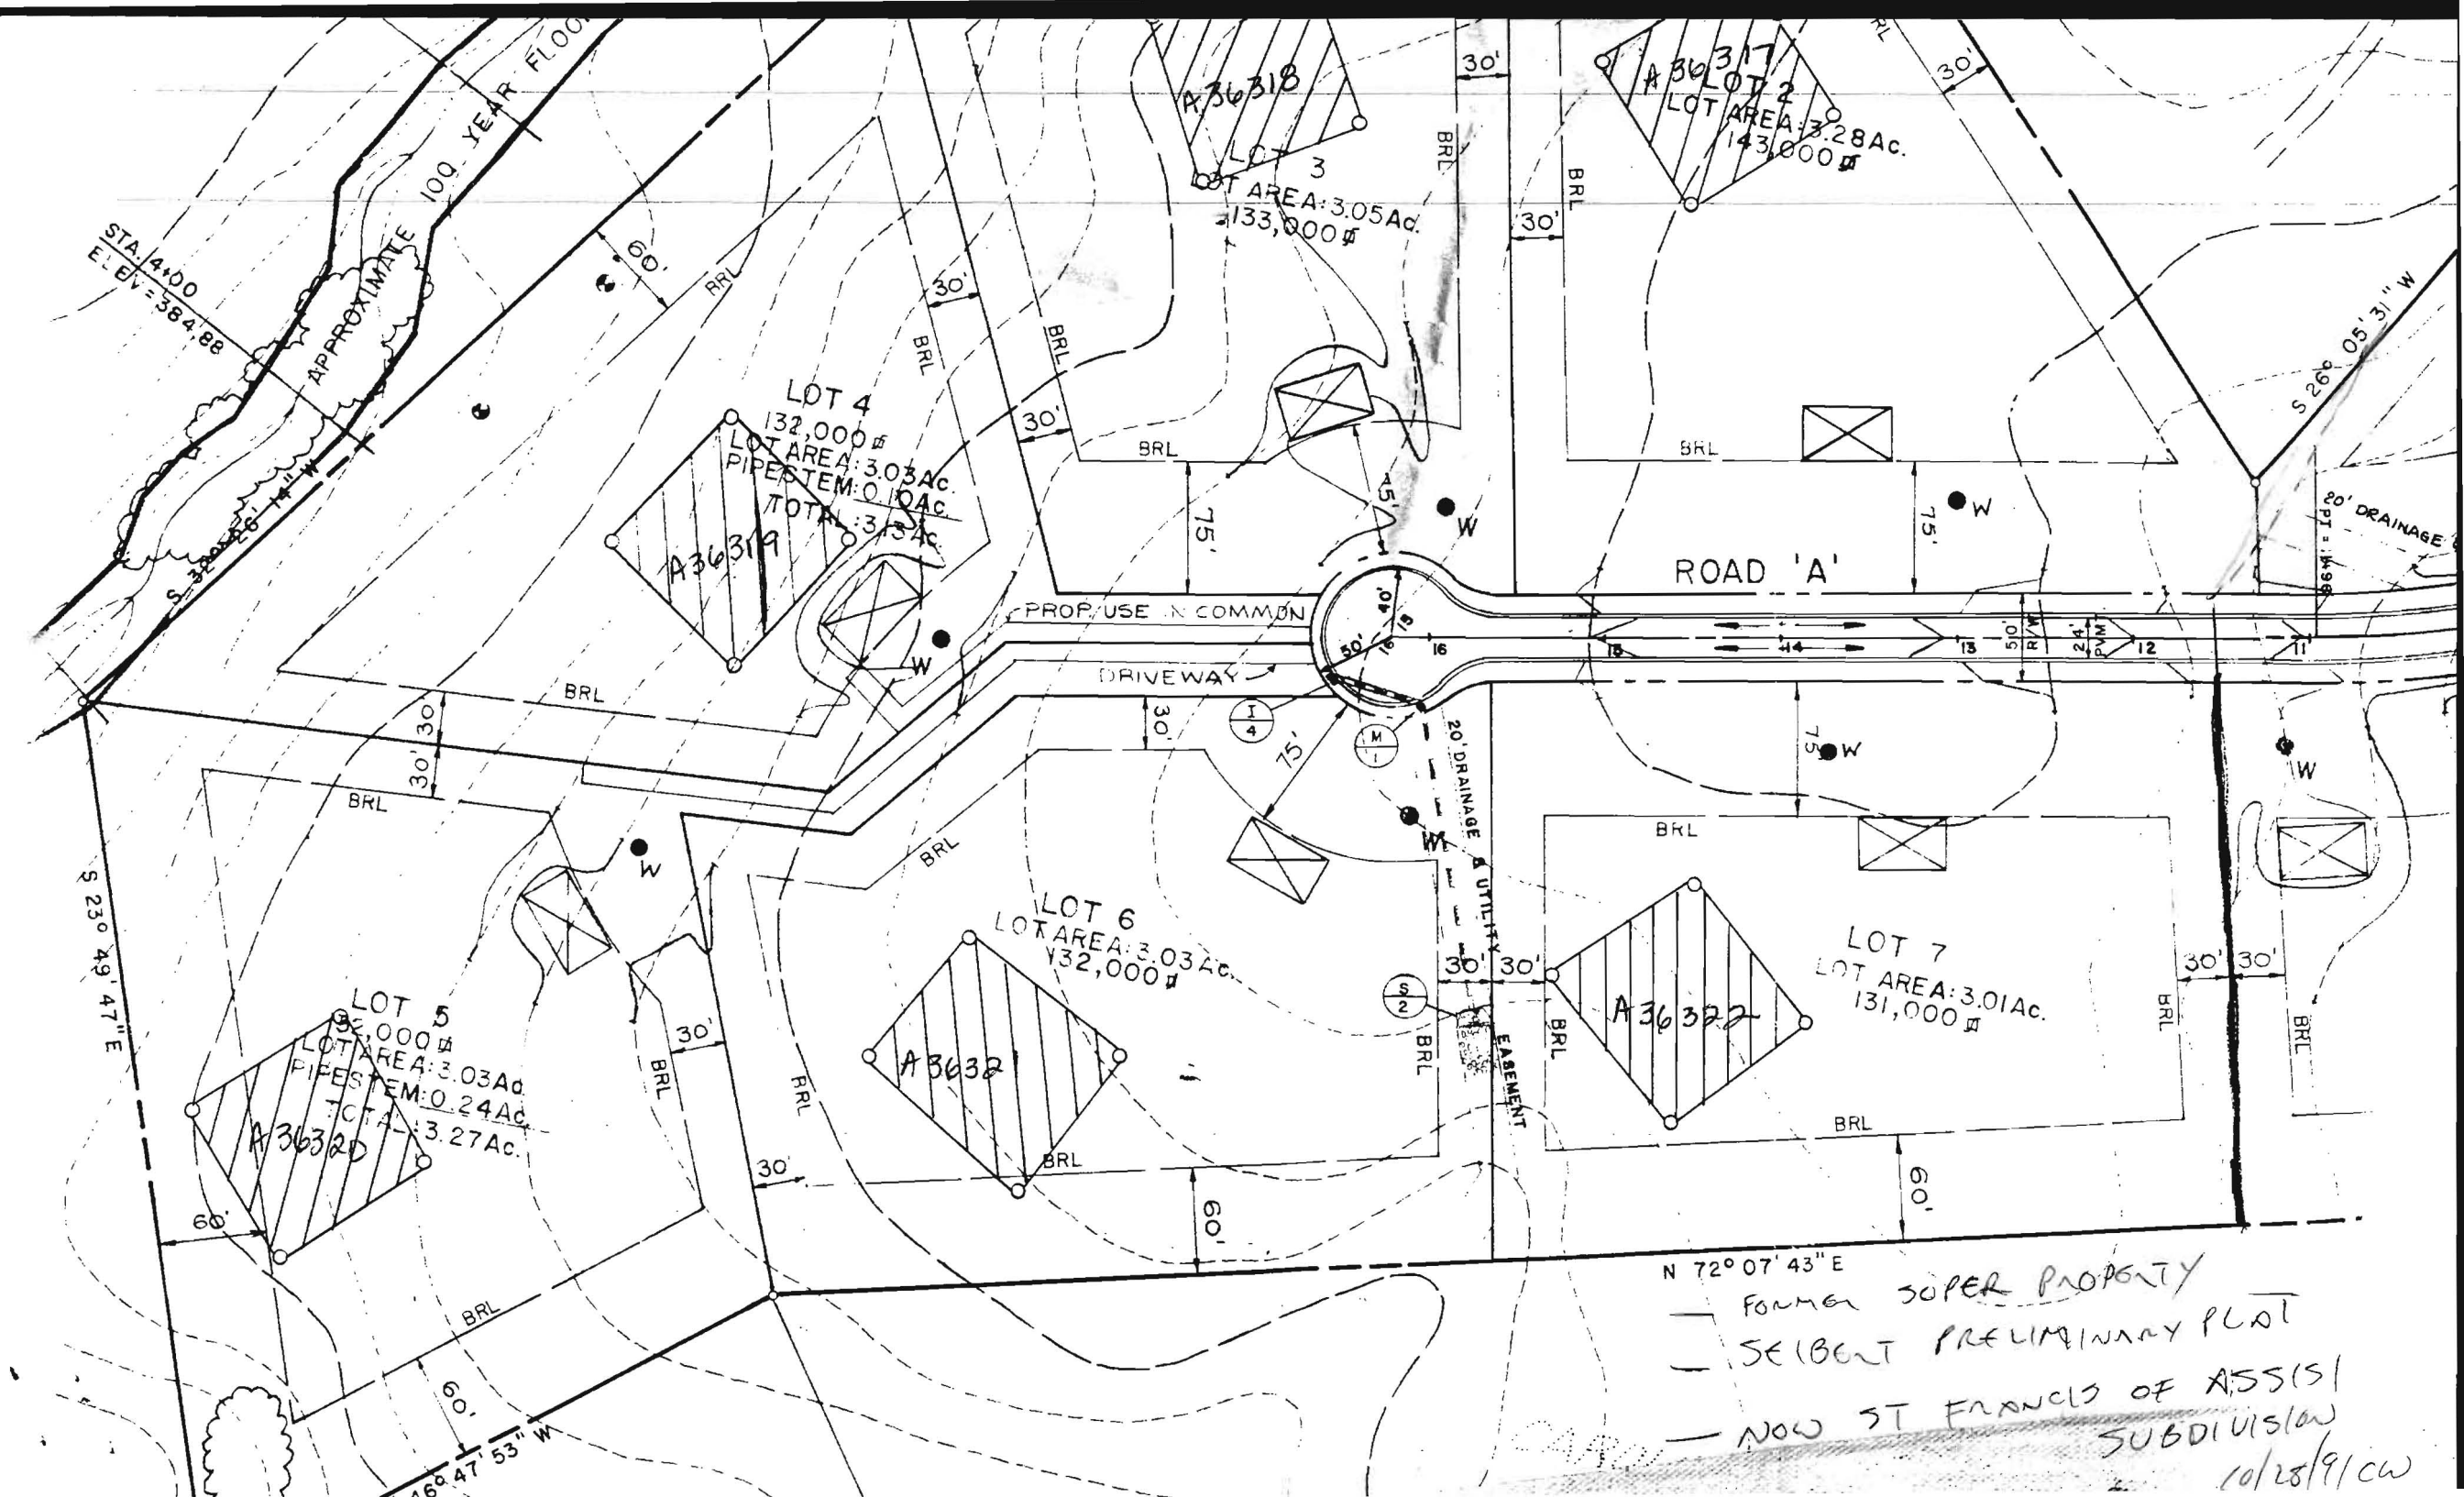

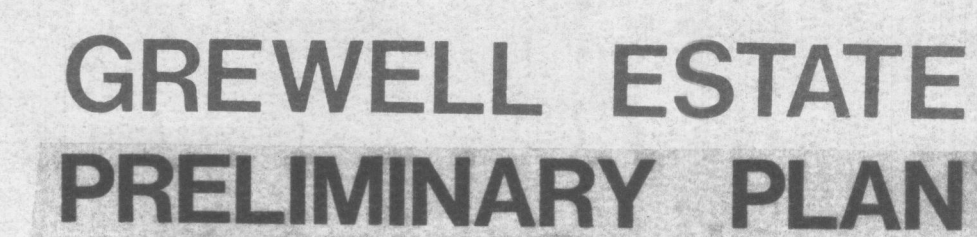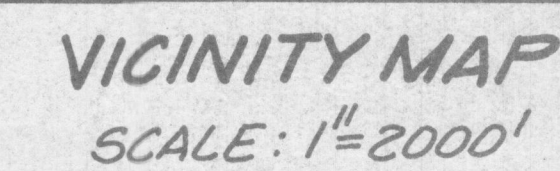

KIDDE CONSULTANTS, INC.		
DATE	REVISION	BY
SURVEYED BY COMPUTED BY DRAWN BY CHECKED BY		ENGINEERS • PLANNERS • SURVEYORS 1100 WEST STREET • SUITE 100 • LAUREL MD 20707 (Wash.) (301) 953-1821 / 792-8086 (toll)
		DATE SEPT 25, 1986 SCALE 1" = 100'

W.O. 20334C