

# APPLICATION

SEWAGE DISPOSAL TESTING

STATE OF MARYLAND - DEPARTMENT OF HEALTH AND MENTAL HYGIENE

A 36319

P \_\_\_\_\_

HOWARD COUNTY HEALTH DEPARTMENT  
ENVIRONMENTAL HEALTH SERVICES

P. O. BOX 476 ELLICOTT CITY, MARYLAND 21043  
TELEPHONE: 992-2330

DISTRICT \_\_\_\_\_

DATE Nov. 27, 1985

TO: THE COUNTY HEALTH OFFICER  
ELLICOTT CITY, MARYLAND

I, HEREBY, APPLY FOR THE NECESSARY TEST IN ORDER TO CONSTRUCT (OR RECONSTRUCT) A SEWAGE DISPOSAL SYSTEM.

PROPERTY OWNER Janet Seibert

ADDRESS 12027 Rte 216, Fulton MD. 20759 PHONE 596-0450

PROPERTY LOCATION: ~~Super/Growett Est~~ St. Francis of Assisi  
Part of Lot-2

SUBDIVISION Seibert Property LOT NO. A new 15

ROAD AND DESCRIPTION MD. Rte 216 800' ± West of Rte. 29

no road in yet to sub.

SIZE OF LOT 3.13 Ac. TYPE BLDG. Single Fam. Det 3-4  
(NUMBER OF BEDROOMS)

THE SYSTEM INSTALLED UNDER THIS APPLICATION IS ACCEPTABLE ONLY UNTIL PUBLIC FACILITIES BECOME AVAILABLE. I FULLY UNDERSTAND THE  
FEE CONNECTED WITH THE FILING OF THIS PERC TEST APPLICATION IS NON-REFUNDABLE UNDER ANY CIRCUMSTANCES. I ALSO AGREE TO COMPLY  
WITH ALL M.O.S.H.A. REQUIREMENTS IN TESTING THIS LOT.

Charles A. Puller Jr.  
(SIGNATURE OF APPLICANT)

APPROVED BY \_\_\_\_\_ FOR \_\_\_\_\_ DATE \_\_\_\_\_



REJECTED BY \_\_\_\_\_ FOR \_\_\_\_\_ DATE \_\_\_\_\_

HOLD PENDING FURTHER TESTS \_\_\_\_\_ DATE \_\_\_\_\_

REASONS FOR REJECTION OR HOLDING 12/18/85 Perc OK See Plat BH

# THIS IS NOT A PERMIT

SEE  
TEST PLAT

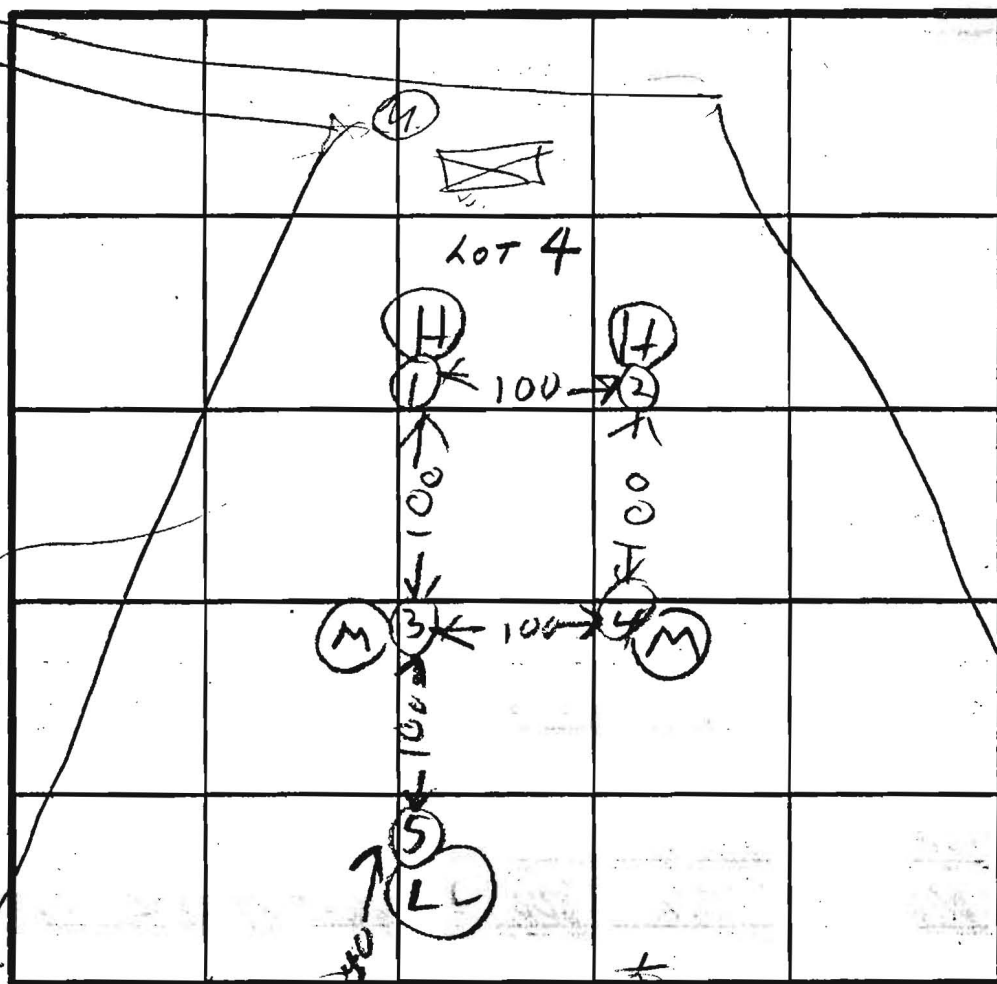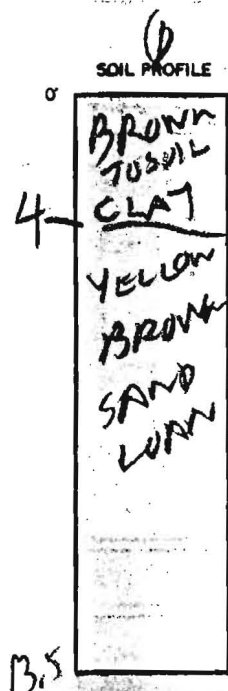

GRAY  
CLAY  
SAND  
LOAM

HOLE  
ELEVATION

HIGH = 012

MEDIUM 2 (3)

LOW = ⑤

~~INDICATE NORTH NAME ADJOINING ROADWAY AS BASE LINE~~

Fenelon Lane

| DATE  | TEST NO. | DEPTH     | PRE-WET      |            | TEST - 1" DROP |      | TIME |
|-------|----------|-----------|--------------|------------|----------------|------|------|
|       |          |           | START        | STOP       | START          | STOP |      |
| 12/18 | 13<br>1V | 4<br>13.5 | 1051<br>LOV  | 1052<br>OK | 1052<br>OK     | 1054 | 2    |
| " "   | 2V       | 12        | LOOKS OK     |            |                |      |      |
| " "   | 33<br>3V | 5<br>13.5 | 1054<br>1001 | 1100<br>OK | 1100<br>OK     | 1107 | 7    |
| " "   | 43<br>4V | 3<br>13   | 1100<br>OK   | 1102<br>OK | 1102<br>OK     | 1106 | 4    |
| " "   | 4V       | 13        | LOOKS OK     |            |                |      |      |
| " "   | 5V       | 8         | WATER        |            | 7 1/2' UNSAT   |      |      |
|       |          |           |              |            |                |      |      |
|       |          |           |              |            |                |      |      |
$\bar{x}$  per centim  
5 min

INLET 4

Bottom 9'

REMARKS

TYPE OF SOIL

R HODGES

1) FVACK

# APPLICATION

SEWAGE DISPOSAL TESTING

STATE OF MARYLAND - DEPARTMENT OF HEALTH AND MENTAL HYGIENE

A 36317

P \_\_\_\_\_

HOWARD COUNTY HEALTH DEPARTMENT  
ENVIRONMENTAL HEALTH SERVICES

P. O. BOX 476 ELLICOTT CITY, MARYLAND 21043  
TELEPHONE: 992-2330

DISTRICT \_\_\_\_\_

DATE Nov. 27, 1985

TO: THE COUNTY HEALTH OFFICER  
ELLICOTT CITY, MARYLAND

I, HEREBY, APPLY FOR THE NECESSARY TEST IN ORDER TO CONSTRUCT (OR RECONSTRUCT) A SEWAGE DISPOSAL SYSTEM.

PROPERTY OWNER Janet Seibert

ADDRESS 12027 Rte. 216, Fulton MD. 20759 PHONE 596, - 0450

PROPERTY LOCATION: Super + Grewell Est. St. Francis of Assisi  
Part of Lot-2

SUBDIVISION Seibert Property LOT NO. 2 new 13

ROAD AND DESCRIPTION MD. Rte 216, 800'± West of Rte 29

no road into sub.

SIZE OF LOT 3.28 Ac. TYPE BLDG. Single Fam. Det. 3-4  
(NUMBER OF BEDROOMS)

THE SYSTEM INSTALLED UNDER THIS APPLICATION IS ACCEPTABLE ONLY UNTIL PUBLIC FACILITIES BECOME AVAILABLE. I FULLY UNDERSTAND THE  
FEE CONNECTED WITH THE FILING OF THIS PERC TEST APPLICATION IS NON-REFUNDABLE UNDER ANY CIRCUMSTANCES. I ALSO AGREE TO COMPLY  
WITH ALL M.O.S.H.A. REQUIREMENTS IN TESTING THIS LOT.

Charles A. Pully K.C.I.  
(SIGNATURE OF APPLICANT)

APPROVED BY \_\_\_\_\_ FOR \_\_\_\_\_ DATE \_\_\_\_\_


REJECTED BY \_\_\_\_\_ FOR \_\_\_\_\_ DATE \_\_\_\_\_

HOLD PENDING FURTHER TESTS \_\_\_\_\_ DATE \_\_\_\_\_

REASONS FOR REJECTION OR HOLDING 12/12/85 Perc OK Hold for Plat B/H

# THIS IS NOT A PERMIT

See Test Plant Lot

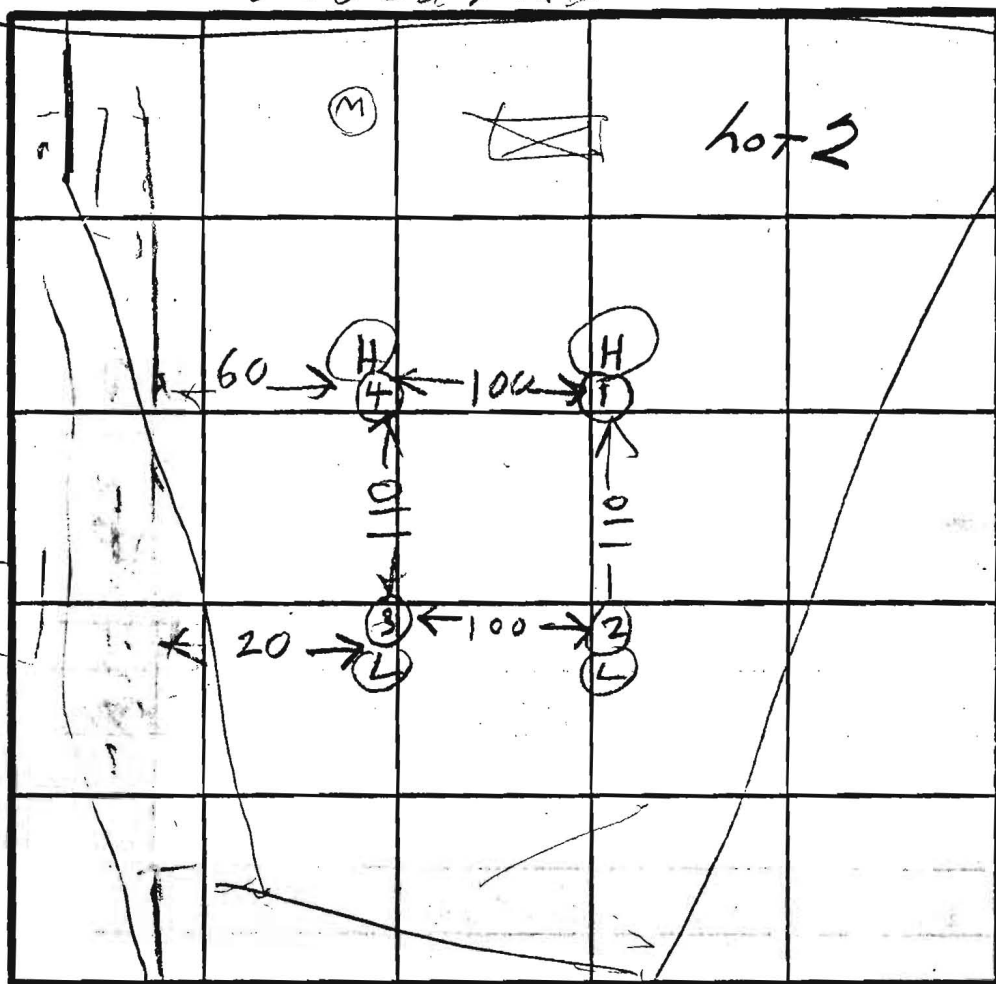

INDICATE NORTH - NAME ADJOINING ROADWAY AS BASE LINE.

[illegible]

REMARKS

TYPE OF SOIL

VII/Holer dug per suruyn  
stop

D HALL

1 EVOLK



# APPLICATION

SEWAGE DISPOSAL TESTING

STATE OF MARYLAND - DEPARTMENT OF HEALTH AND MENTAL HYGIENE

A 36321

P \_\_\_\_\_

HOWARD COUNTY HEALTH DEPARTMENT  
ENVIRONMENTAL HEALTH SERVICES

P. O. BOX 476 ELLICOTT CITY, MARYLAND 21043  
TELEPHONE: 992-2330

DISTRICT \_\_\_\_\_

DATE Nov. 27, 1985

TO: THE COUNTY HEALTH OFFICER  
ELLICOTT CITY, MARYLAND

I, HEREBY, APPLY FOR THE NECESSARY TEST IN ORDER TO CONSTRUCT (OR RECONSTRUCT) A SEWAGE DISPOSAL SYSTEM.

PROPERTY OWNER Janet Seibert

ADDRESS 12027 Rte 216, Fulton MD. 20759 PHONE 596-0450

PROPERTY LOCATION: super / Grawett Est. St. Francis of Assisi

SUBDIVISION Seibert Property LOT NO. 6 new 17<sup>new</sup> 2

ROAD AND DESCRIPTION Rte. 216 800' ± West of Rte 29  
no road into subdivision

SIZE OF LOT 3.03 Ac. TYPE BLDG. Single Fam. Det 3-4  
(NUMBER OF BEDROOMS)

THE SYSTEM INSTALLED UNDER THIS APPLICATION IS ACCEPTABLE ONLY UNTIL PUBLIC FACILITIES BECOME AVAILABLE. I FULLY UNDERSTAND THE  
FEE CONNECTED WITH THE FILING OF THIS PERC TEST APPLICATION IS NON-REFUNDABLE UNDER ANY CIRCUMSTANCES. I ALSO AGREE TO COMPLY  
WITH ALL M.O.S.H.A. REQUIREMENTS IN TESTING THIS LOT.

Charles A. Phillips KCI  
(SIGNATURE OF APPLICANT)

APPROVED BY \_\_\_\_\_ FOR \_\_\_\_\_ DATE \_\_\_\_\_

REJECTED BY \_\_\_\_\_ FOR \_\_\_\_\_ DATE \_\_\_\_\_

HOLD PENDING FURTHER TESTS \_\_\_\_\_ DATE \_\_\_\_\_

REASONS FOR REJECTION OR HOLDING 12/18/85 - Perc OK Submit Certified Plat R/H

# THIS IS NOT A PERMIT

BOARD A

⑦

### SOIL PROFILE

BROWN  
CLAY

PINK  
BROWN  
SAND  
LOAM

④

DX-100-2

14

2

1001

1001 米

4

(L)

⑤

HOLE  
ELEVATION

① ② HIGH  
③ ④ LOW

000

INDICATE NORTH - NAME ADJOINING ROADWAY AS BASE LINE

BROWN  
CLAY  
STOPAL

PINK  
8  
BROWN  
SAND  
HARD

[illegible]

See text  
Plat

$\bar{x}$  Arc Time

10 min

INLET 5

Bottom 9'

01 000000

ARON CUN

PINK  
BROWN  
SAND  
LOAM

REMARKS

TYPE OF SOIL

RHODGES

SKIP

# APPLICATION

SEWAGE DISPOSAL TESTING

STATE OF MARYLAND - DEPARTMENT OF HEALTH AND MENTAL HYGIENE

A 36322

P \_\_\_\_\_

HOWARD COUNTY HEALTH DEPARTMENT  
ENVIRONMENTAL HEALTH SERVICES

P. O. BOX 476 ELLICOTT CITY, MARYLAND 21043  
TELEPHONE: 992-2330

DISTRICT \_\_\_\_\_

DATE Nov. 27, 1985

TO: THE COUNTY HEALTH OFFICER  
ELLICOTT CITY, MARYLAND

I, HEREBY, APPLY FOR THE NECESSARY TEST IN ORDER TO CONSTRUCT (OR RECONSTRUCT) A SEWAGE DISPOSAL SYSTEM.

PROPERTY OWNER Janet Seibert

ADDRESS 12027 Rte 216, Fulton MD. 20759 PHONE 596-0450

PROPERTY LOCATION: ~~Super/Greene Est.~~ St. Francis of Assisi  
Seibert Property Part of Lot-2

SUBDIVISION \_\_\_\_\_ LOT NO. 7 new 18

ROAD AND DESCRIPTION Rte 216, 800'± West of Rte 29  
no road into sub.

SIZE OF LOT 3.01 Ac. TYPE BLDG. Single Fam. Det. 3-4  
(NUMBER OF BEDROOMS)

THE SYSTEM INSTALLED UNDER THIS APPLICATION IS ACCEPTABLE ONLY UNTIL PUBLIC FACILITIES BECOME AVAILABLE. I FULLY UNDERSTAND THE  
FEE CONNECTED WITH THE FILING OF THIS PERC TEST APPLICATION IS NON-REFUNDABLE UNDER ANY CIRCUMSTANCES. I ALSO AGREE TO COMPLY  
WITH ALL M.O.S.H.A. REQUIREMENTS IN TESTING THIS LOT.

Charles A. Phillips Jr.  
(SIGNATURE OF APPLICANT) KCI

APPROVED BY \_\_\_\_\_ FOR \_\_\_\_\_ DATE \_\_\_\_\_


REJECTED BY \_\_\_\_\_ FOR \_\_\_\_\_ DATE \_\_\_\_\_

HOLD PENDING FURTHER TESTS \_\_\_\_\_ DATE \_\_\_\_\_

REASONS FOR REJECTION OR HOLDING 12/18/85 - PERC OK HOLD FOR PLAT B/H

# THIS IS NOT A PERMIT

Lat 7

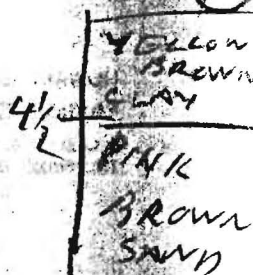

13

Hold

ELEVATION

④  
③ = 4.0057

① = Low

② = MEDIO

$\bar{x}$  Perc Time  
2 min

INLET 4'

Bottom 9

INDICATE NORTH - NAME ADJOINING ROADWAY AS BASE LINE

[illegible]

REMARKS

Holes Per Testing Plat

TYPE OF SOIL

011011

Exotic

| COORDINATE CHART |            |            |
|------------------|------------|------------|
| NO.              | NORTHING   | EASTING    |
| 1                | 478,114.39 | 825,920.54 |
| 2                | 478,109.13 | 825,939.83 |
| 3                | 478,109.08 | 825,966.12 |
| 9                | 477,130.87 | 825,871.70 |
| 12               | 477,426.96 | 825,732.41 |
| 13               | 477,562.07 | 825,783.12 |
| 14               | 477,678.29 | 825,770.31 |
| 19               | 476,862.36 | 825,141.80 |
| 20               | 476,585.15 | 824,913.21 |
| 21               | 477,217.91 | 824,654.36 |
| 22               | 477,635.67 | 824,976.13 |
| 23               | 477,815.16 | 825,229.32 |
| 24               | 477,472.69 | 825,744.87 |


| CURVE DATA |         |        |           |         |        |               |
|------------|---------|--------|-----------|---------|--------|---------------|
| NO.        | RADIUS  | LENGTH | DELTA     | TANGENT | CHORD  | CHORD BEARING |
| 13-14      | 175.00' | 91.67' | 30°00'53" | 46.92'  | 90.63' | S 34°01'10" W |

NOTE: COORDINATES SHOWN HEREIN ARE BASED ON THE MARYLAND STATE PLANE COORDINATE GRID SYSTEM AS ESTABLISHED BY HOWARD COUNTY CONTROL STATION NOS. 2028001 AND 2030001

FILED NOV 7 1991

SUPER PROPERTY  
PLAT NO. 4382  
LOT 8

PLAT-M.D.R. NO. 10126

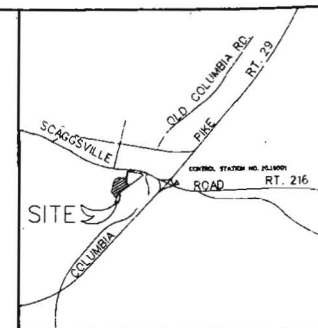


VICINITY MAP SCALE: 1" = 2000'

### LEGEND

- INDICATES IRON PIPE OR BAR SET
- INDICATES CONCRETE MONUMENT SET
- INDICATES SOIL PERC. TEST

STATE OF MARYLAND  
DEPARTMENT OF ASSESSMENTS & TAXATION  
COUNTY OF BALTIMORE  
Received by  
*Bonnie Best-Lee*  
DATE: 11/7/91 PLAT:

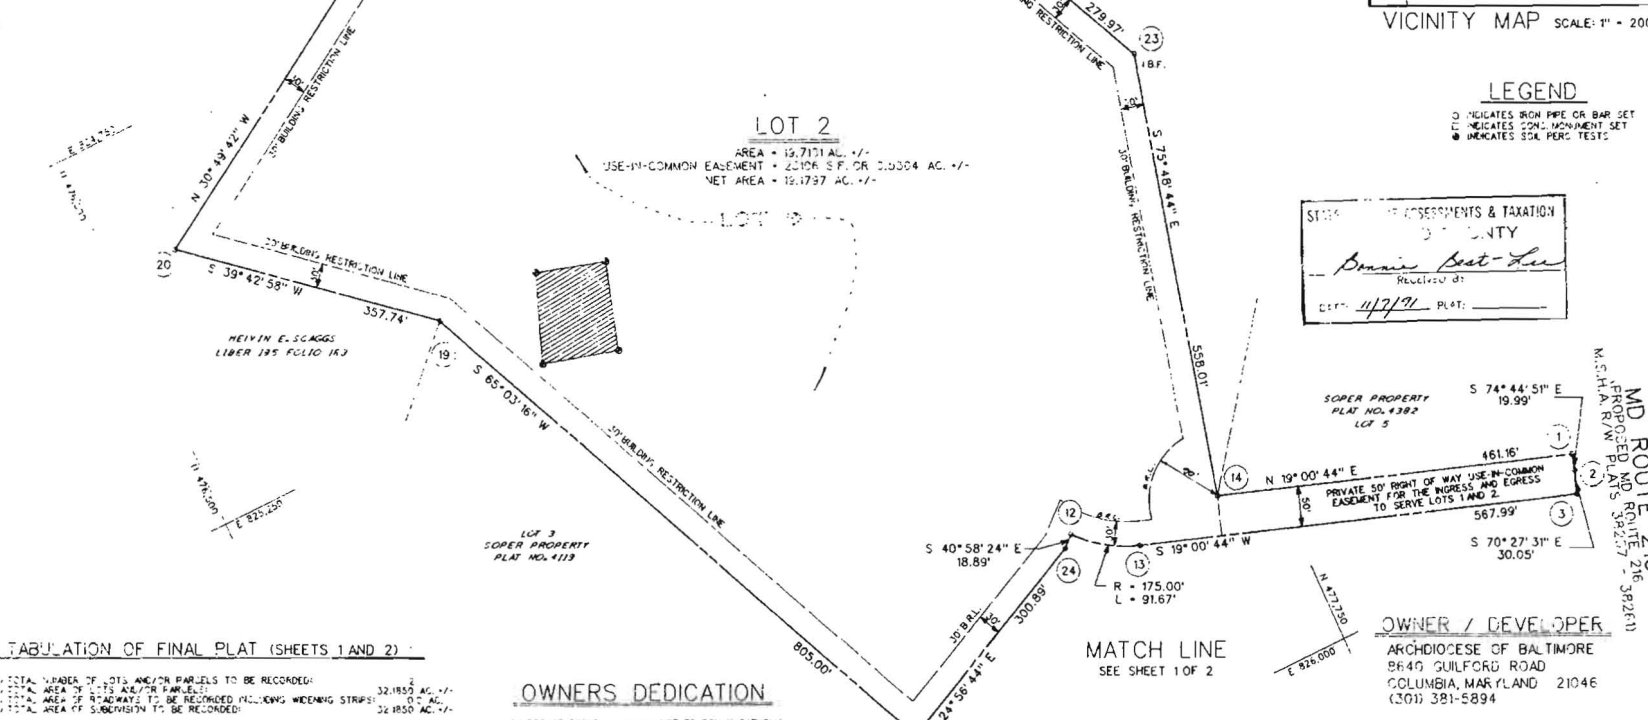

### TABULATION OF FINAL PLAT (SHEETS 1 AND 2)

- 1. TOTAL NUMBER OF LOTS AND/OR PARCELS TO BE RECORDED: 2
- 2. TOTAL AREA OF LOTS AND/OR PARCELS: 32,185.22 AC. +/-
- 3. TOTAL AREA OF HIGHWAYS TO BE RECORDED INCLUDING WIDENING STRIPS: 0.00 AC. +/-
- 4. TOTAL AREA OF SUBDIVISION TO BE RECORDED: 32,185.22 AC. +/-

### TABULATION OF FINAL PLAT (THIS SHEET ONLY)

- 1. TOTAL NUMBER OF LOTS AND/OR PARCELS TO BE RECORDED: 1
- 2. TOTAL AREA OF LOTS AND/OR PARCELS: 19,713.11 AC. +/-
- 3. TOTAL AREA OF HIGHWAYS TO BE RECORDED INCLUDING WIDENING STRIPS: 0.00 AC. +/-
- 4. TOTAL AREA OF SUBDIVISION TO BE RECORDED: 19,713.11 AC. +/-

APPROVED: FOR PRIVATE WATER AND PRIVATE SEWAGE SYSTEMS  
HOWARD COUNTY HEALTH DEPARTMENT

APPROVED: FOR STORM DRAINAGE SYSTEMS AND PUBLIC ROADS  
HOWARD COUNTY DEPARTMENT OF PLANNING AND ZONING

APPROVED: FOR STORM DRAINAGE SYSTEMS AND PUBLIC ROADS  
HOWARD COUNTY DEPARTMENT OF PUBLIC WORKS

### OWNERS DEDICATION

I, MOST REVEREND WILLIAM H. KEELER, ROMAN CATHOLIC ARCHBISHOP OF BALTIMORE, A CORPORATION SOLE, OWNER OF THE PROPERTY SHOWN AND DESCRIBED HEREON HEREBY ADOPT THIS PLAN OF SUBDIVISION, AND IN CONSIDERATION OF THE APPROVAL OF THIS FINAL PLAT BY THE DEPARTMENT OF PLANNING AND ZONING, ESTABLISH THE BOUNDARY BUILDING RESTRICTION LINES AND GRANT UNTO HOWARD COUNTY, MARYLAND, ITS SUCCESSORS AND ASSIGNS, THE RIGHT TO LAY, CONSTRUCT, AND MAINTAIN SEWERS, DRAINAGE, WATER PIPES AND MUNICIPAL UTILITIES AND SERVICES, IN AND UNDER ALL ROADS AND STREET RIGHT-OF-WAYS AND THE SPECIFIC EASEMENT AREAS SHOWN HEREON; 2) THE RIGHT TO REQUIRE DEDICATION FOR PUBLIC USE OF THE BEDS OF THE STREETS AND/OR ROADS AND FLOODPLAINS AND OPEN SPACE WHERE APPLICABLE, AND FOR GOOD AND OTHER VALUABLE CONSIDERATION HEREBY GRANT THE RIGHT AND OPTION TO HOWARD COUNTY TO ACQUIRE THE FEE SIMPLE TITLE TO THE BEDS OF THE STREETS AND/OR ROADS AND FLOODPLAINS, STORM DRAINAGE FACILITIES AND OPEN SPACE WHERE APPLICABLE; 3) THE RIGHT TO REQUIRE DEDICATION OF WATERWAYS AND DRAINAGE EASEMENTS FOR THE SPECIFIC PURPOSE OF THEIR CONSTRUCTION, REPAIR AND MAINTENANCE; AND 4) THAT NO BUILDING OR SIMILAR STRUCTURE OF ANY KIND SHALL BE ERECTED ON OR OVER SAID EASEMENTS AND RIGHTS-OF-WAY.

WITNESS MY HAND THIS 11 DAY OF JUNE 1991  
MOST REVEREND WILLIAM H. KEELER  
DATE: 6/11/91  
DATE: 6/11/91

### SURVEYORS CERTIFICATE

I HEREBY CERTIFY THAT THE FINAL PLAT SHOWN HEREON IS CORRECT; THAT IT IS A RESUBDIVISION OF LOT 9, AS SHOWN ON A PLAT OF SUBDIVISION ENTITLED "LOT 9, S. B. & S. SUPER PROPERTY" AS RECORDED AMONG THE LAND RECORDS OF HOWARD COUNTY, MARYLAND, AS PLAT C.M.P. NO. 4382 AND BEING ALL OF THE LANDS CONVEYED BY MARTIN L. GOSSMAN MORTGAGE ASSIGNEE TO MOST REVEREND WILLIAM H. KEELER, ROMAN CATHOLIC ARCHBISHOP OF BALTIMORE BY DEED DATED MARCH 18, 1991 AND RECORDED AMONG THE AFORESAID LAND RECORDS IN DEED LIBER 2300 AT FOLIO 373 AND THAT ALL MONUMENTS ARE IN PLACE OR WILL BE IN PLACE PRIOR TO THE ACCEPTANCE OF THE STREETS IN THE SUBDIVISION BY HOWARD COUNTY AS SHOWN IN ACCORDANCE WITH THE ANNOTATED CODE OF MARYLAND, AS AMENDED.

CHARLES A. PHILLIPS, JR.  
PROPERTY LINE SURVEYOR  
MD REG NO. 463  
DATE: 11/7/91

OWNER / DEVELOPER  
ARCHDIOCESE OF BALTIMORE  
8640 GUILFORD ROAD  
COLUMBIA, MARYLAND 21046  
(301) 381-5894

## ST. FRANCIS OF ASSISI SUBDIVISION

A RESUBDIVISION OF LOT 9 "SUPER PROPERTY", PLAT 4382

TAX MAP 46 PARCEL 337 5TH ELECTION DISTRICT  
HOWARD COUNTY, MARYLAND

SCALE: 1" = 100' DATE: DECEMBER, 1990 SHEET 2 OF 2

KCI TECHNOLOGIES, INC.  
SURVEYORS ENGINEERS PLANNERS

13992 BALTIMORE AVENUE  
LAUREL, MARYLAND 20707  
BALT. (301) 792-8558 WASH. (301) 953-1821  
KCI NO. 1690050

massway-2012-247-82 11/7/91



THIS PRINT

FEB 04 1987

MADE

No signature  
Submitted by contractor.

# GREWELL ESTATE PRELIMINARY PLAN

## PERCOLATION TESTS

4 FEB. 1987

### KIDDE CONSULTANTS, INC.


| DATE | REVISION | BY |
|------|----------|----|
|      |          |    |
|      |          |    |
| ENGINEERS • PLANNERS • SURVEYORS             |               |
|----------------------------------------------|---------------|
| 100 WEBB STREET, SUITE 200, LAUREL, MD 20701 |               |
| Tel: (301) 953-1881 Fax: (301) 953-1882      |               |
| DATE                                         | SEPT 25, 1986 |
| SCALE                                        | 1"=100'       |

J.O. 1685104

WD 20334C



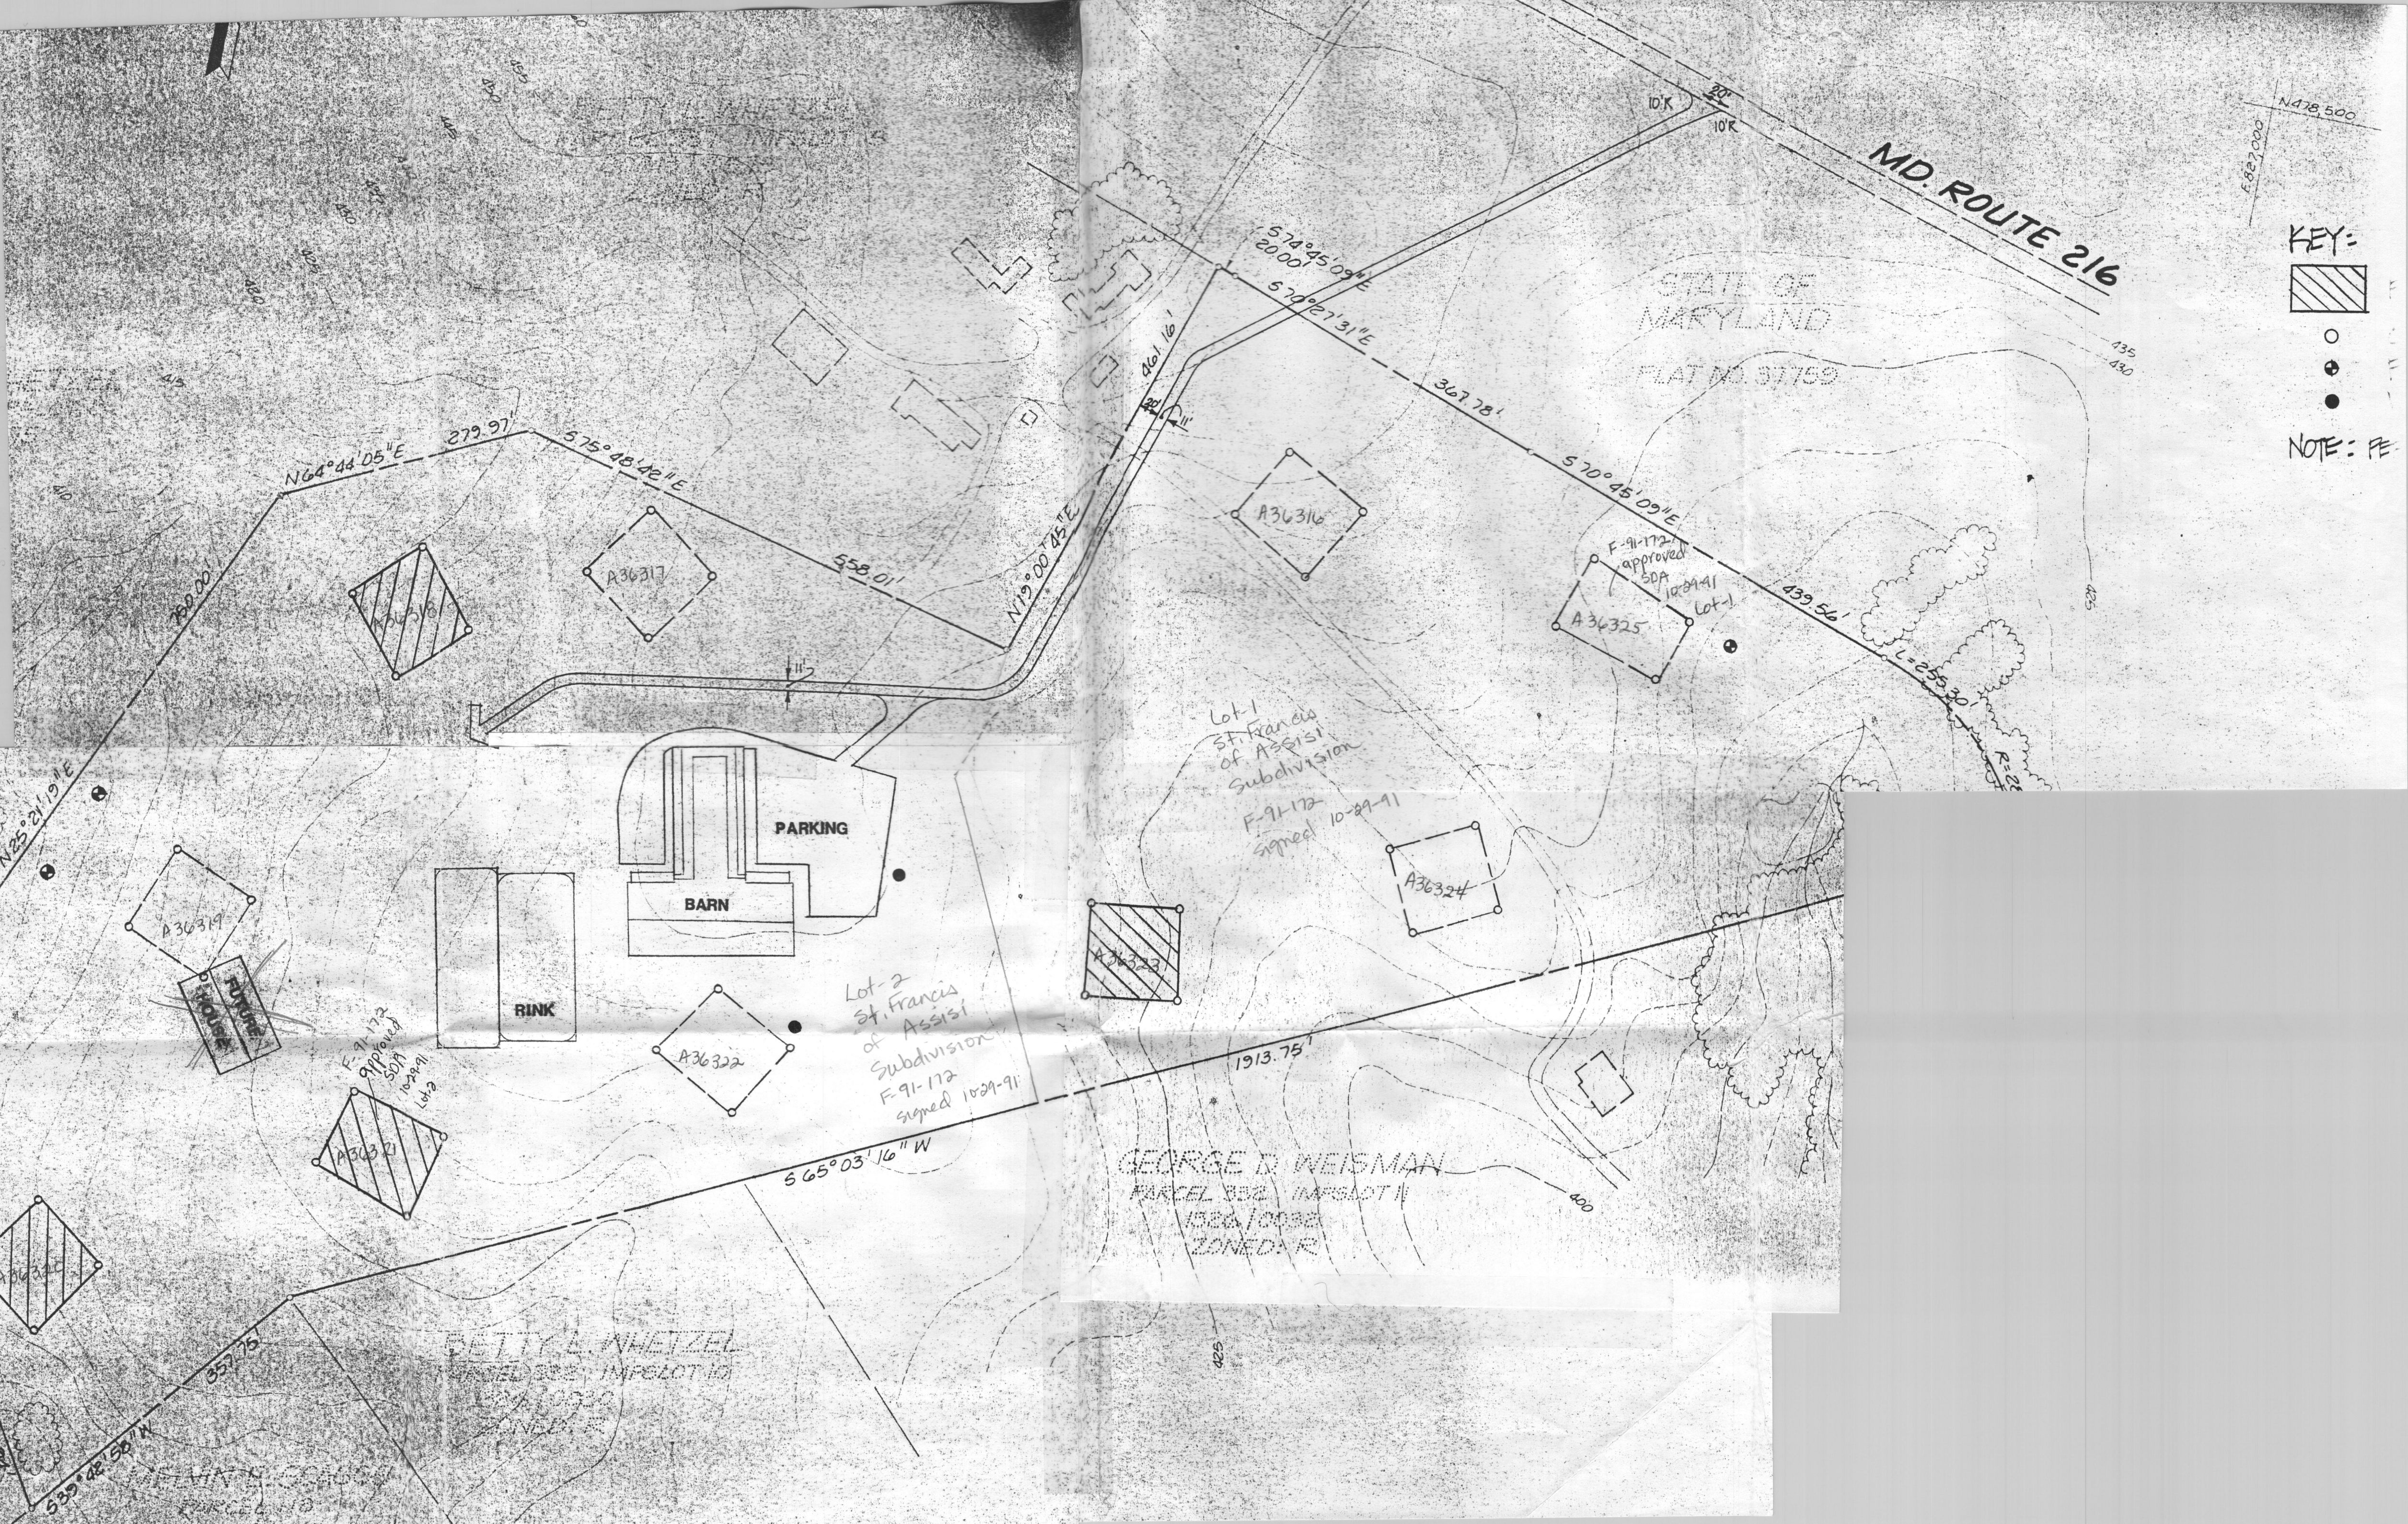




LEGEND

House
10,000+ Septic Area
Well

| CURVE DATA |        |      |         |
|------------|--------|------|---------|
| Δ          | R      | T    | L       |
| 49°        | 702.17 | 320' | 600.50' |

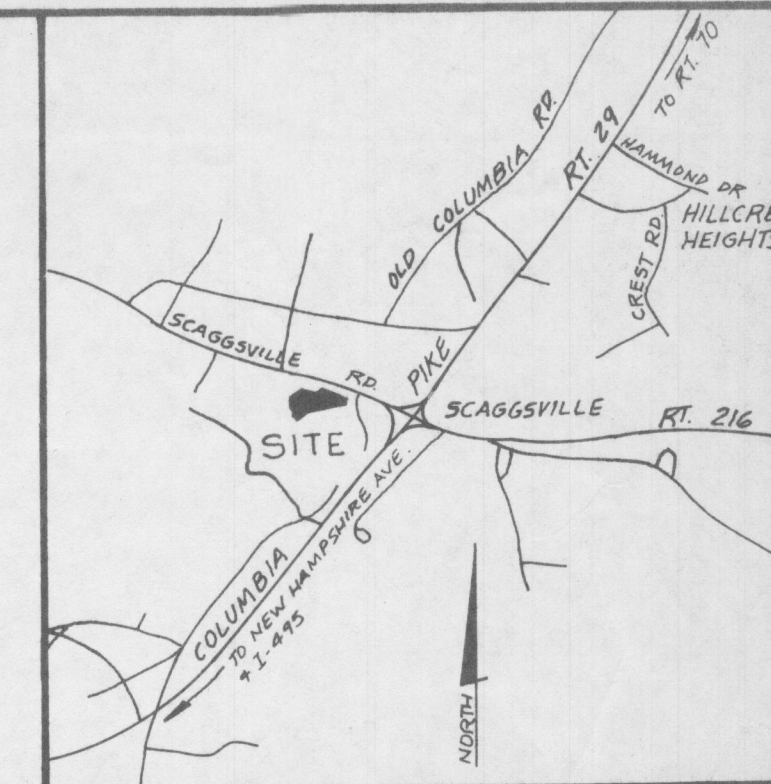

VICINITY MAP  
SCALE : 1" = 2000'

1) Farnleigh Estates (not approved)  
2) Judith Grewell (current owner)

SUMMARY

|                         |                    |
|-------------------------|--------------------|
| TAX MAP NUMBER          | 49                 |
| PARCEL NUMBER           | P3 37 IMPSLOT 9    |
| EXISTING ZONING         | R DISTRICT (RURAL) |
| TRACT AREA              | 32.179 ACRES       |
| NUMBER OF PROPOSED LOTS | 10                 |

PROPOSED LOT REQUIREMENTS

|                                                   |         |
|---------------------------------------------------|---------|
| A. MINIMUM LOT SIZE                               | 3 ACRES |
| B. MINIMUM LOT WIDTH AT BUILDING RESTRICTION LINE | 200'    |

- GENERAL NOTES
- PRELIMINARY BOUNDARY BY CLAUDE M.SKINNER, JR.
  - TOPO BY HOWARD COUNTY.
  - PROPERTY ACREAGE AND OUTLINE ARE SUBJECT TO FINAL SURVEY AND COMPUTATION.
  - TOPO SHOWN IS SUBJECT TO FIELD VERIFICATION.
  - PLANS SUBJECT TO S-85-03,AUG.6,1985.
  - AREA OF LOTS=
  - AREA OF PUBLIC ROAD=
  - PROPOSED WATER & SEWER SYSTEM TO BE PRIVATE WELL & SEPTIC.

PERC HOLE STAKEOUT  
WITH ALTERNATE HOLE LOCATIONS  
PRELIMINARY PLAN  
**SEIBERT PROPERTY**  
5TH ELECTION DISTRICT  
HOWARD COUNTY, MARYLAND

SHEET 1 OF 1

Perc Table

| Lot #   | Bottom Max. Depth | Max. Inlet Depth | Avg. Perc Time |
|---------|-------------------|------------------|----------------|
| Lot #1  | 9 ft.             | 3                | 5 min.         |
| Lot #2  | 9 ft.             | 3                | 3 min.         |
| Lot #3  | 9 ft.             | 3                | 1 min.         |
| Lot #4  | 9 ft.             | 4                | 5 min.         |
| Lot #5  | 9 ft.             | 4                | 3 min.         |
| Lot #6  | 9 ft.             | 5                | 10 min.        |
| Lot #7  | 9 ft.             | 4                | 2 min.         |
| Lot #8  | 9 ft.             | 3                | 2 min.         |
| Lot #9  | 9 ft.             | 3                | 3              |
| Lot #10 | 9 ft.             | 3                | 3              |

OWNER  
JANET SEIBERT  
12027 ROUTE 216  
FULTON, MARYLAND 20759

APPROVED: FOR PRIVATE WATER AND PRIVATE SEWERAGE SYSTEMS, HOWARD COUNTY HEALTH DEPARTMENT

|                                                                                                                                     |      |
|-------------------------------------------------------------------------------------------------------------------------------------|------|
| COUNTY HEALTH OFFICER                                                                                                               | DATE |
| APPROVED: HOWARD COUNTY OFFICE OF PLANNING & ZONING                                                                                 |      |
| DIRECTOR                                                                                                                            | DATE |
| CHIEF DIVISION OF LAND DEVELOPMENT AND ZONING ADMINISTRATION                                                                        | DATE |
| APPROVED: FOR PRIVATE WATER AND PRIVATE SEWERAGE, STORM DRAINAGE SYSTEMS AND PUBLIC ROADS, HOWARD COUNTY DEPARTMENT OF PUBLIC WORKS |      |
| DIRECTOR                                                                                                                            | DATE |
| CHIEF BUREAU OF ENGINEERING                                                                                                         | DATE |

KIDDE CONSULTANTS, INC.

ENGINEERS, LAND PLANNERS & SURVEYORS

8101 SANDY SPRING ROAD / LAUREL, MD. 20707  
(301) 725-0665 / 792-6086

DATE: \_\_\_\_\_

SCALE 1" = 100'