

# APPLICATION

SEWAGE DISPOSAL TESTING

MARYLAND STATE DEPARTMENT OF HEALTH

HOWARD COUNTY

ELLICOTT CITY

DISTRICT 5

DATE 7/13/72

A 17209

P \_\_\_\_\_

TO: THE COUNTY HEALTH OFFICER  
ELLICOTT CITY, MARYLAND

I, HEREBY, APPLY FOR THE NECESSARY TESTS IN ORDER TO CONSTRUCT (OR RECONSTRUCT) A SEWAGE DISPOSAL SYSTEM.

PROPERTY OWNER Anne Kondrup Gray

ADDRESS Reservoir Road, Fulton, Md.

Any questions call Mr.  
Clarkson Bell, 776-7075

PHONE \_\_\_\_\_

PROPERTY LOCATION:

SUBDIVISION Beaufort Park

LOT NO. 1, Blk. B, Sect. 4-A

ROAD AND DESCRIPTION Reservoir Road

OCCUPANT \_\_\_\_\_

PHONE \_\_\_\_\_

PERSON TO CONSTRUCT SYSTEM \_\_\_\_\_

ADDRESS \_\_\_\_\_

PHONE \_\_\_\_\_

SIZE OF LOT 55,000 sq. ft.

TYPE BLDG. 3 or 4 bedrooms  
NUMBER OF BEDROOMS

IF NOT SINGLE RESIDENCE DESCRIBE \_\_\_\_\_

SIGNATURE OF APPLICANT /s/ Anne Kondrup Gray

APPROVED BY \_\_\_\_\_

FOR \_\_\_\_\_

(KIND OF SYSTEM)

DATE \_\_\_\_\_

REJECTED BY \_\_\_\_\_

FOR \_\_\_\_\_

(KIND OF SYSTEM)


DATE \_\_\_\_\_

HOLD PENDING FURTHER TESTS \_\_\_\_\_

DATE \_\_\_\_\_

REASONS FOR REJECTION OR HOLDING \_\_\_\_\_

## THIS IS NOT A PERMIT

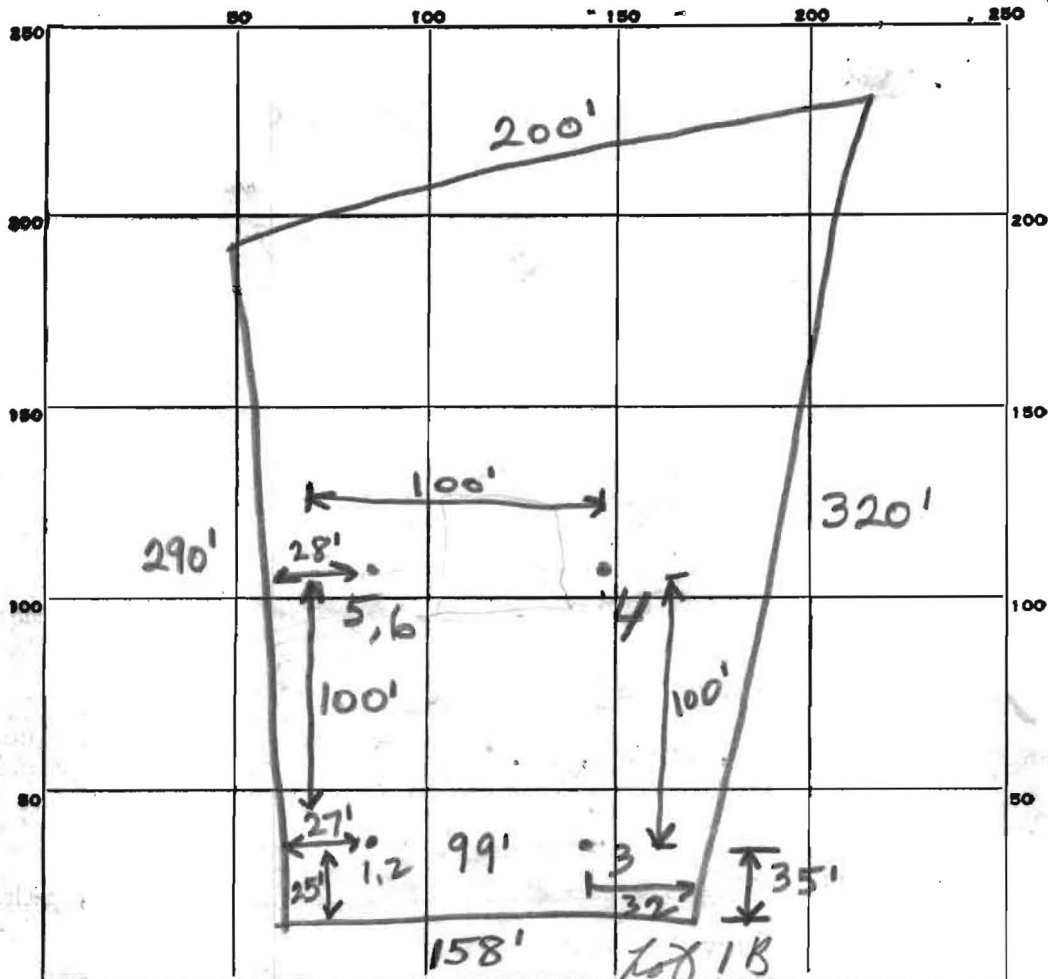

INDICATE NORTH. - NAME ADJOINING ROADWAY AS BASE LINE.

Reservoir Road

| DATE | TEST NO. | DEPTH                       | PRE-WET   |       | TEST - 1" DROP |       | TIME |
|------|----------|-----------------------------|-----------|-------|----------------|-------|------|
|      |          |                             | START     | STOP  | START          | STOP  |      |
| 8/23 | 121      | 5'                          | 10:10     | 10:10 | 10:10          | 10:11 | 1    |
|      | 2        | 11'                         | 10:10     | 10:11 | 10:11          | 10:13 | 2    |
|      | 3        | TOP 3' Clayish<br>Bottom 8' | Good soil |       | Dry            |       |      |
|      | 4        | TOP 4' Clayish<br>Bottom 7' | Good soil |       | Dry            |       |      |
|      | 5        | 4'                          | 10:17     | 10:17 | 10:17          | 10:18 | 1    |
|      | 6        | 10 1/2'                     | 10:17     | 10:24 | 10:24          | 10:27 | 6    |
|      |          |                             |           |       |                |       |      |
|      |          |                             |           |       |                |       |      |
2 1/2" min  
air

SOIL AUGER FINDING

TESTED BY

REMARKS

Dry well (4)  
4' inlet