Permits: 410-313-2455 Inspections: 410-313-1810 Automated Line: 41.0-313-3800 Howard County Building/Fire Permit Application Department of Inspections, Licenses & Permits 3430 Court House Drive

Permit Number:

Ellicott City, MD 21043

		AT.	Tiche of Minter	
Building Address: 3000	opus prine,		Ichael Antone	-
West Exiences	w Md 21784	Address: 3000 3060	15 PK	7
		city: West Friendstipst	ate: MD Zip Code: 2/794	-
Suite/Apt. #Census Tract:	Subdivision Dahas	TOLOS Home Phone: 410- 489-51	121_ Work Phone: 410.458-1145	<u>. </u>
Census Tract:	Subdivisions	Applicant's Name & Mailing Ad	ddress, (If other than stated herein):	
Section:	Area: Lot:	0216		_
Tax Map: 6019 Pa	rcel: COCC Grid: Co			
Zoning: Map Coo	rdinates: Lot Size	Phone:	Re & Checizon, wet	-
Existing Use:				
Proposed Use: Single Face	ely Duelling	Contractor Company: A Ou	14 DOINGES TOC	-
Estimated Construction Cost: \$		Contact Person: MBUK Address: 1123 E. FUN	wood be with Act	-
Description of Work: //VS77		City Coler Delive State	e: Ma Zip Code: 2/040	_
48" 1 ENCE		License No.: 45377	6310	
7.0		Phone: 40-166-1710	Fax: 410-74697	_
Occupant or Topant:		Email: Nounga (E	MCRSt, Net	
Occupant or Tenant: Was tenant space previously occu		□No Engineer/Architect Company:		_
20				
Contact Name:				_
Address:		Address:		
City:		1 1	e: Zip Code:	
Phone:	Fax:	Phone:	Fax:	
Email:		Email:		_
BUILDING DE	SCRIPTION - COMMERCIAL	BUILDING D	DESCRIPTION – RESIDENTIAL	
Building Characteristics	Utilities	Building Characteristics		
Height:	Water Supp			
No. of stories:	☐ Public	Depth W	idth ☐ Public ☐ Private ~	
Gross area, sq. ft./floor:	☑ Private	2 nd floor:	Sewage Disposal	
	Sewage Dispo	basement.	Public	
Area of construction (sq. ft.):	☐ Public☐ Private☐	☐ Finished Basement ☐ Unfinished Basement	☐ Private Electric: ☐ Yes ☐ No	
Use group:	Electric: \(\sigma\) Yes	□ No □ Crawl Space	Gas: Yes No	
Ose group.	Gas: Yes	□ No □ Slab on Grade	<u>Heating System</u>	
Construction type:	Heating Syst	No. of Bedrooms:	□ Electric	
☑ Reinforced Concrete	☐ Electric ☐ Oil	Multi-family Dwelling No. of efficiency units:	[☐ Oil ☐ Natural Gas	
☐ Structural Steel		ppane Gas No. of 1 BR units:	☐ Propane Gas	
☐ Masonry	Sprinkler Syst			
☐ Wood Frame	□ N/A	No. of 3 BR units:		
☐ State Certified Modular	☐ Full	Other Structure: Dimensions:		
Roadside Tree Project Per		Footings:	> Roadside Tree Project Peri	mit
□Yes ☑No	Other Suppression	Roof:	□Yes □No	
Roadside Tree Project Perm	it # No. of Heads:	☐ State Certified Modular ☐ Manufactured Home	Roadside Tree Project Permit	#
WITH ALL REGULATIONS OF HOWARD CO THIS APPLICATION; (5) THAT HE/SHE GRA Applicant's Signature	DUNTY WHICH ARE APPLICABLE THERETO	E IS AUTHORIZED TO MAKE THIS APPLICATION; (2) THAT THE INI; (4) THAT HE/SHE WILL PERFORM NO WORK ON THE ABOVE IS TER ONTO THIS PROPERTY FOR THE PURPOSE OF INSPECTING TI	REFERENCED PROPERTY NOT SPECIFICALLY DESCRIBE HE WORK PERMITTED AND POSTING NOTICES.	MPLY ED IN
, company	Checks Payable	to: DIRECTOR OF FINANCE OF HOWARD COUNTY		
		PLEASE WRITE NEATLY & LEGIBLY** -FOR OFFICE USE ONLY-		
AGENCY DAT	SIGNATURE OF APPROVAL	DPZ SETBACK INFORMATION	Filing Fee \$	
State Highways	SIGNATORE OF AFFROVAL	Front:	Permit Fee \$	-
Building Officials			Tech Fee \$	
PSZA (Zoning)		Rear:	Excise Tax \$	
,		i side:		

Is Sediment Control approval required for issuance? ☐ Yes ☐ No
☐ CONTINGENCY CONSTRUCTION START
☐ ONE STOP SHOP

10-24-16 Benerd


PSZA (Engineering)

Health

Front:		
Rear:		
Side:		
Side St.:		
All minimum setbacks met?	☐ Yes	□No
Is Entrance Permit Required?	☐ Yes	□No
Historic District?	☐ Yes	□No
Lot Coverage for New Town Z	one:	
SDP/Red-line approval date:		

riiing ree	· ·
Permit Fee	\$
Tech Fee	\$
Excise Tax	\$
PSFS	\$
Guaranty Fund	\$
Add'l per Fee	\$
Total Fees	\$
Sub- Total Paid	\$
Balance Due	\$

/=60 APPROVED

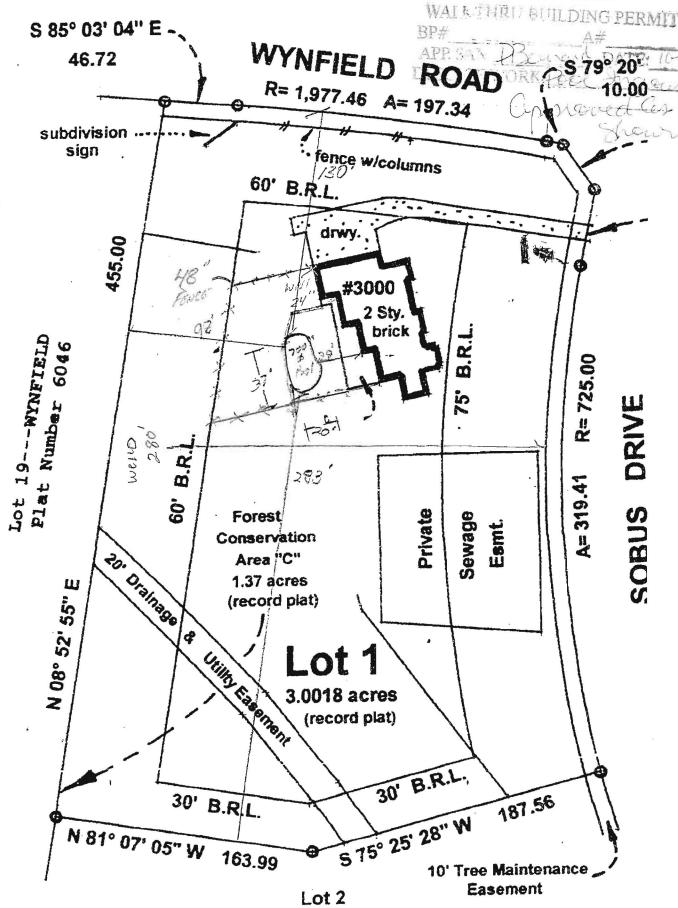

NOTE: Easements & Conservation Area shown as scaled from record plat