

Building Permit Application
Howard County Maryland
Department of Inspections, Licenses and Permits
3430 Court House Drive
Permits: 410-313-2455 www.howardcountymd.gov

Date Received:	

Permit No.:

Building Address:	trans 11846 Simpson Rd	Property Owner's Name: OMAR 64	AYDJAR!	
City: clarksville State:	4	Address: 11846 SIMPSON Rd		
		Phone: 410-804-2067 Fa		
Suite/Apt. #SDP/ Census Tract:	Subdivision Eastern VICE	Email:	A	
			1	
Section: Area	:Lot:	Applicant's Name & Mailing Address, (If ot	ner than stated herein)	
Tax Map: 4 Parcel:		Applicant's Name: Seemy Cla Address: PO BOX 310	1100	
Zoning: Map Coordinat	es:Lot Size: 42,970	City: Pory Hall State: ME	Zip Code: 21125	
		Phone: 443-340-1229 Fax: Email: <u>Jeremy @ Appliedla</u>	not A on Frite of Joins	
Existing Use: S40				
Proposed Use: SOD cal Pos	<u></u>	Contractor Company: Custom (works	
Estimated Construction Cost: \$ 508		Contact Person: Green wilson		
Description of Work:		Address: PO GOX 175		
const 8×12 Roof a	inver over ex	City: RIVA State: MD Zip Code: 21140 License No.: 91395		
Basement Steps		Phone: 410-963-1119 Fax:		
·		Email:		
Occupant or Tenant:				
Was tenant space previously occupied?	□Yes □No	Engineer/Architect Company:		
Contact Name:	· ·	Responsible Design Prof.:		
Address:		Address: <u>Contractor</u>		
City:	State:Zip Code:	City:State:	Zip Code:	
Phone:	Fax:	Phone: Fax:		
Email:		Email:		
		Cilian.		
Commercial Building Characteristics	Residential Building Characteristics	Utilities		
Height:	SF Dwelling SF Townhouse	<u>Water Supply</u>		
No. of stories: Gross area, sq. ft./floor:	<u>Depth</u> <u>Width</u> 1 st floor:	☐ Public		
	2 nd floor:	☐ Private		
Area of construction (sq. ft.):	Basement:	Sewage Disposal		
	☐ Finished Basement	☐ Public		
Use group:	☐ Unfinished Basement	☐ Private		
	☐ Crawl Space	Electric: ☐ Yes ☑ No		
Construction type:	☐ Slab on Grade	Gas: ☐ Yes ☐ No		
Reinforced Concrete	No. of Bedrooms: Multi-family Dwelling	Heating System		
Structural Steel		☐ Electric ☐ Oil		
· □ Masonry □ Wood Frame	No. of efficiency units: No. of 1 BR units:			
☐ State Certified Modular	No. of 2 BR units:			
State Certified Wooddar	No. of 3 BR units:	Other:		
	Other Structure:	<u>Sprinkler System:</u>	SALES LIE LEVEL	
	Dimensions:	□Yes □No		
> Roadside Tree Project Permit	Footings:			
□Yes □No	Roof:	Grading Permit Number:	Control of Street Street or Street St	
Roadside Tree Project Permit #	State Certified Modular			
Rodusiae (ree rroject remit #	☐ Manufactured Home	Building Shell Permit Number:	 	
	El Mandiactarea Home	building Shear Crant Number.		
WITH ALL REGULATIONS OF HOWARD COUNTY OF THIS APPLICATION; (5) LIHAT HEYSHEIGRANTS COL	WHICH ARE APPLICABLE THERETO; (4) THAT HE/SHE W UNTY OFFICIALS THE RIGHT TO ENTER ONTO THIS PROP Pr (Ancil App rocel, com	MAKE THIS APPLICATION; (2) THAT THE INFORMATION IS C VILL PERFORM NO WORK ON THE ABOVE REFERENCED PROPERTY FOR THE PURPOSE OF INSPECTING THE WORK PERMIT VINTEN Name 10 2	OPERTY NOT SPECIFICALLY DESCRIBED IN	
	Checks Payable to: DIRECTOR OF F	FINANCE OF HOWARD COUNTY		
	**PLEASE WRITE NE		· · · · · · · · · · · · · · · · · · ·	

-FOR OFFICE USE ONLY-

AGENCY	DATE	SIGNATURE OF APPROVAL
State Highways		
Building Officials		
PSZA (Zoning)		
PSZA (Engineering)		
Health (1/4/16	DRiela.

DPZ SETBACK INFORMATION		
Front:		
Rear:		
Side:		
Side St.:		
All minimum setbacks met?	☐ Yes	□No
Is Entrance Permit Required?	☐ Yes	□No
Historic District?	☐ Yes	□No
Lot Coverage for New Town Z	one:	
SDP/Red-line approval date:		

Filing Fee	\$
Permit Fee	\$
Tech Fee	\$
Excise Tax	\$
PSFS	\$
Guaranty Fund	\$
Add'l per Fee	\$
Total Fees	\$
Sub- Total Paid	\$.
Balance Due	\$
Check	# .


White: Building Officials

Green: PSZA,Zoning

Yellow: PSZA, Engineering


Pink: Health

Gold: SHA

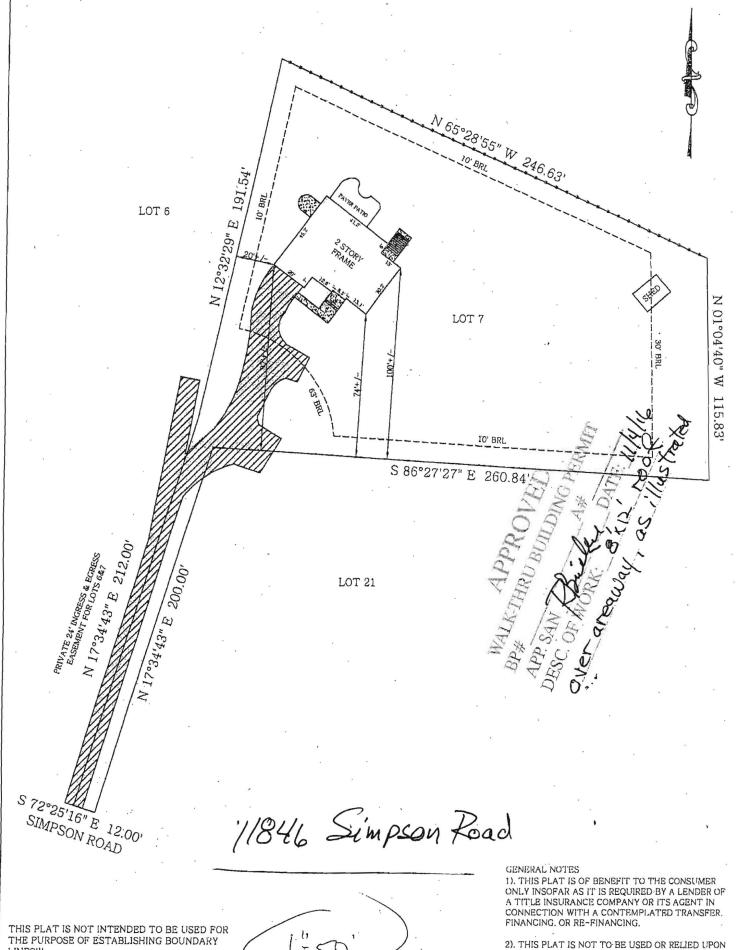

LINES!!!

THIS SURVEY WAS PREPARED WITHOUT BENEFIT OF A TITLE REPORT.

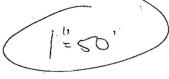

FOR THE ESTABLISHMENT OR LOCATION OF FENCES, GARAGES, BUILDINGS, OR ANY OTHER FUTURE IMPROVEMENTS.

3). THIS PLAT DOES NOT PROVIDE FOR THE ACCURATE IDENTIFICATION OF PROPERTY