

APPLICATION

FOR PERCOLATION TESTING AND SITE EVALUATION

TEST DATE(S) _____ TEST TIME _____ A/P _____

AGENCY REVIEW: _____ DATE _____

DO NOT WRITE ABOVE THIS LINE

I HEREBY APPLY FOR THE NECESSARY TESTING/EVALUATION PRIOR TO ISSUANCE OF SEWAGE DISPOSAL SYSTEM PERMIT(S) TO:

CHECK AS NEEDED:

- ☐ CONSTRUCT NEW SEPTIC SYSTEM(S)
- ☐ REPAIR/ADD TO AN EXISTING SEPTIC SYSTEM
- ☐ REPLACE AN EXISTING SEPTIC SYSTEM

CHECK AS NEEDED:

- ☐ NEW STRUCTURE(S)
- ☐ ADDITION TO AN EXISTING STRUCTURE
- ☐ REPLACE AN EXISTING STRUCTURE

CHECK ONE:

- ☐ CREATE NEW LOT(S)
- ☐ BUILD ON AN EXISTING LOT IN A SUBDIVISION
- ☐ BUILD ON AN EXISTING PARCEL OF RECORD

IS THE PROPERTY WITHIN 2500' OF ANY RESERVOIR?

- ☐ YES
- ☐ NO

THE TYPE OF STRUCTURE IS:

- ☐ RESIDENTIAL WITH _____ PROPOSED BEDROOMS IN THE COMPLETED STRUCTURE (NOTE **UNKNOWN** IF APPROPRIATE)
- ☐ COMMERCIAL (PROVIDE DETAIL OF NUMBERS AND TYPES OF EMPLOYEES/ CUSTOMERS ON ACCOMPANYING PLAN)
- ☐ INSTITUTIONAL/GOVERNMENT (PROVIDE DETAIL OF NUMBERS AND TYPES OF EMPLOYEES/USERS ON ACCOMPANYING PLAN)

PROPERTY OWNER(S) _____

DAYTIME PHONE _____ CELL _____ FAX _____

MAILING ADDRESS _____
STREET CITY/TOWN STATE ZIP

APPLICANT _____

DAYTIME PHONE _____ CELL _____ FAX _____

MAILING ADDRESS _____
STREET CITY/TOWN STATE ZIP

APPLICANT'S ROLE: DEVELOPER BUILDER BUYER RELATIVE/FRIEND REALTOR CONSULTANT

PROPERTY LOCATION
SUBDIVISION/PROPERTY NAME _____ LOT NO. _____

PROPERTY ADDRESS _____
STREET TOWN/POST OFFICE

TAX MAP PAGE(S) _____ GRID _____ PARCEL(S) _____ PROPOSED LOT SIZE _____

AS APPLICANT, I UNDERSTAND THE FOLLOWING: THE SYSTEM INSTALLED SUBSEQUENT TO THIS APPLICATION IS ACCEPTABLE ONLY UNTIL PUBLIC SEWERAGE IS AVAILABLE. THIS APPLICATION IS COMPLETE WHEN ALL APPLICABLE FEES AND A SUITABLE SITE PLAN HAVE BEEN RECEIVED. I ACCEPT THE RESPONSIBILITY FOR COMPLIANCE WITH ALL M.O.S.H.A. AND "MISS UTILITY" REQUIREMENTS. APPROVAL IS BASED UPON SATISFACTORY REVIEW OF A PERC CERTIFICATION PLAN.


TEST RESULTS WILL BE MAILED TO APPLICANT.

SIGNATURE OF APPLICANT

HOWARD COUNTY HEALTH DEPARTMENT, BUREAU OF ENVIRONMENTAL HEALTH, WELL AND SEPTIC PROGRAM
7178 COLUMBIA GATEWAY DRIVE COLUMBIA, MARYLAND 21046 (410) 313-2640 FAX (410) 313-2648
TDD (410) 313-2323 TOLL FREE 1-877-4MD-DHMH

A/P

1 Yellow Brn FSL - 2 gravel
 Yellow Brn FSL
 2 Brn - Grey Brn LS
 5 Few mica flakes
 6 Brn Lg (F) dec. sopr WK ~10%
 7 Hardish Brn Sopr. sandstone Auger can't penetrate backhoe would dig

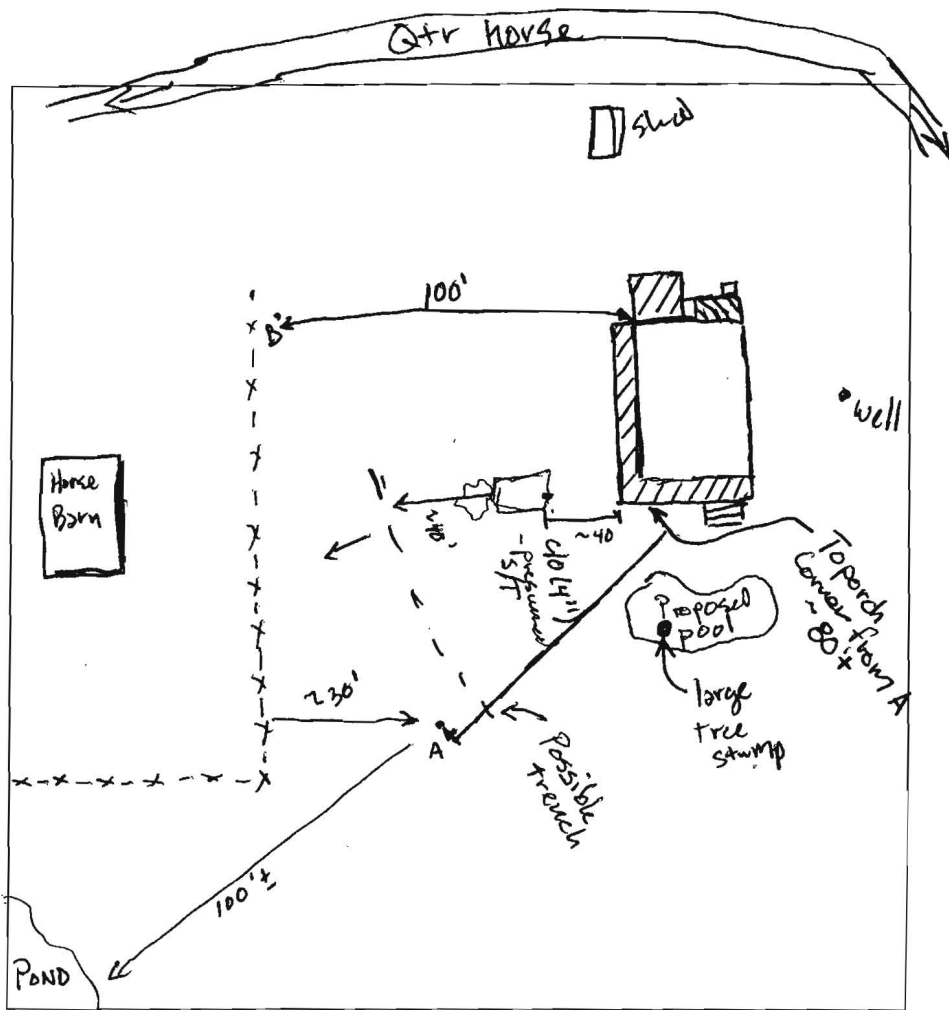

8 See (A) to 7'
 7' Brn Hardish clw sandstone
 7 1/2 Brn/whit LS
 8 1/2 Yellow LS/Brn LS
 9


DATE	TEST #	DEPTH	START	BREAK 1" DROP	STOP 2" DROP	TIME OF 2ND INCH	P/F/H
10/2/07	A	7'	2' of sw available w/ 1 ft inlet			<5m	P
	B	9'	4' of sidewalk w/ 1 ft inlet			<5m	P

REMARKS

SANITARIAN BACKHOE OTHERS

TEST HOLES USED IN SDA AVG. PERC TIME SQ. FT/BR

TRENCH WIDTH INLET DEPTH MAX. BOT DEPTH EFFECTIVE SW

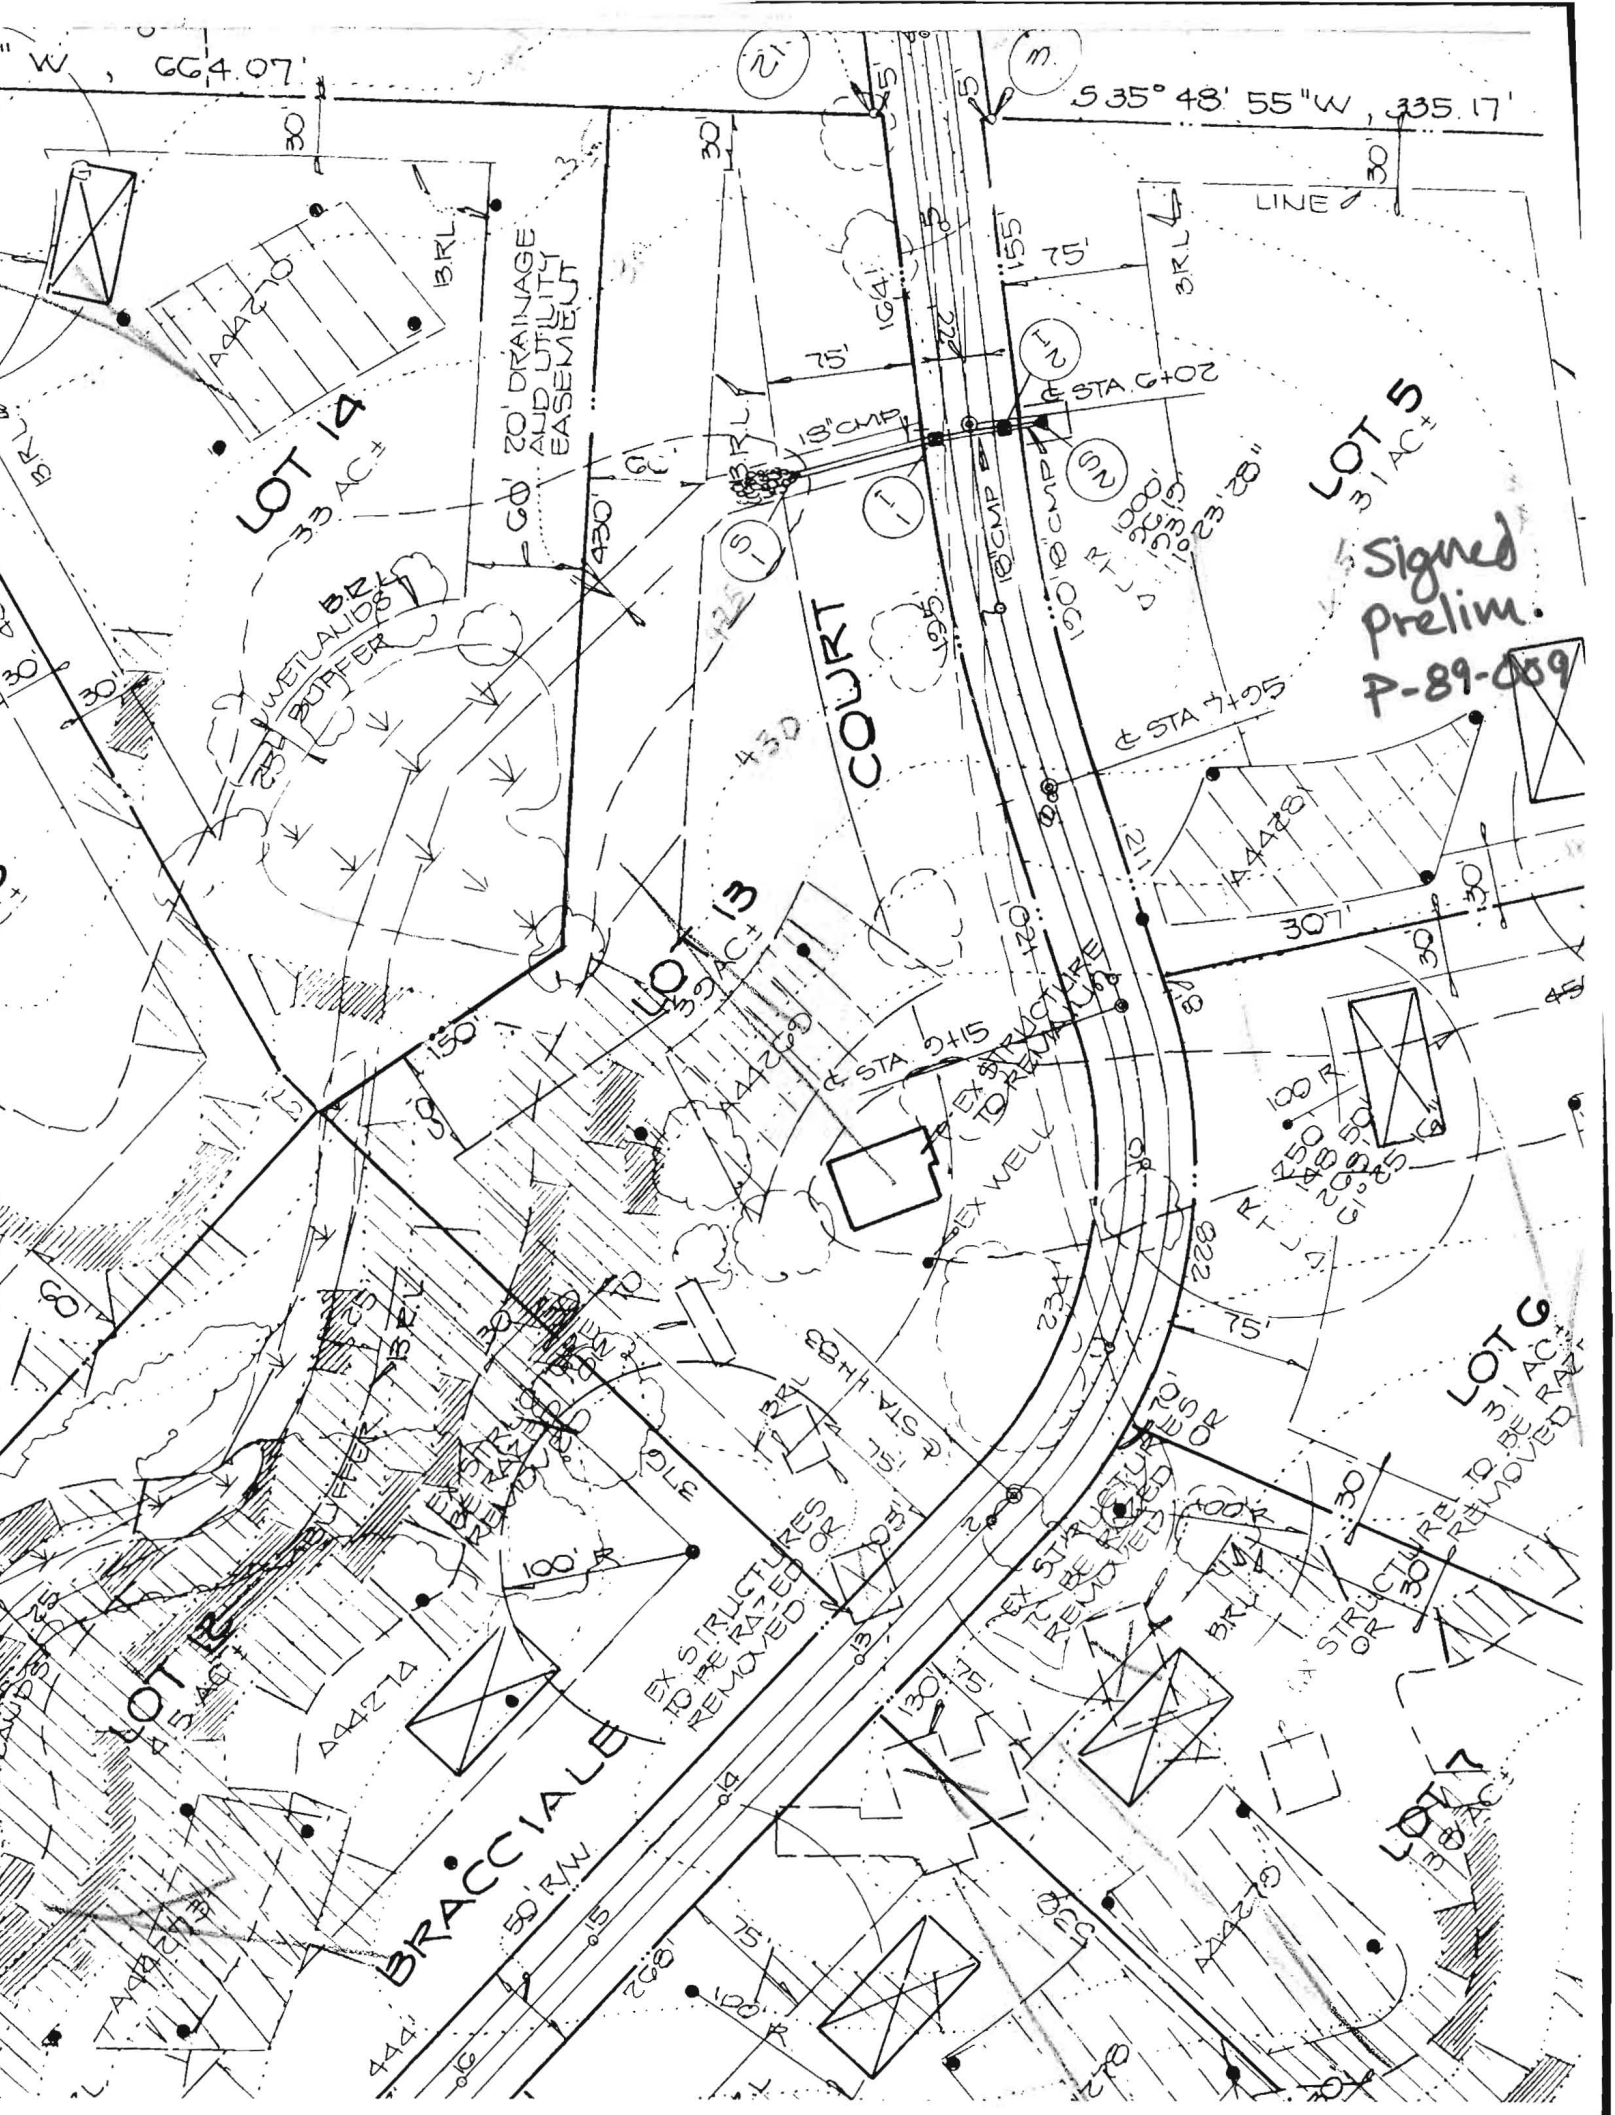

W, 664.07'

S 35° 48' 55" W, 335.17'

LOT 14
3.3 AC

LOT 5
3.1 AC

Signed
Prelim.
P-89-009

COURT

LOT 13
3.9 AC

LOT 6
3.1 AC

LOT 7
3.8 AC

BRACCIALE
50' RW

LOT 12
5.4 AC

EX STRUCTURES
TO BE RAISED OR
REMOVED

EX STRUCTURE
TO BE REMOVED

STRUCTURE
OR
TO BE REMOVED

25' WETLAND BUFFER

60' 20' DRAINAGE
AND UTILITY
EASEMENT

EX WELL
(EX STRUCTURE
TO BE REMOVED)

EX STA. 7+95

EX STA. 9+15

STA. 6+02

STA. 7+95

STA. 7+95

STA. 9+15

PERCOLATION CERTIFICATION PLAN

Owner: Brian & Libby Kahat 1806 Quarter Horse Drive Woodstock MD 21163 410-480-5282
Prepared by : Mike Beavan, Custom Home Pools Inc. 3020 Sobus Dr .410-489-9890

SCALE 1" = 100'

Septic field 10,500 SF

Abandon 1800SF, new area 1800S.F.

Legend


Orig Area 

New Area 

Abandon area 

Perc Test 

Auger Test 

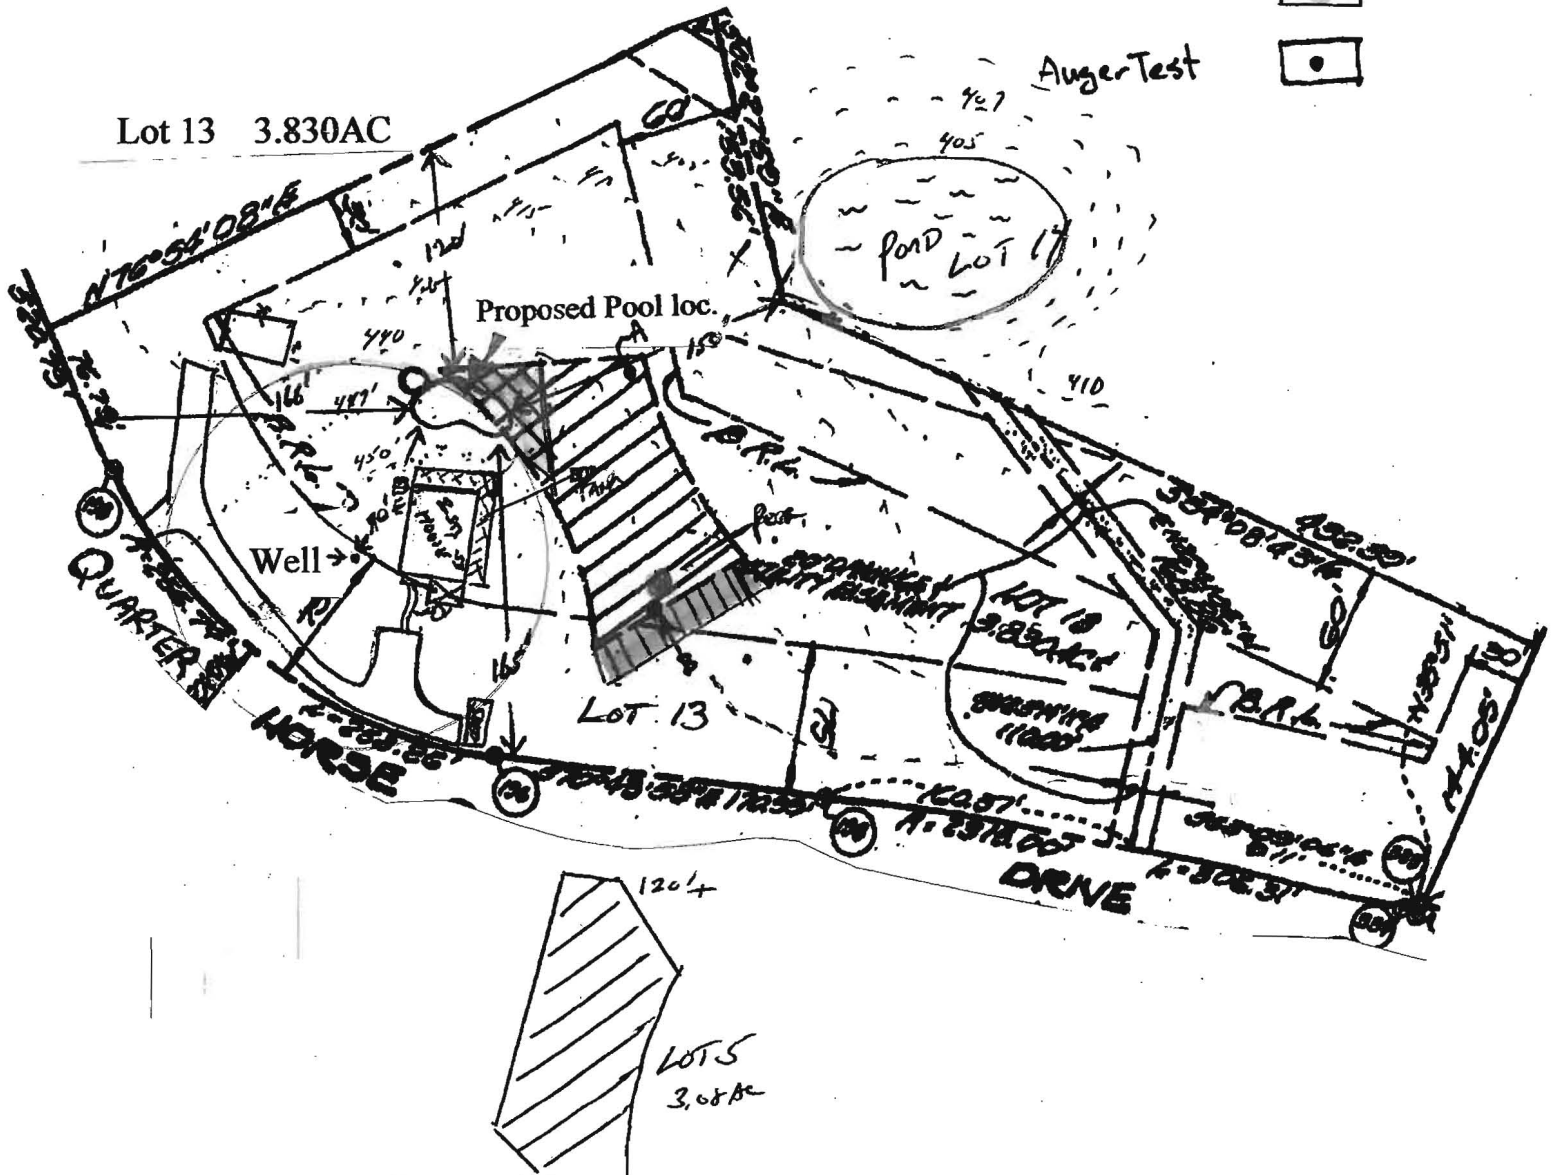

MDE SEWAGE EASEMENT STATEMENTS

This area designates a private sewage easement of at least 10,000 square feet as required by MD Dept of Environment for individual sewage disposal. Improvements of any nature in this area are restricted. Easement to become null and void upon public sewage connection.

The county health officer shall have authority to grant adjustments to private sewage easement. Recordation of a revised sewage easement shall not be necessary.

"THE LOT SHOWN HERON COMPLIES WITH MINIMUM OWNERSHIP WIDTH AND LOT AREAS AS REQUIRED BY THE MARYLAND DEPARTMENT OF ENVIRONMENT".

Any changes to a private sewage easement shall require a revised percolation certification plan".

CERTIFICATION

I certify that the information shown heron is based on field work performed by me and Land surveys performed by Fisher, Collins, and is correct, to the best of my knowledge and belief. All reasonable efforts to locate surrounding wells and septic systems are noted.

Signature of Preparer

Date 9-27-07

Signature of Homeowner

Date 9/27/07

"APPROVED FOR PRIVATE WATER AND PRIVATE SEWAGE SYSTEMS".

HEALTH OFFICER Signature *B. Nye for Peter Beilman* Date 10/19/2007

GAC 10/19/07