

APPLICATION

PERCOLATION TESTING

A NO FEE

P _____

DISTRICT _____

DATE 5/31/02

HOWARD COUNTY HEALTH DEPARTMENT

BUREAU OF ENVIRONMENTAL HEALTH

3525-H ELLICOTT MILLS DRIVE/ELLICOTT CITY, MARYLAND 21043
TELEPHONE: 313-2640

TO: THE COUNTY HEALTH OFFICER
ELLICOTT CITY, MARYLAND

I HEREBY APPLY FOR THE NECESSARY TEST PRIOR TO APPLICATION FOR PERMIT TO CONSTRUCT (OR RECONSTRUCT) A SEWAGE DISPOSAL SYSTEM.

PROPERTY OWNER _____

ADDRESS _____ PHONE _____

AGENT OR PROSPECTIVE BUYER _____

ADDRESS _____ PHONE _____

PROPERTY LOCATION:

SUBDIVISION Buice Property, Sec 1. LOT NO. 75

ROAD AND DESCRIPTION _____

TAX MAP _____ PARCEL # _____

SIZE OF LOT _____ TYPE BLDG. _____
(SINGLE FAMILY DWELLING OR COMMERCIAL)

THE SYSTEM INSTALLED UNDER THIS APPLICATION IS ACCEPTABLE ONLY UNTIL PUBLIC FACILITIES BECOME AVAILABLE. I FULLY UNDERSTAND THE
FEE CONNECTED WITH THE FILING OF THIS PERC TEST APPLICATION IS NON-REFUNDABLE UNDER ANY CIRCUMSTANCES. I ALSO AGREE TO
COMPLY WITH ALL M.O.S.H.A. REQUIREMENTS IN TESTING THIS LOT. _____
(SIGNATURE OF APPLICANT)

APPROVED BY _____ FOR _____ DATE _____

DISAPPROVED BY _____ FOR _____ DATE _____

HOLD PENDING FURTHER TESTS _____

REASONS FOR REJECTION OR HOLDING _____

PERCOLATION TEST PLAT/PRELIMINARY PLAT - TITLE OR I.D. # _____ DATE _____

SITE DEVELOPMENT PLAN/FINAL PLAT - TITLE OR I.D. # _____ DATE _____

THIS IS NOT A PERMIT

SQ. FT./BEDROOM

SQ. FT./BEDROOM

APPLICATION

PERCOLATION TESTING

A NO FEE

P _____

HOWARD COUNTY HEALTH DEPARTMENT

BUREAU OF ENVIRONMENTAL HEALTH

3525-H ELLICOTT MILLS DRIVE/ELLICOTT CITY, MARYLAND 21043

TELEPHONE: 313-2640

DISTRICT _____

DATE 10/3/01

TO: THE COUNTY HEALTH OFFICER
ELLICOTT CITY, MARYLAND

I HEREBY APPLY FOR THE NECESSARY TEST PRIOR TO APPLICATION FOR PERMIT TO CONSTRUCT (OR RECONSTRUCT) A SEWAGE DISPOSAL SYSTEM.

PROPERTY OWNER _____

ADDRESS _____ PHONE _____

AGENT OR PROSPECTIVE BUYER _____

ADDRESS _____ PHONE _____

PROPERTY LOCATION:

SUBDIVISION Buice Property, Sec 1 LOT NO. 75

ROAD AND DESCRIPTION _____

TAX MAP _____ PARCEL # _____

SIZE OF LOT _____ TYPE BLDG. _____
(SINGLE FAMILY DWELLING OR COMMERCIAL)

THE SYSTEM INSTALLED UNDER THIS APPLICATION IS ACCEPTABLE ONLY UNTIL PUBLIC FACILITIES BECOME AVAILABLE. I FULLY UNDERSTAND THE FEE CONNECTED WITH THE FILING OF THIS PERC TEST APPLICATION IS NON-REFUNDABLE UNDER ANY CIRCUMSTANCES. I ALSO AGREE TO COMPLY WITH ALL M.O.S.H.A. REQUIREMENTS IN TESTING THIS LOT.

(SIGNATURE OF APPLICANT)

APPROVED BY _____ FOR _____ DATE _____

DISAPPROVED BY _____ FOR _____ DATE _____

HOLD PENDING FURTHER TESTS _____

REASONS FOR REJECTION OR HOLDING _____

PERCOLATION TEST PLAT/PRELIMINARY PLAT - TITLE OR I.D. # _____ DATE _____

SITE DEVELOPMENT PLAN/FINAL PLAT - TITLE OR I.D. # _____ DATE _____

THIS IS NOT A PERMIT

59935 J

COUNTY #

SOIL PROFILE

529

beige
orange
clay
loam

4.0'

tan
sandy
clay
loam
10-15%
rock
frags
at 9.0'

11.0'

531

brown
orange
clay
loam

4.0'

beige
orange
sandy
clay
loam
20%
rock
frags

12.0'


528

orange
beige
clay
loam

3.5'

beige
sandy
clay
loam
30%
rock
frags

10.5'

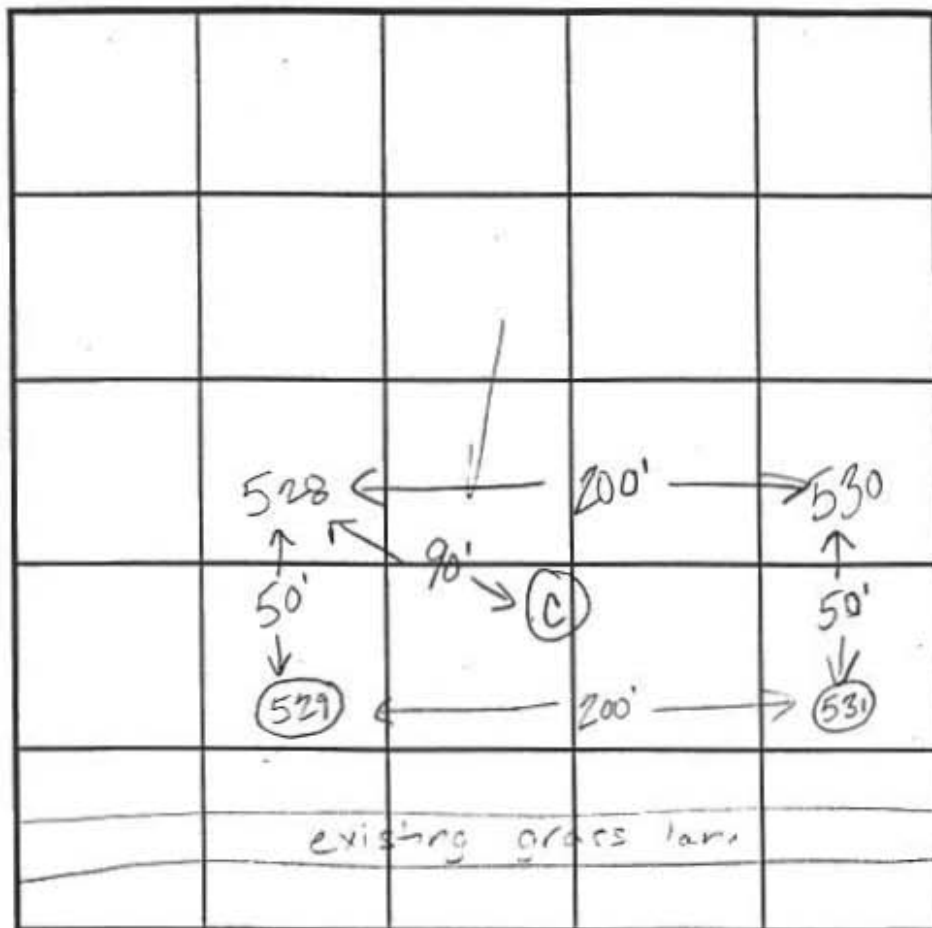

INDICATE NORTH - NAME ADJOINING ROADWAY AS BASE LINE.

SOIL PROFILE

530

beige
orange
clay
lm

3.0'

beige
sandy
clay
loam
15%
rock
frags

11.0'

C

orange
clay/lm

4.0'

orange
brown
sclm
15% rock
frags

11.0'

DATE	TEST NO.	DEPTH	PRE-WET START	PRE-WET STOP	TEST - 1" DROP START	TEST - 1" DROP STOP	TIME
6-18-98	529	4.0'S	10:58 ₃₀	10:59 ₃₀	10:59 ₃₀	11:02	230
		11.0'D	Visual	OK -	See profile		
	531	4.0'S	11:17 ₃₀	11:18 ₃₀	11:18 ₃₀	11:19 ₃₀	1min
		12.0'D	Visual	OK -	See profile		
	530	3.0'S	3:02 ₄₀	3:03 ₄₀	3:03 ₄₀	3:05 ₄₀	2min
		11.0'D	Visual	OK -	See profile		
	528	3.0'S	1:56 ₃₀	1:58	1:58	2:00 ₃₀	230
		10.5'S	1:48 ₃₀	1:49 ₃₀	1:49 ₃₀	1:51 ₃₀	2min
		10.5'D	Visual	OK -	See profile		
	C	11.0'D	Visual	only - OK	See profile		

REMARKS

test holes staked by Surveyor

TYPE OF SOIL

Glencly Manor

TESTED BY

Kim Maiste

ALSO PRESENT

Mike

TRENCH DESIGN DATA: AVERAGE PERCOLATION TIME

2 minutes

TRENCH WIDTH

3.0

INLET DEPTH

3.0

MAXIMUM BOTTOM DEPTH

5.0


SQ. FT./BEDROOM

180

MATCH LINE

SIGNED PERC CERT
10/28/02

OFF SHEET 2

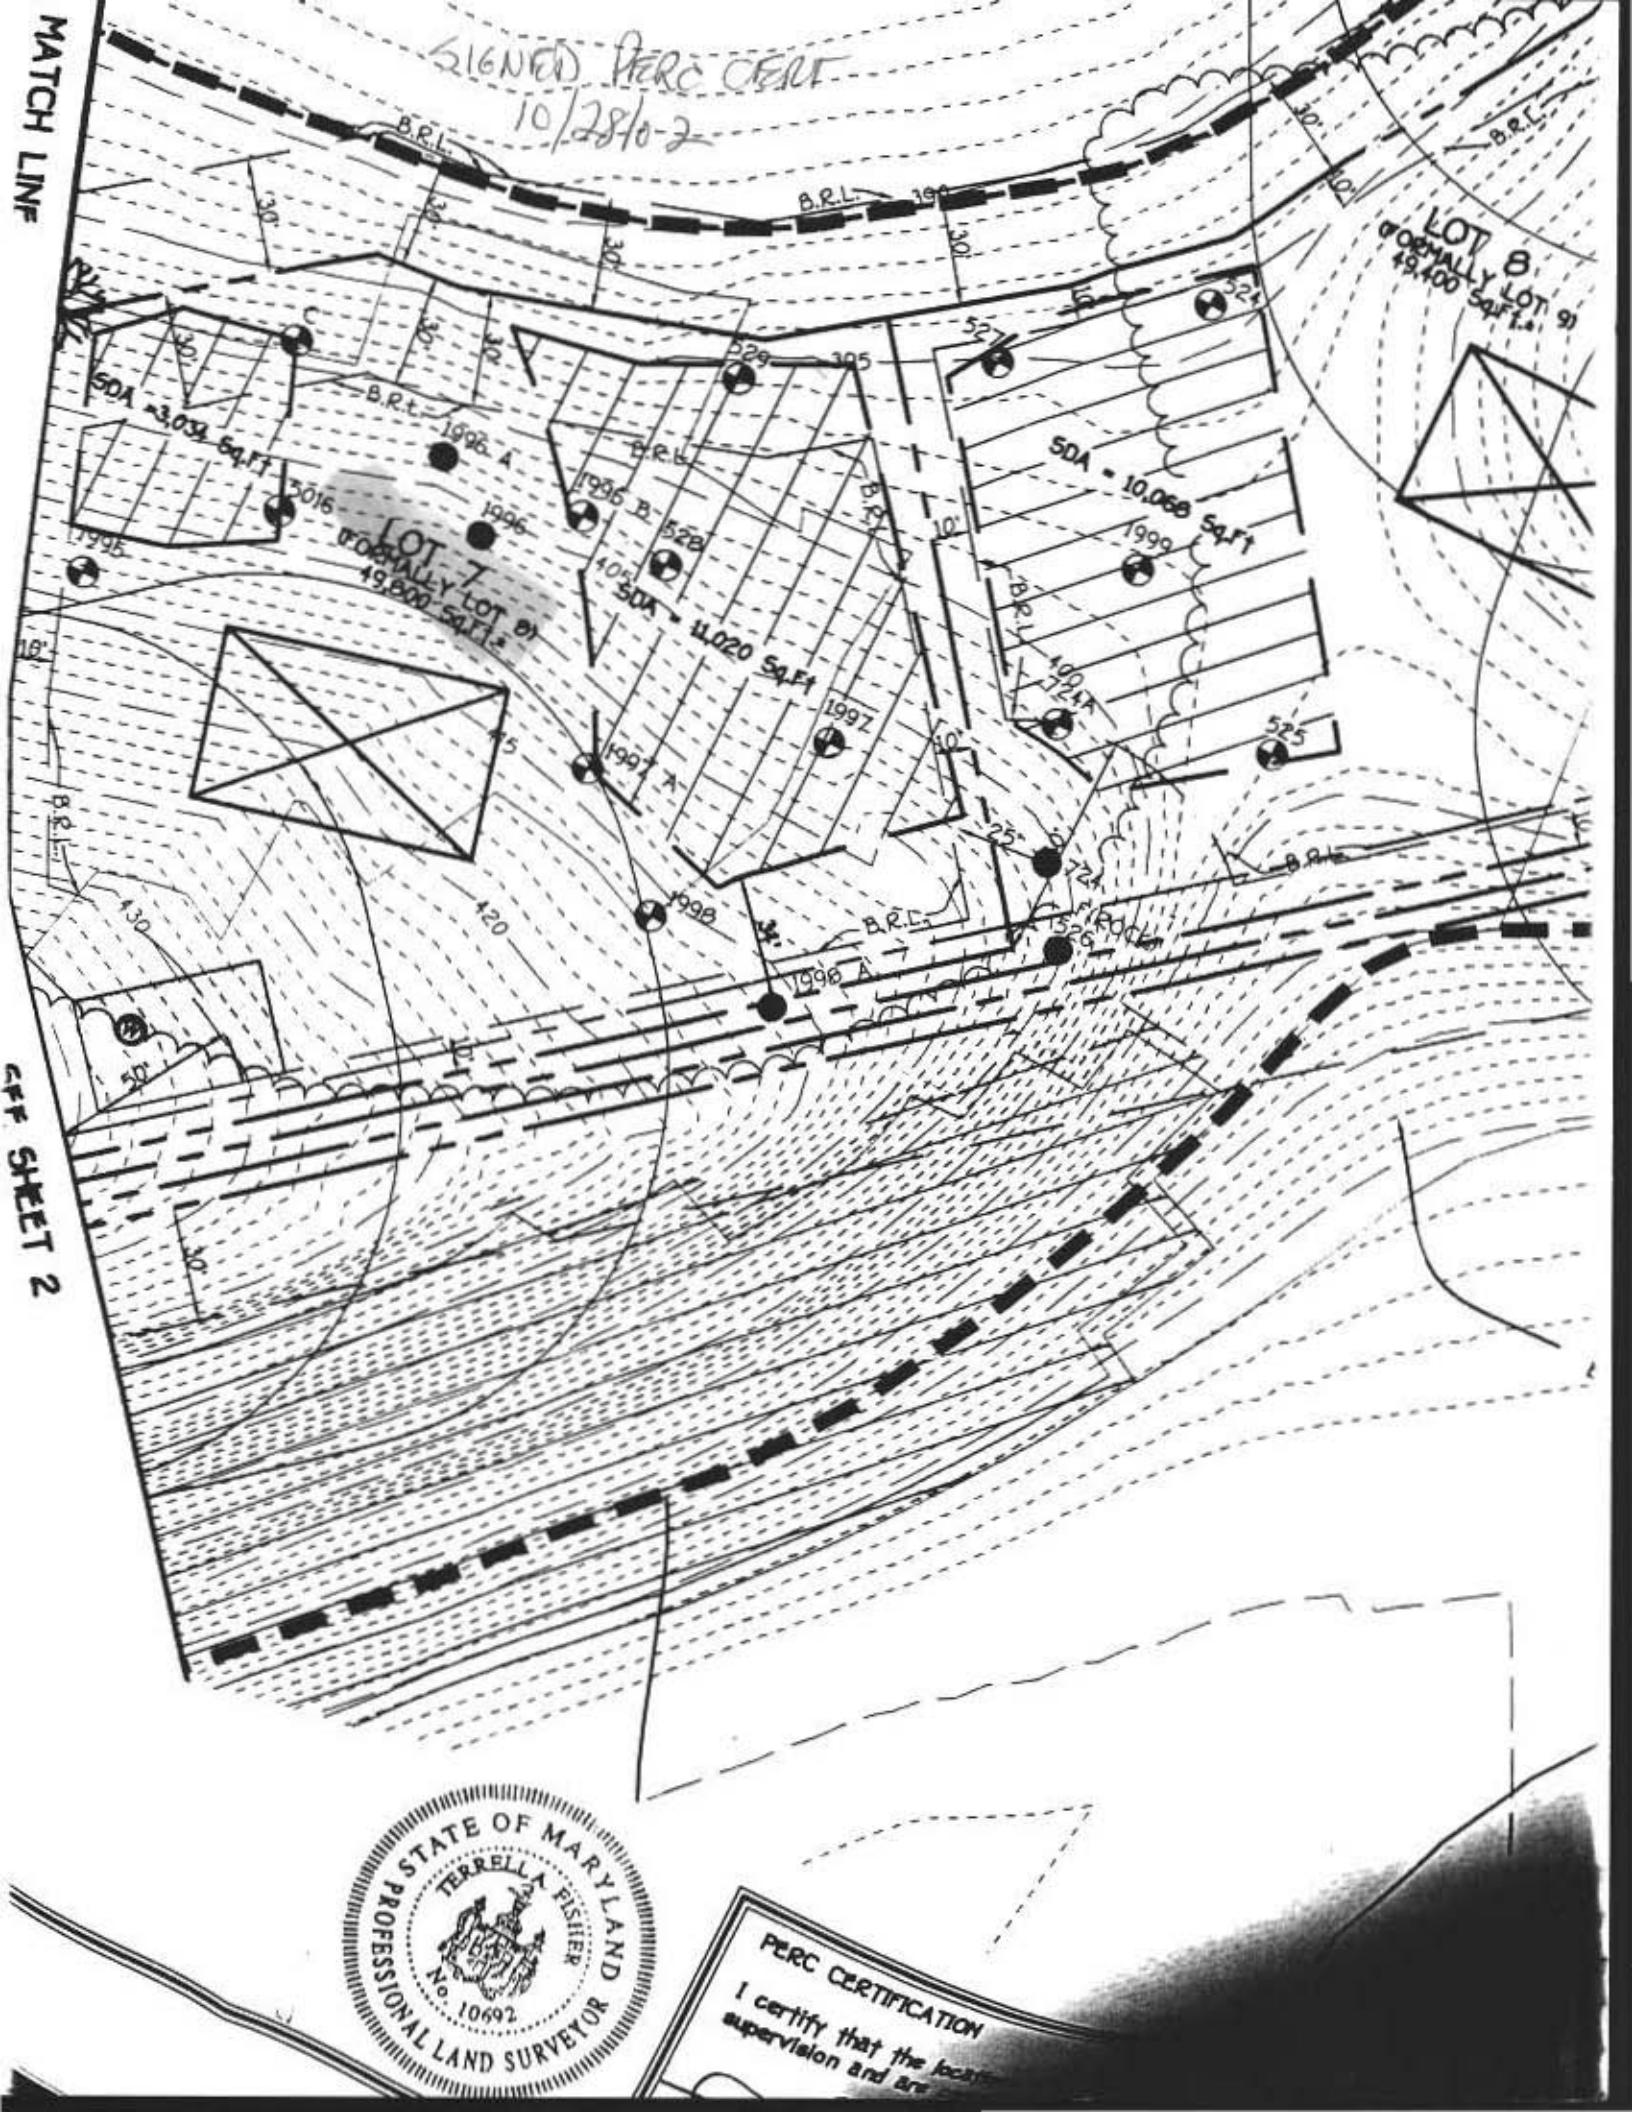

PERC CERTIFICATION
I certify that the location
supervision and are



Existing
Structure to
Remain

(P6)

40' SYCAMORE

LOT 7
19,028 sq ft

LOT 8
14,700 sq ft

LOT 5
19,500 sq ft

LOT 9
14,780 sq ft

COURT

Existing Woods

TROPICAL RESERVE
Labeled 75, 70130/200

WARRINGTON SUBURBAN SANITARY COMMISSION

(P3)

ZONING: RC-DEO

TENTATIVELY APPROVED
DEPT. OF PLANNING AND

P-02-020
SIGNED 4/28/03

Existing Woods

Lot 87

Holes

5016 ✓ P

C ✓ P

529 ✓ P

528 ✓ P

~~528~~

1995 ✓ P

1996 ✓ F

1996 A ✓ F

1996 B ✓ P

1997 A ✓ P

1997 ✓ P

1998 ✓ P

1998 A F